

I hereby certify to
 Esso House Corporation
 The Secretary of Housing and Urban Development
 The State of Connecticut
 The City of Hartford
 and Commonwealth Land Title Insurance Company that this survey was
 actually made upon the ground and that it and the information,
 courses and distances shown thereon are correct; that the title
 lines and lines of actual possession are the same; that the size,
 location and type of buildings and improvements are as shown and
 are all within the boundary lines of the property and that there
 are no violations of zoning ordinance, restrictions or other
 rules and regulations with reference to the locations of said
 buildings and improvements; and that there are no encroachments,
 encroachments or uses affecting this property apparent from a
 careful physical inspection of the same other than those shown or
 depicted thereon.

To the Esso House Corporation
 The Secretary of Housing and Urban Development
 The State of Connecticut
 The City of Hartford
 and Commonwealth Land Title Insurance Company

I hereby certify that this survey was made as per record
 description and there are no apparent encroachments, and that
 this survey is substantially correct.



Carl H. Jaeger
 Carl H. Jaeger L.S. 7763



- NOTES**
- 1) THIS SURVEY HAS BEEN PREPARED IN ACCORDANCE WITH THE REGULATIONS OF CONNECTICUT STATE AGENCIES, SECTIONS 20-100-1 THROUGH 20-100-20, THE NINTH STANDARD FOR SURVEYS AND MAPS IN THE STATE OF CONN. ENDORSED BY THE CONNECTICUT ASSOCIATION OF LAND SURVEYORS, INC.
 - 2) THE BOUNDARY DETERMINATION CATEGORY IS A LOCATION IMPROVEMENT SURVEY BASED UPON THE REFERENCES NOTED HEREON.
 - 3) THIS PROPERTY SURVEY CONFORMS TO CLASS "A-2" HORIZONTAL ACCURACY.

TO MY KNOWLEDGE AND BELIEF, THIS SURVEY IS SUBSTANTIALLY CORRECT AS NOTED HEREON

CARL H. JAEGER L.S. 7763
 (THIS PLAN SHOULD NOT BE CONSIDERED VALID WITHOUT MY LIVE SIGNATURE AND EMBOSSED SEAL)

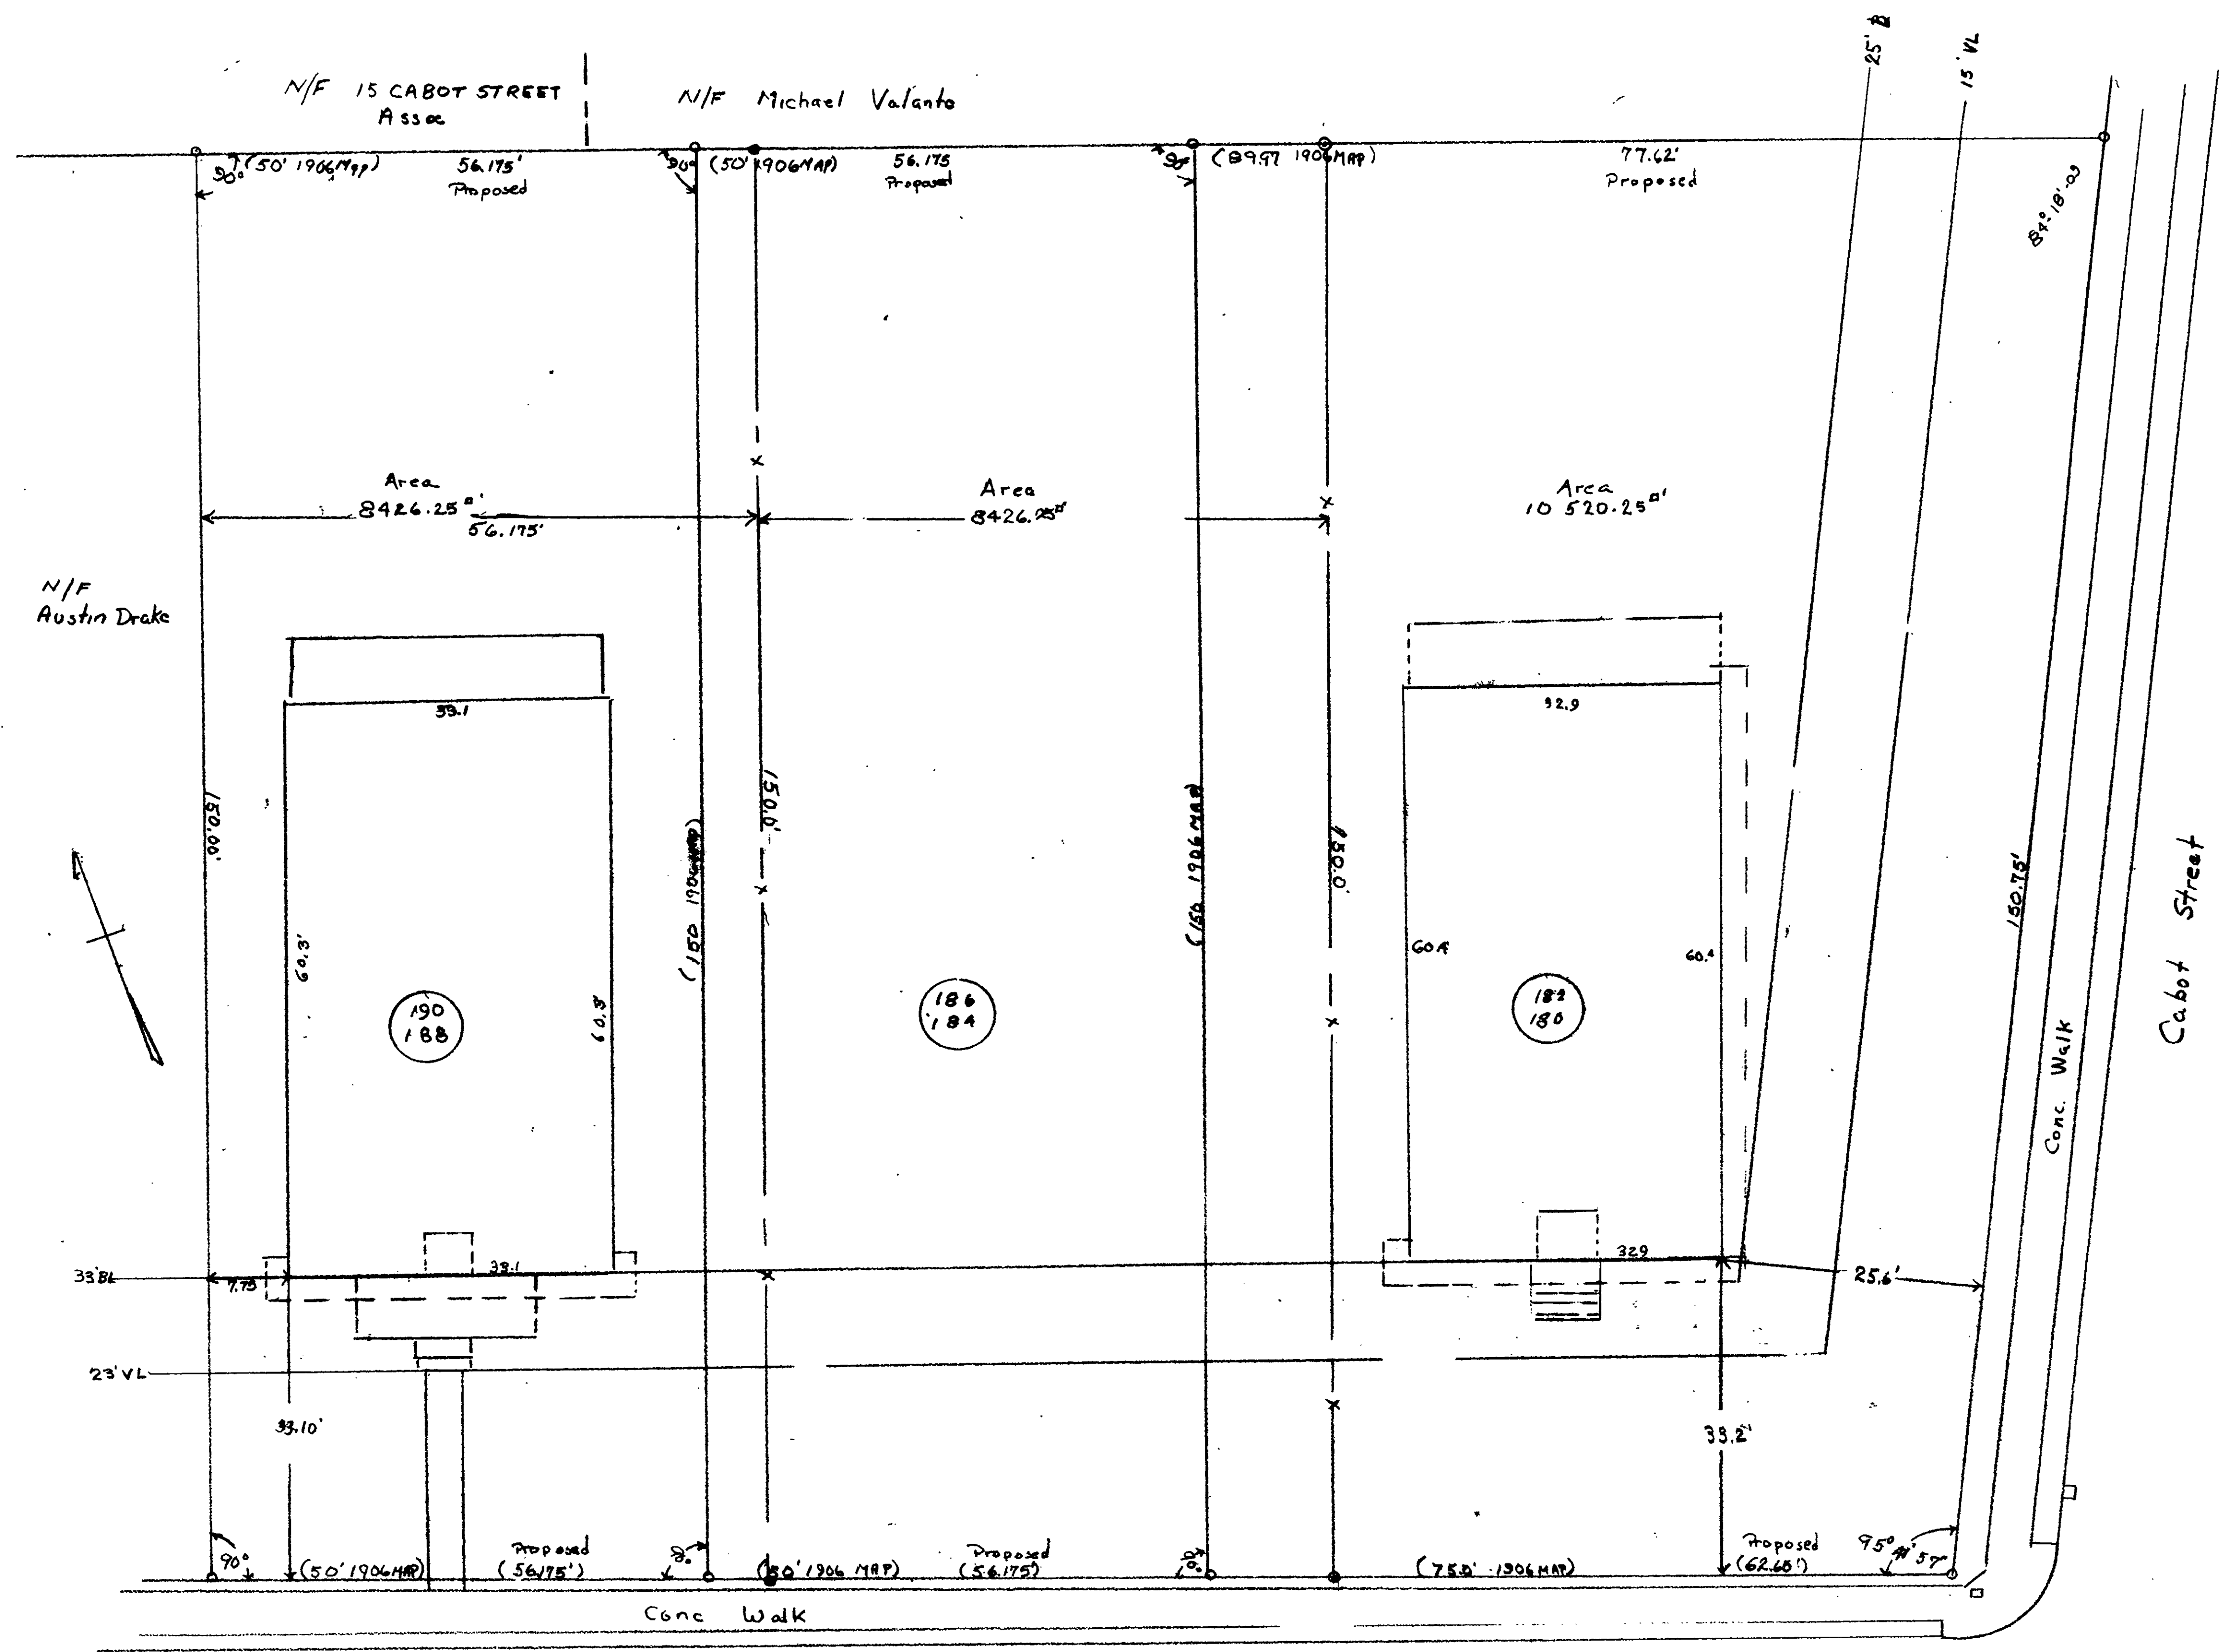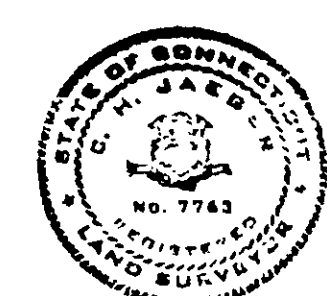

Notes
 1. Homestead Ave & Cabot St
 Proposed New Boundary Lines

CHJ
 1/4/199

PROPERTY OF The Regg House Corporation 180-182 Homestead Avenue 180-181 Homestead Avenue 180-190 Homestead Avenue TOWN OF Hartford CT	I HEREBY CERTIFY THAT THIS MAP & SURVEY WERE PREPARED IN ACCORDANCE WITH THE STANDARDS OF CLASS A2 SURVEY AS DEFINED IN THE CODE OF PRACTICE FOR STANDARDS AND ACCURACY OF SURVEY & MAPS ADOPTED DECEMBER 10, 1975 AS AMENDED BY THE CONN. ASSOCIATION OF LAND SURVEYORS, INC.	ALCA SURVEY ASSOCIATES CARL H. JAEGER L.S. 7763 WETHERSFIELD, CONN. Carl H. Jaeger SCALE: 1" = 12' SHEET 1 OF 1 DATE: 5/27/199
--	---	---

Re: Homestead Park Subdivision
 Scale 1"=100' June 1906