


2376

#2376

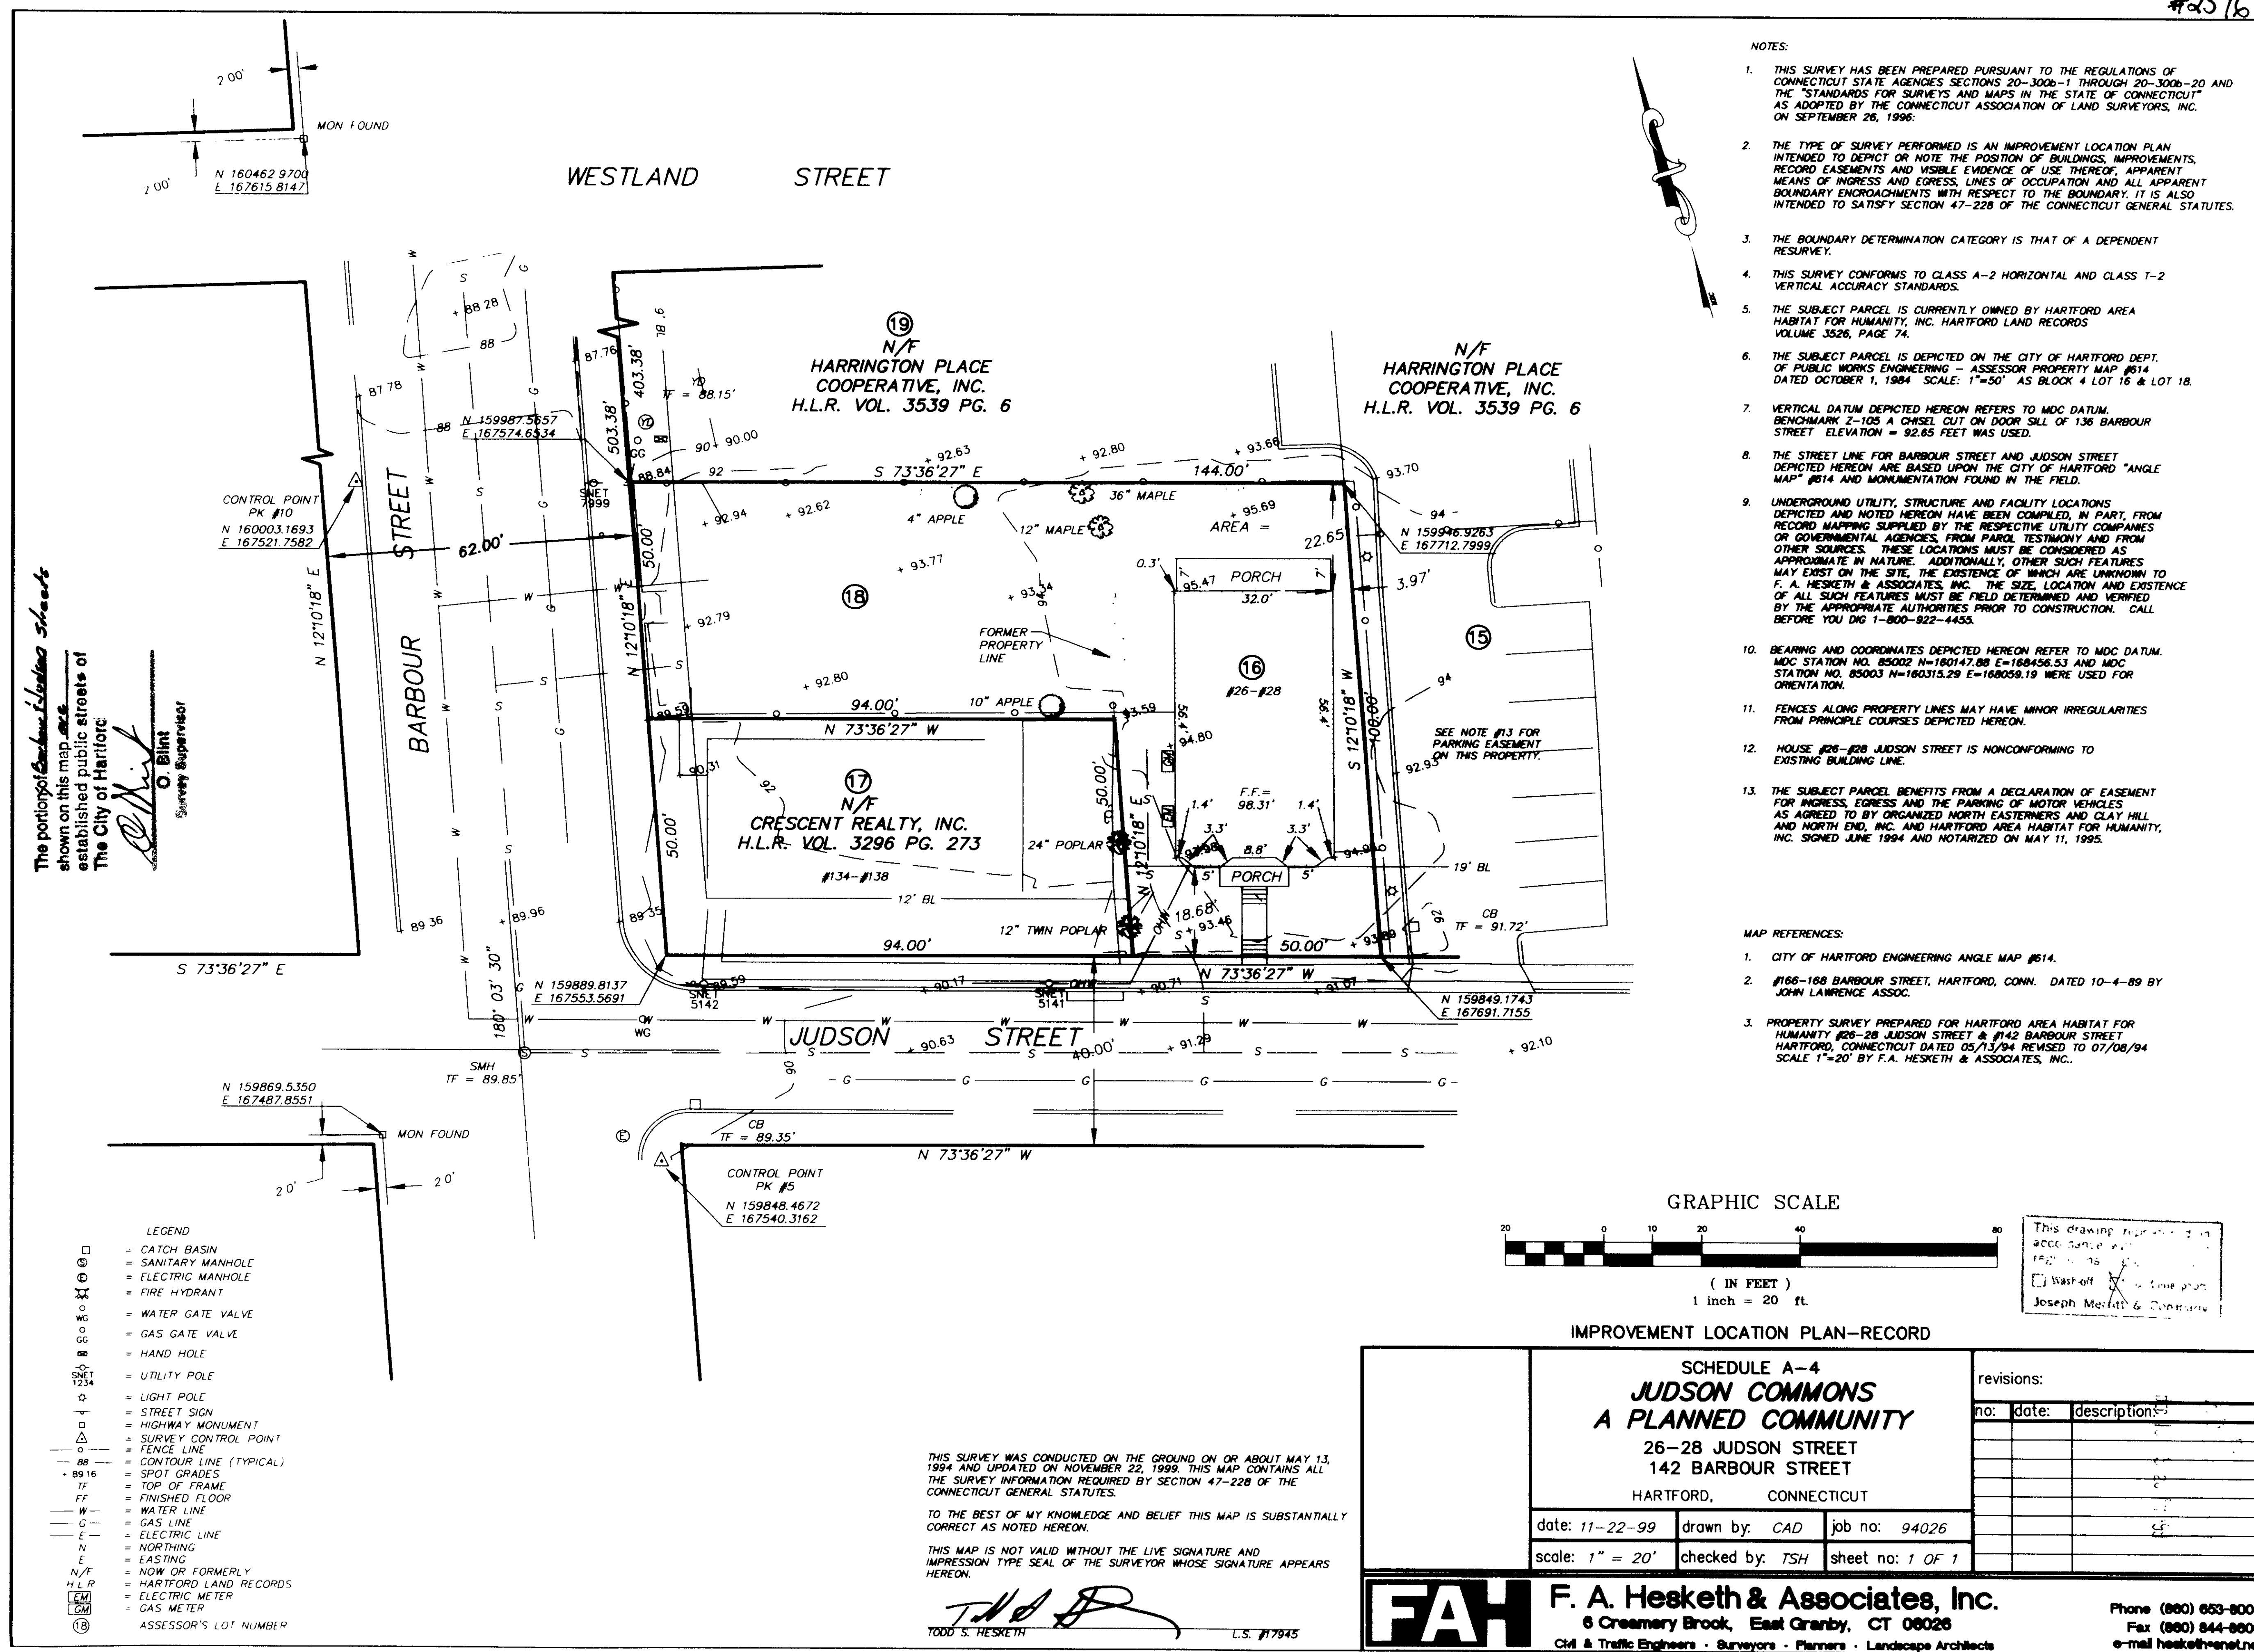

0 INCHES 1 2 3 4