


#2383

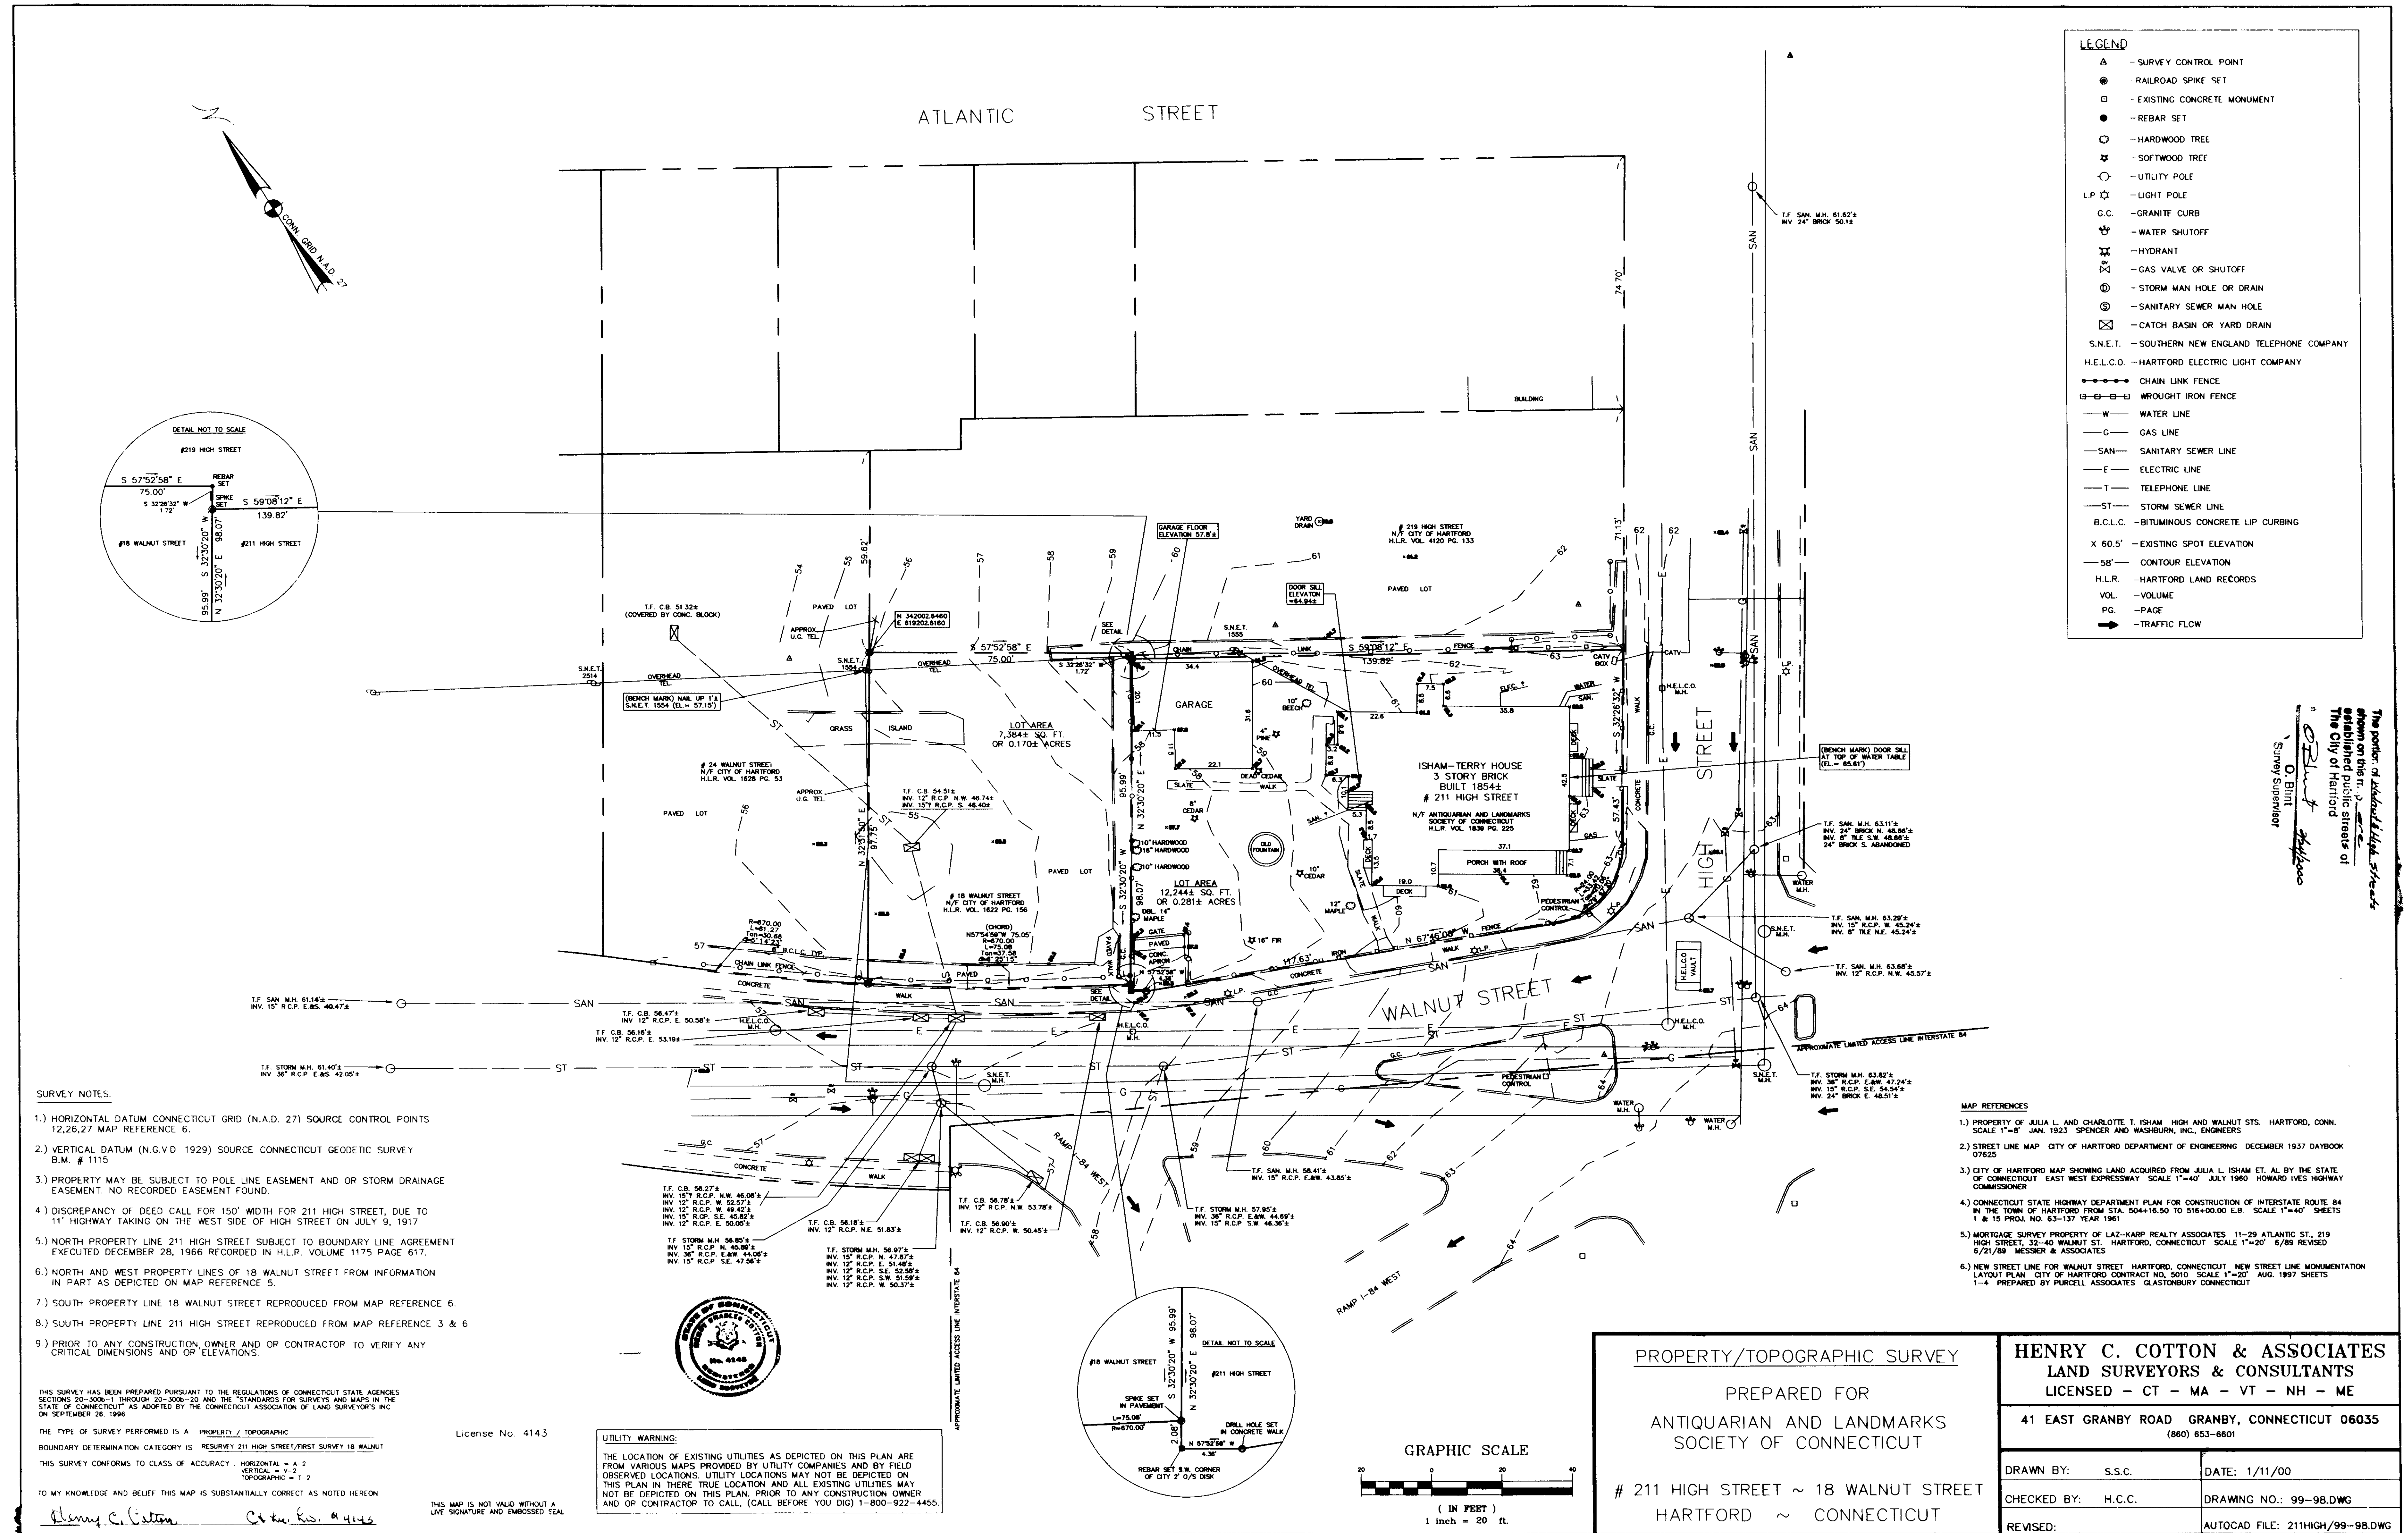

2383

#2383