


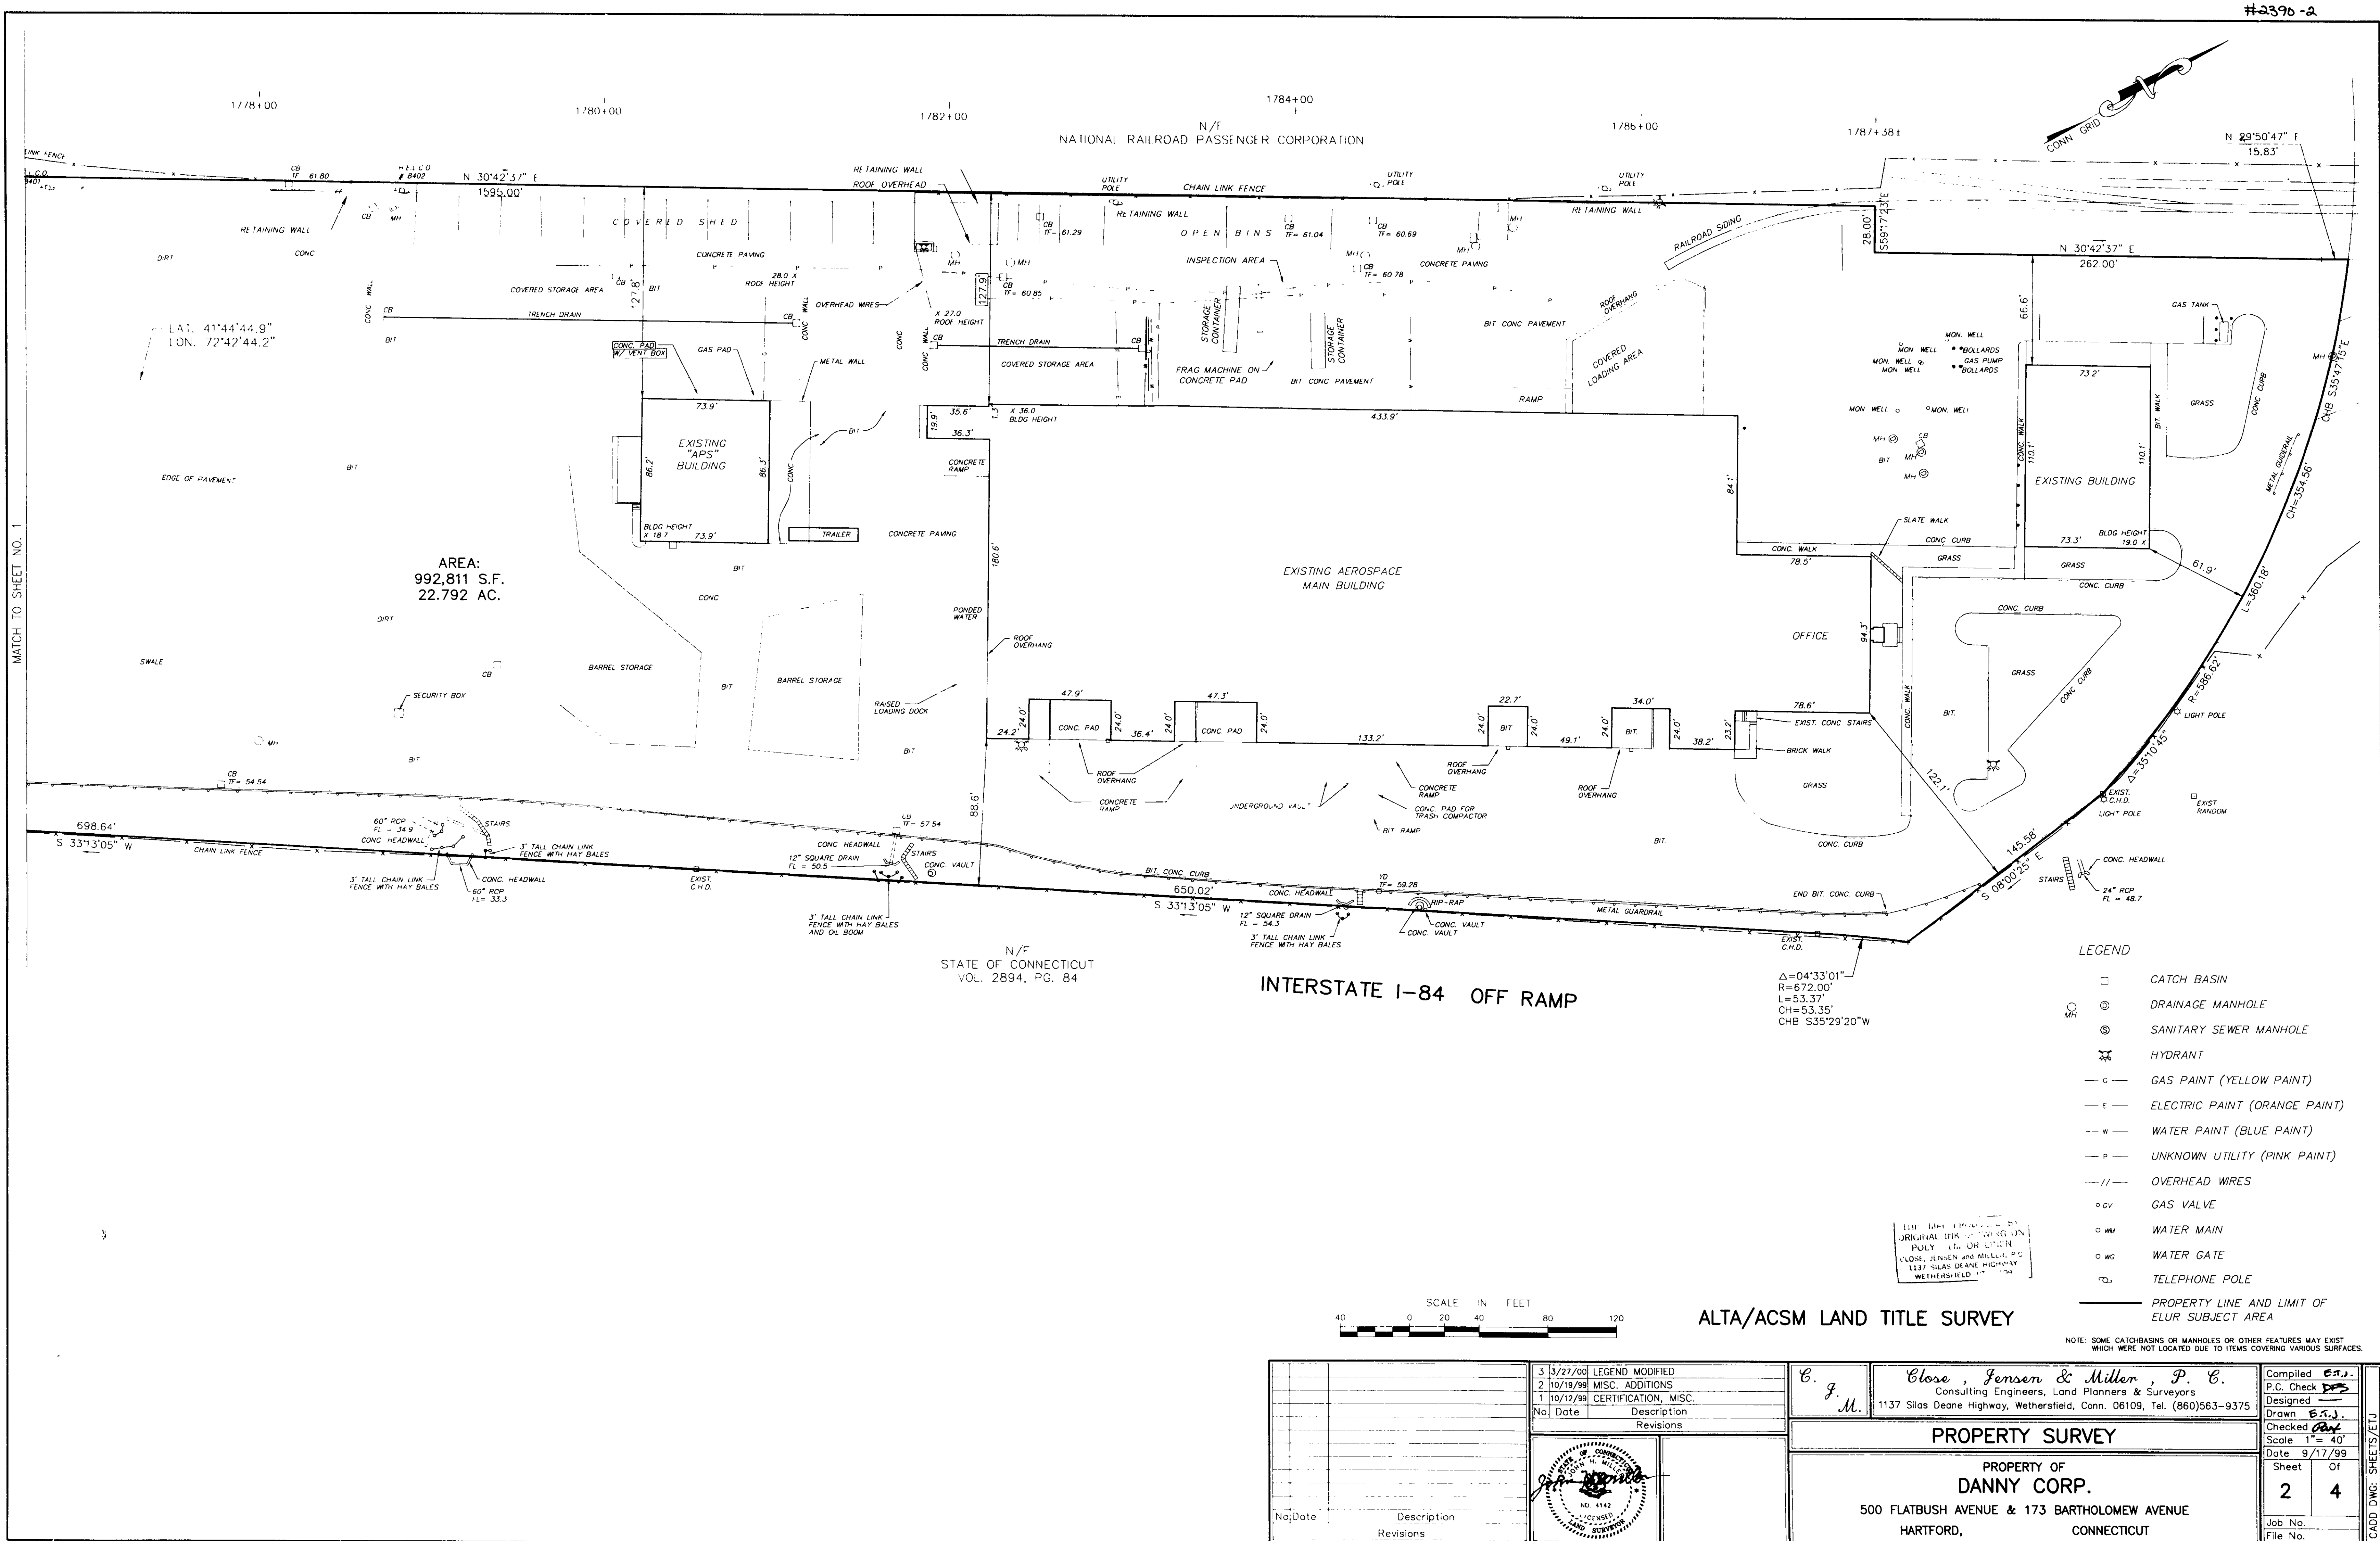

2390-2
