


#2393

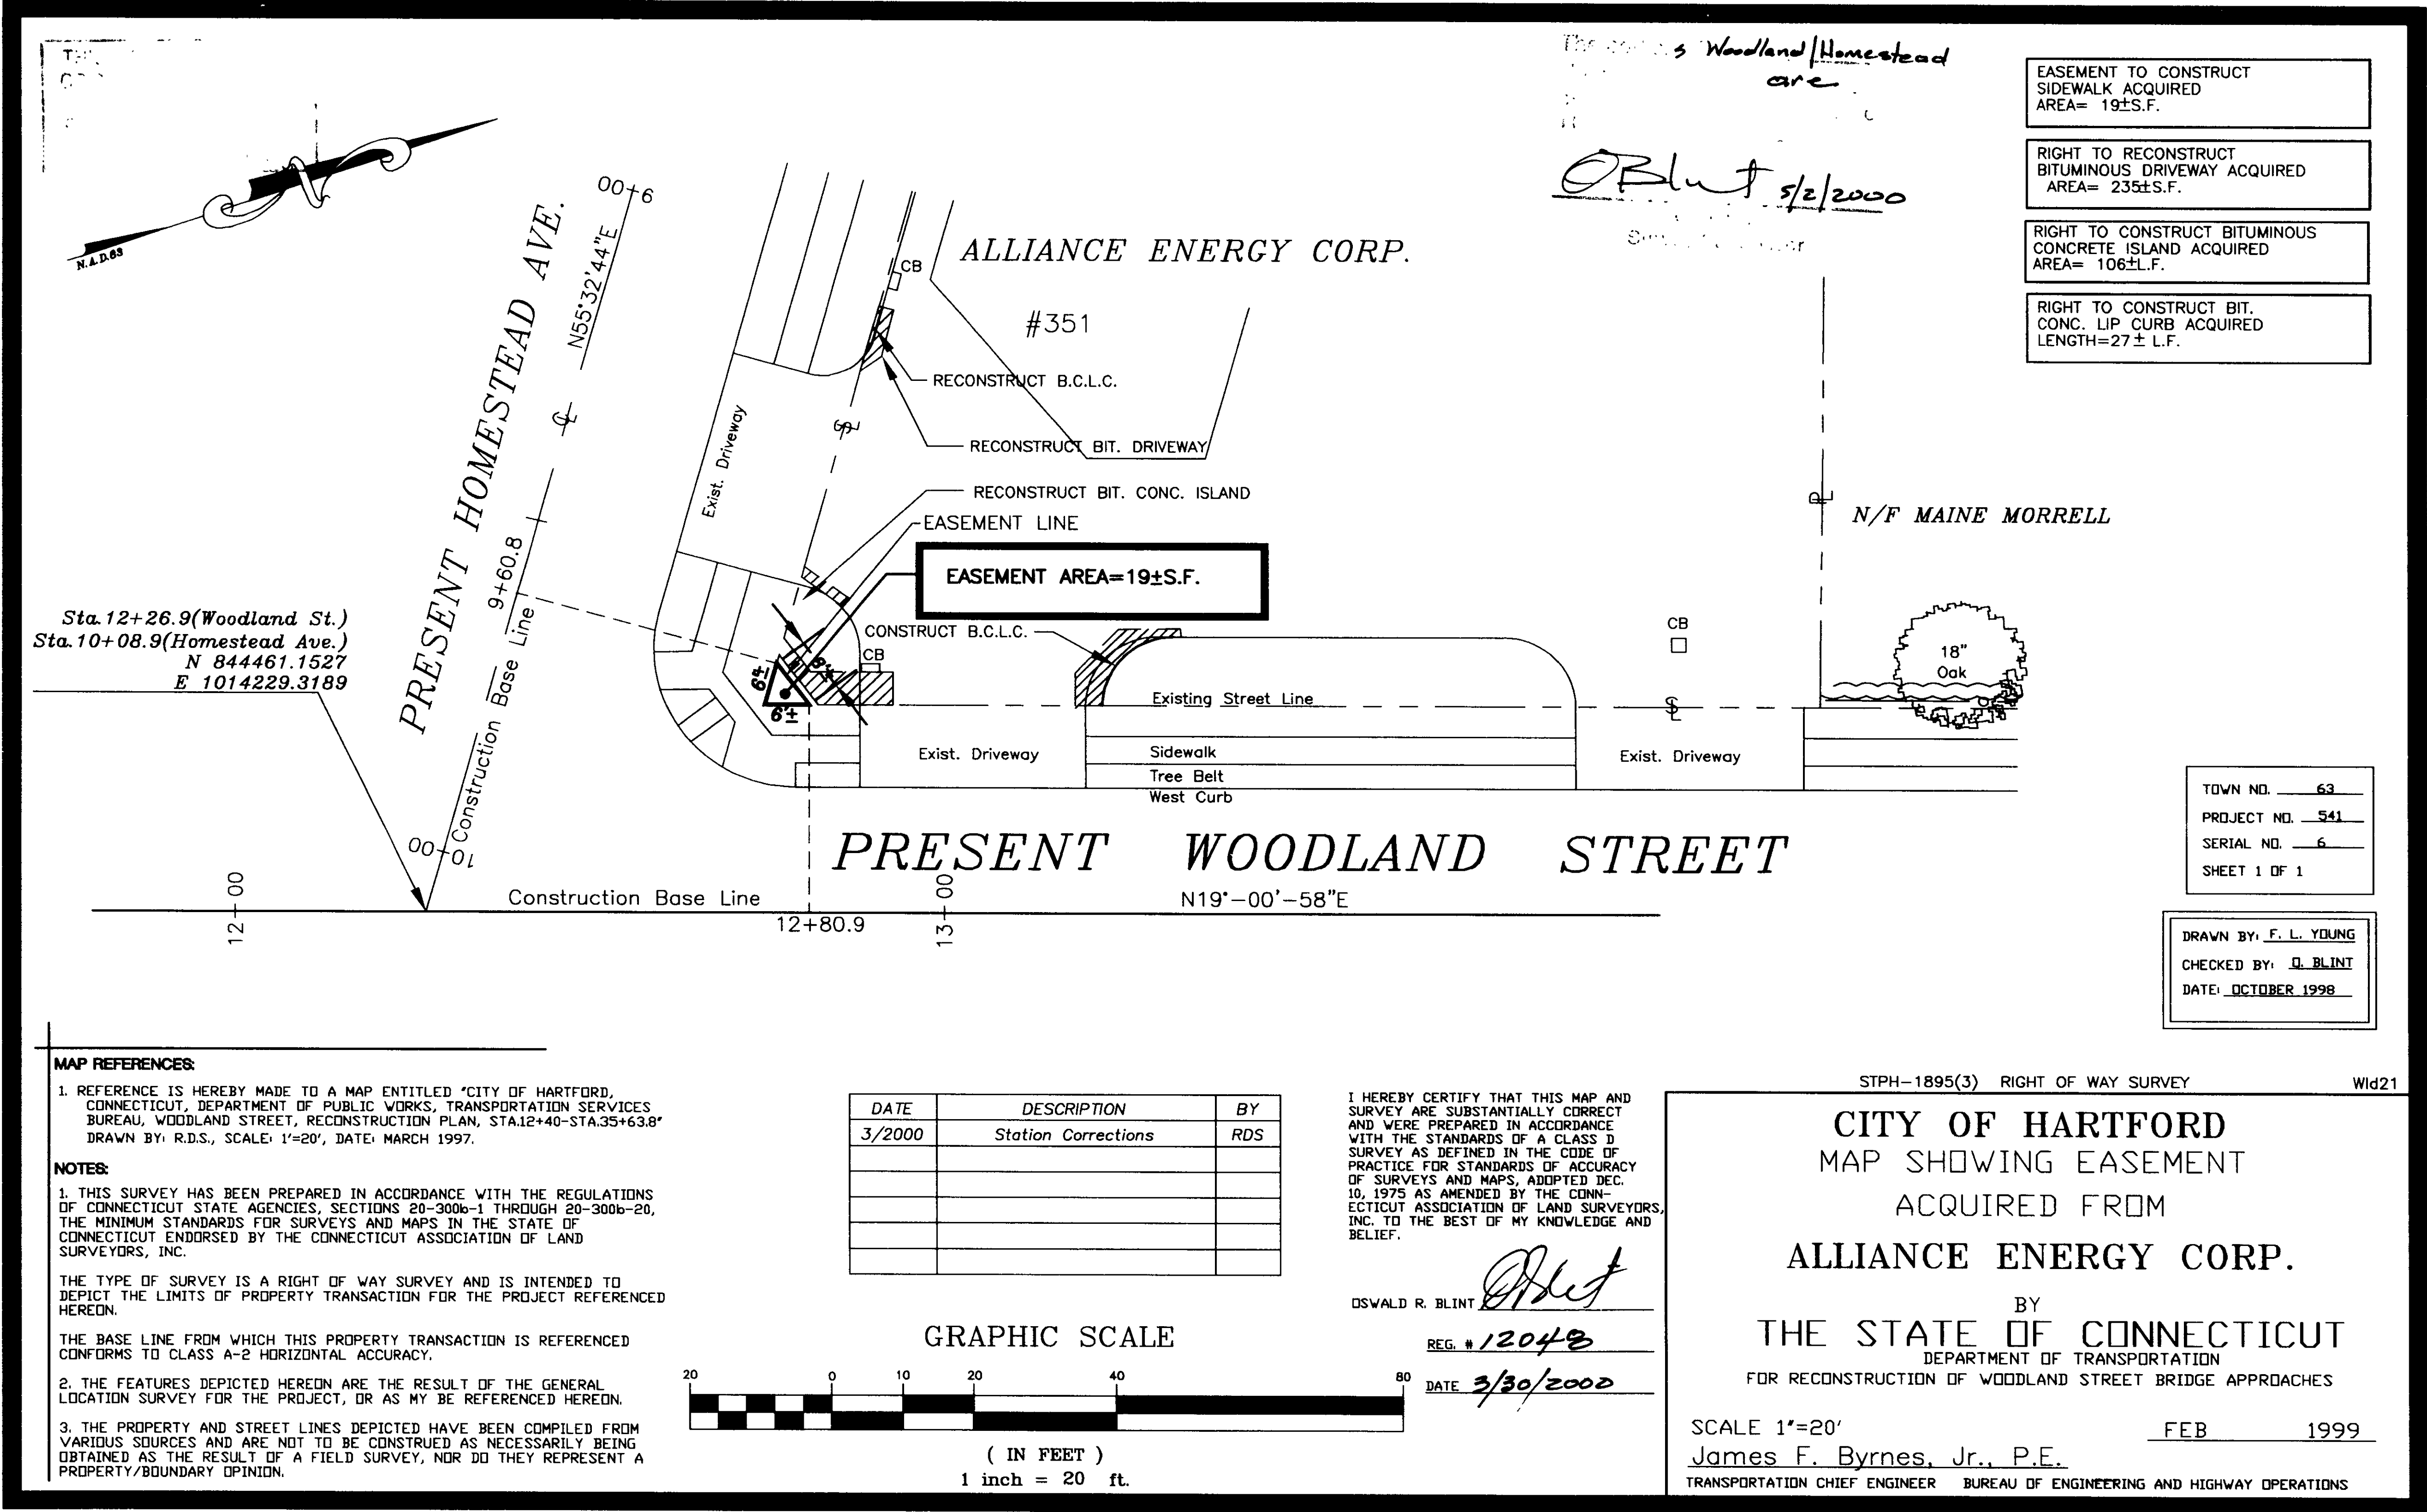

#2393

