



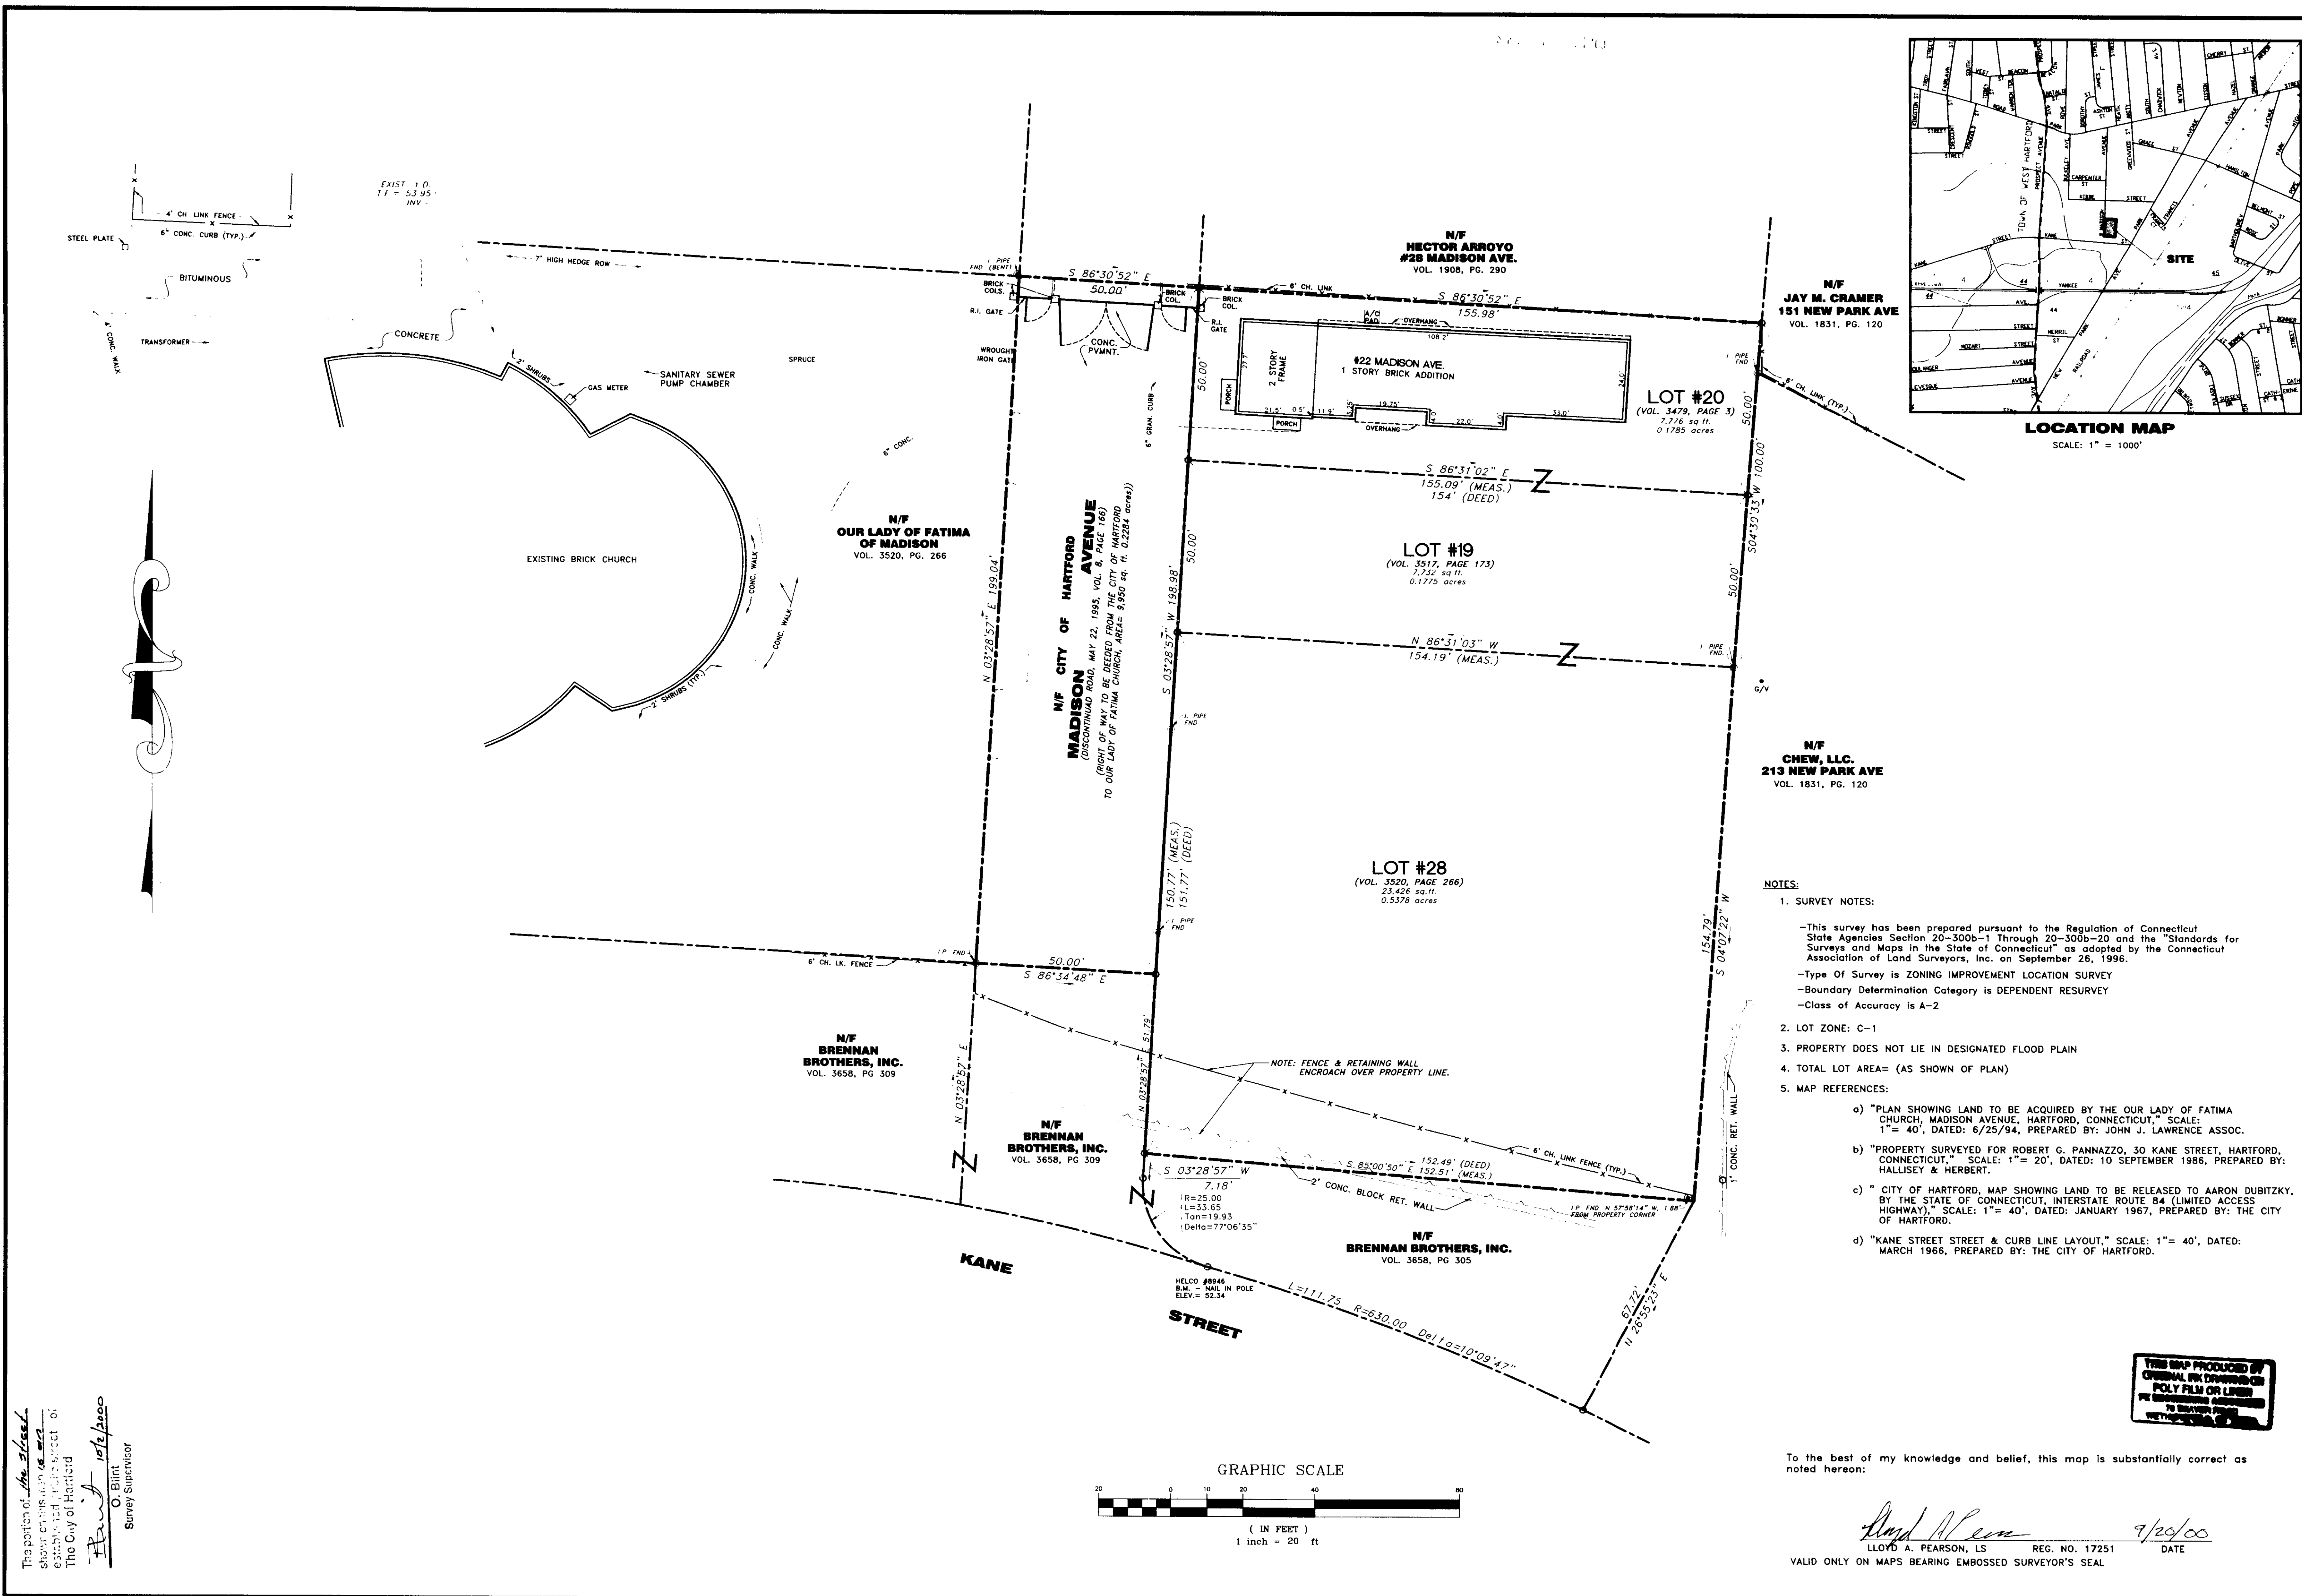

**PROPERTY SURVEY
PREPARED FOR
OUR LADY OF FATIMA
MADISON AVENUE
HARTFORD, CONNECTICUT**

CHECKED BY: J.P.C.
DATE: SEPT. 20, 2000
JOB NO.: 828
ACAD FILE: 823-A-2
SHEET: 1 OF 1
REVISIONS:

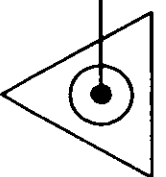

HALLISEY, PEARSON & CASSIDY
CIVIL ENGINEERS & LAND SURVEYORS
78 BEAVER ROAD, WETHERSFIELD, CONNECTICUT

9/16/2

