


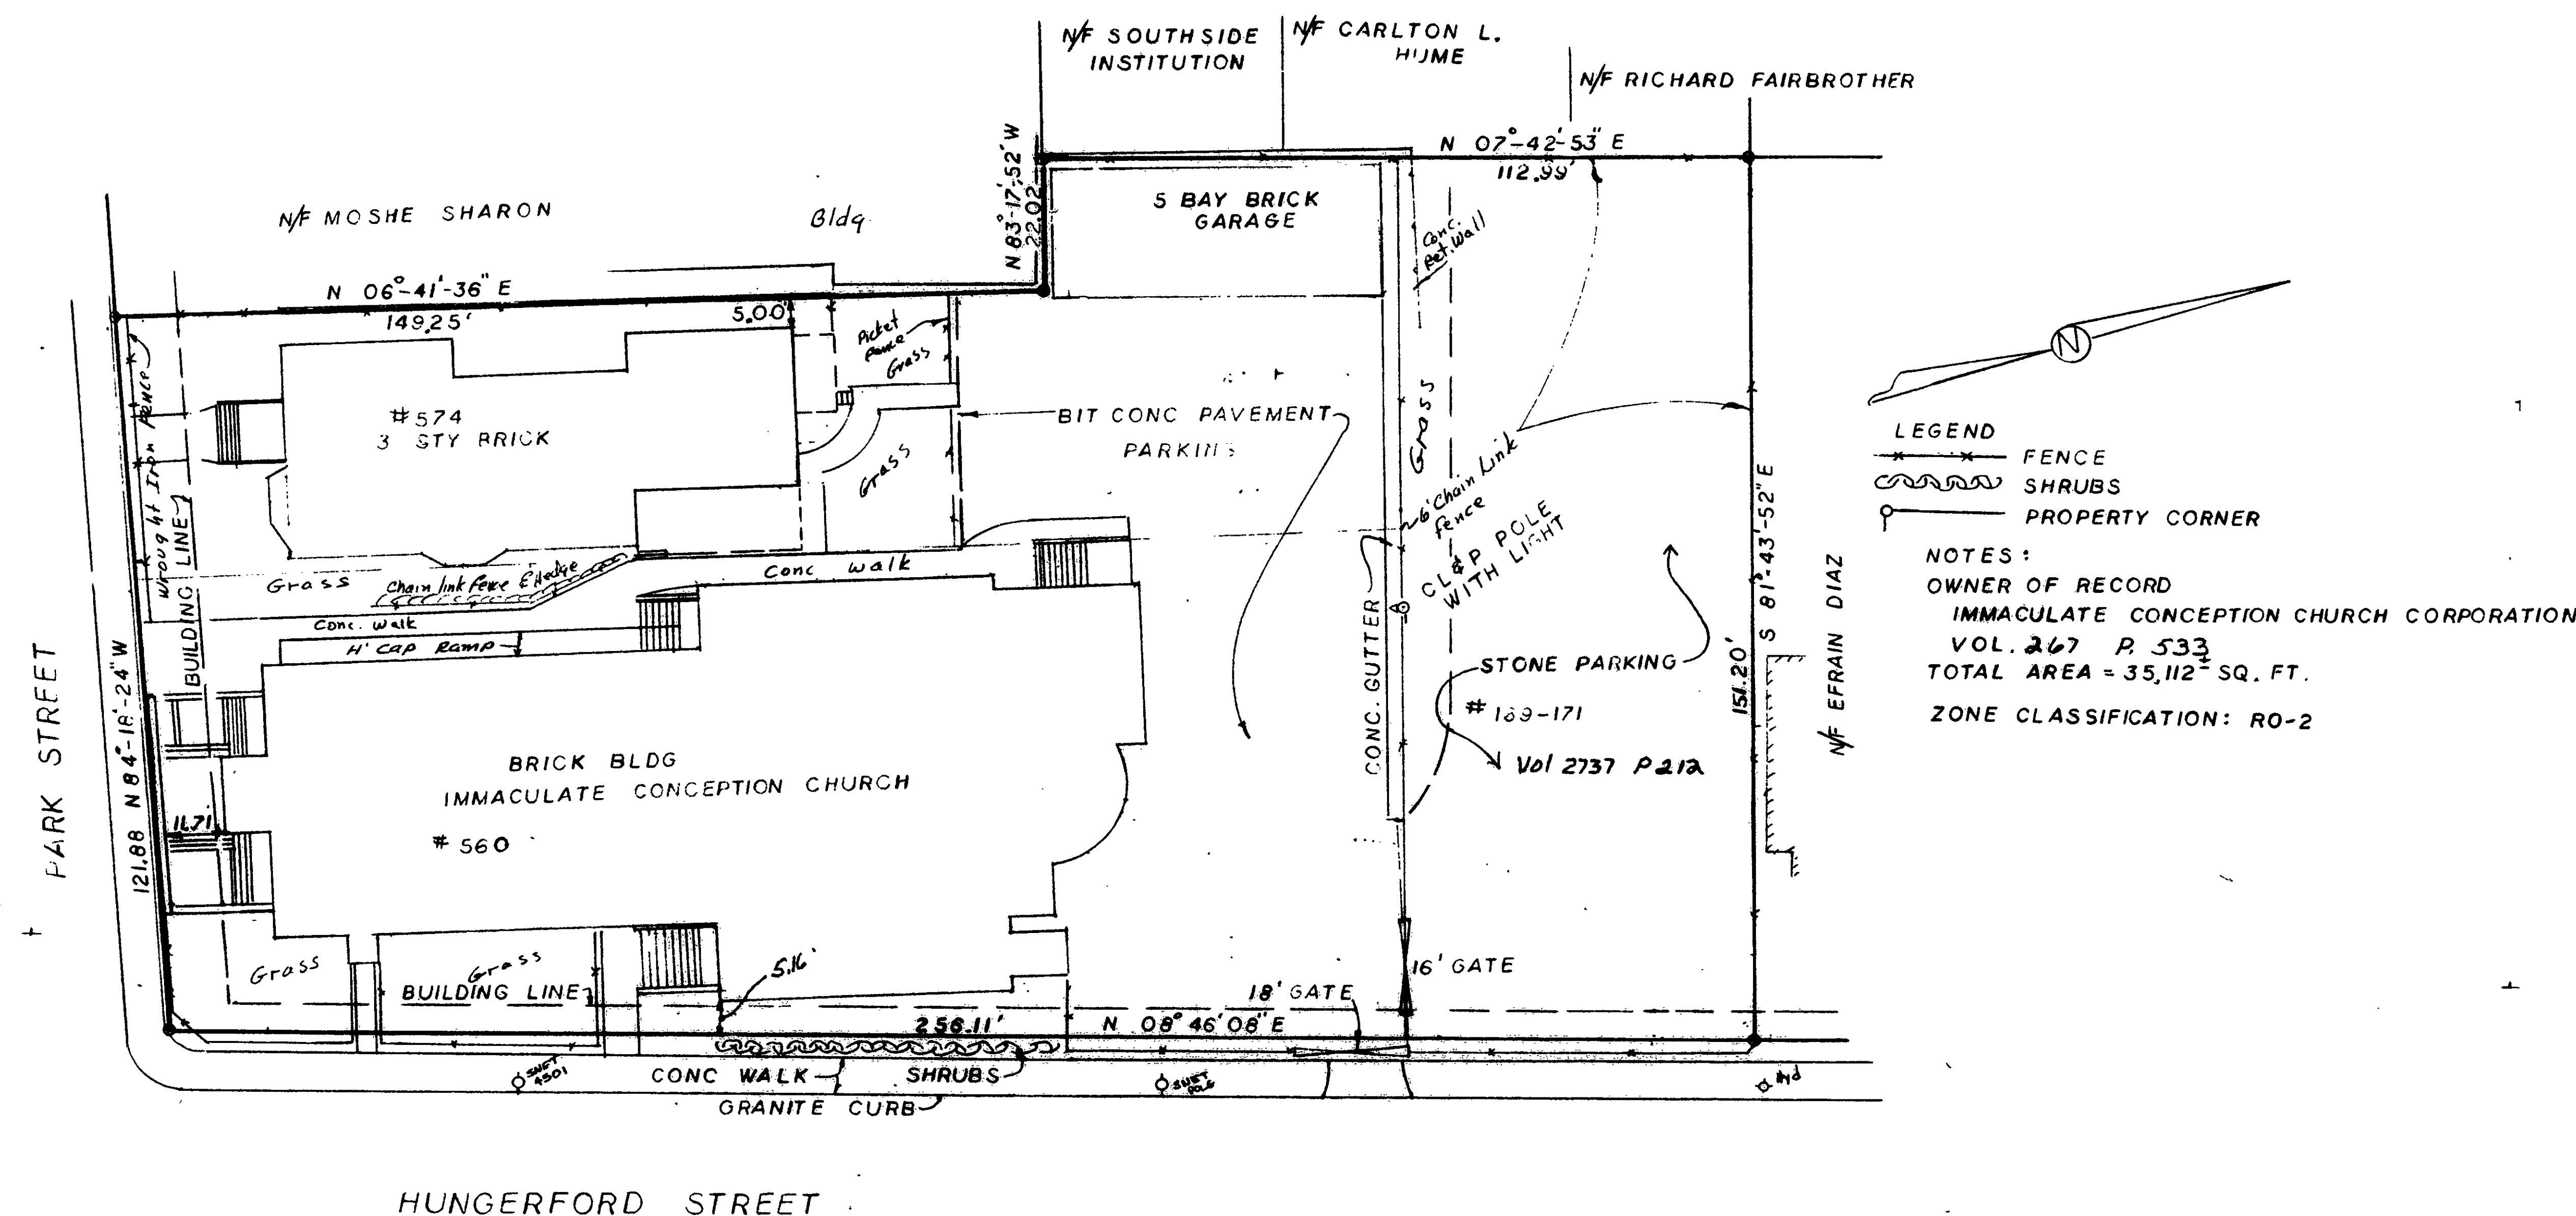

TO: LAWYERS TITLE INSURANCE CORPORATION
IMMACULATE CONCEPTION CHURCH CORPORATION
IMMACULATE CONCEPTION SHELTER AND HOUSING CORPORATION
PEOPLE'S BANK

I hereby declare that the survey of the property depicted on this map was actually made upon the ground on July 18, 2000, that the survey and bounds and measurements shown on this map are correct and accurate within the standards of a Primary Survey of boundary determination category of a class of A-2, as set forth in Sections 20-300b-1 through 20-300b-30 of the Regulations of Connecticut State Agencies, and that, except as otherwise indicated or noted hereon: (a) the lines and lines of actual possession are the same; (b) all building lines and improvements are located as shown, are erected entirely within the property lines, and do not encroach over or upon the street, this or building lines or any right of way or easement on or appurtenant to the property; (c) there are no utility or other easements or rights of way affecting the property; (d) there are no encroachments or projections on or over the property or on rights of way or easements appurtenant to the same by buildings or improvements erected on adjacent land; and (e) the buildings and improvements on this property do not violate any building or zoning regulations, covenants, deed restriction or other restrictive requirements relating to the location thereof.

James J. Delmastro
James J. Delmastro, Land Surveyor

THIS MAP IS VALID ONLY IF IT BEARS THE ORIGINAL SIGNATURE AND THE EMBOSSED SEAL OF THE SURVEYOR

PLAN OF PROPERTY TO BE CONVEYED TO
IMMACULATE CONCEPTION SHELTER AND HOUSING CORPORATION
560 AND 574 PARK STREET & 169-171 HUNGERFORD STREET, HARTFORD, CONN.
SCALE 1"=20'
JULY 18, 2000
REVISED NOV. 3, 2000

PREPARED BY: DELMASTRO SURVEY
32 SAWMILL ROAD
ROCKY HILL, CONN.
TEL. (860) 529-4455


This drawing represents an accordance with state regulations. Process used:
☐ Wet-off ☒ Fixed-line photo
Joseph Merritt & Company