


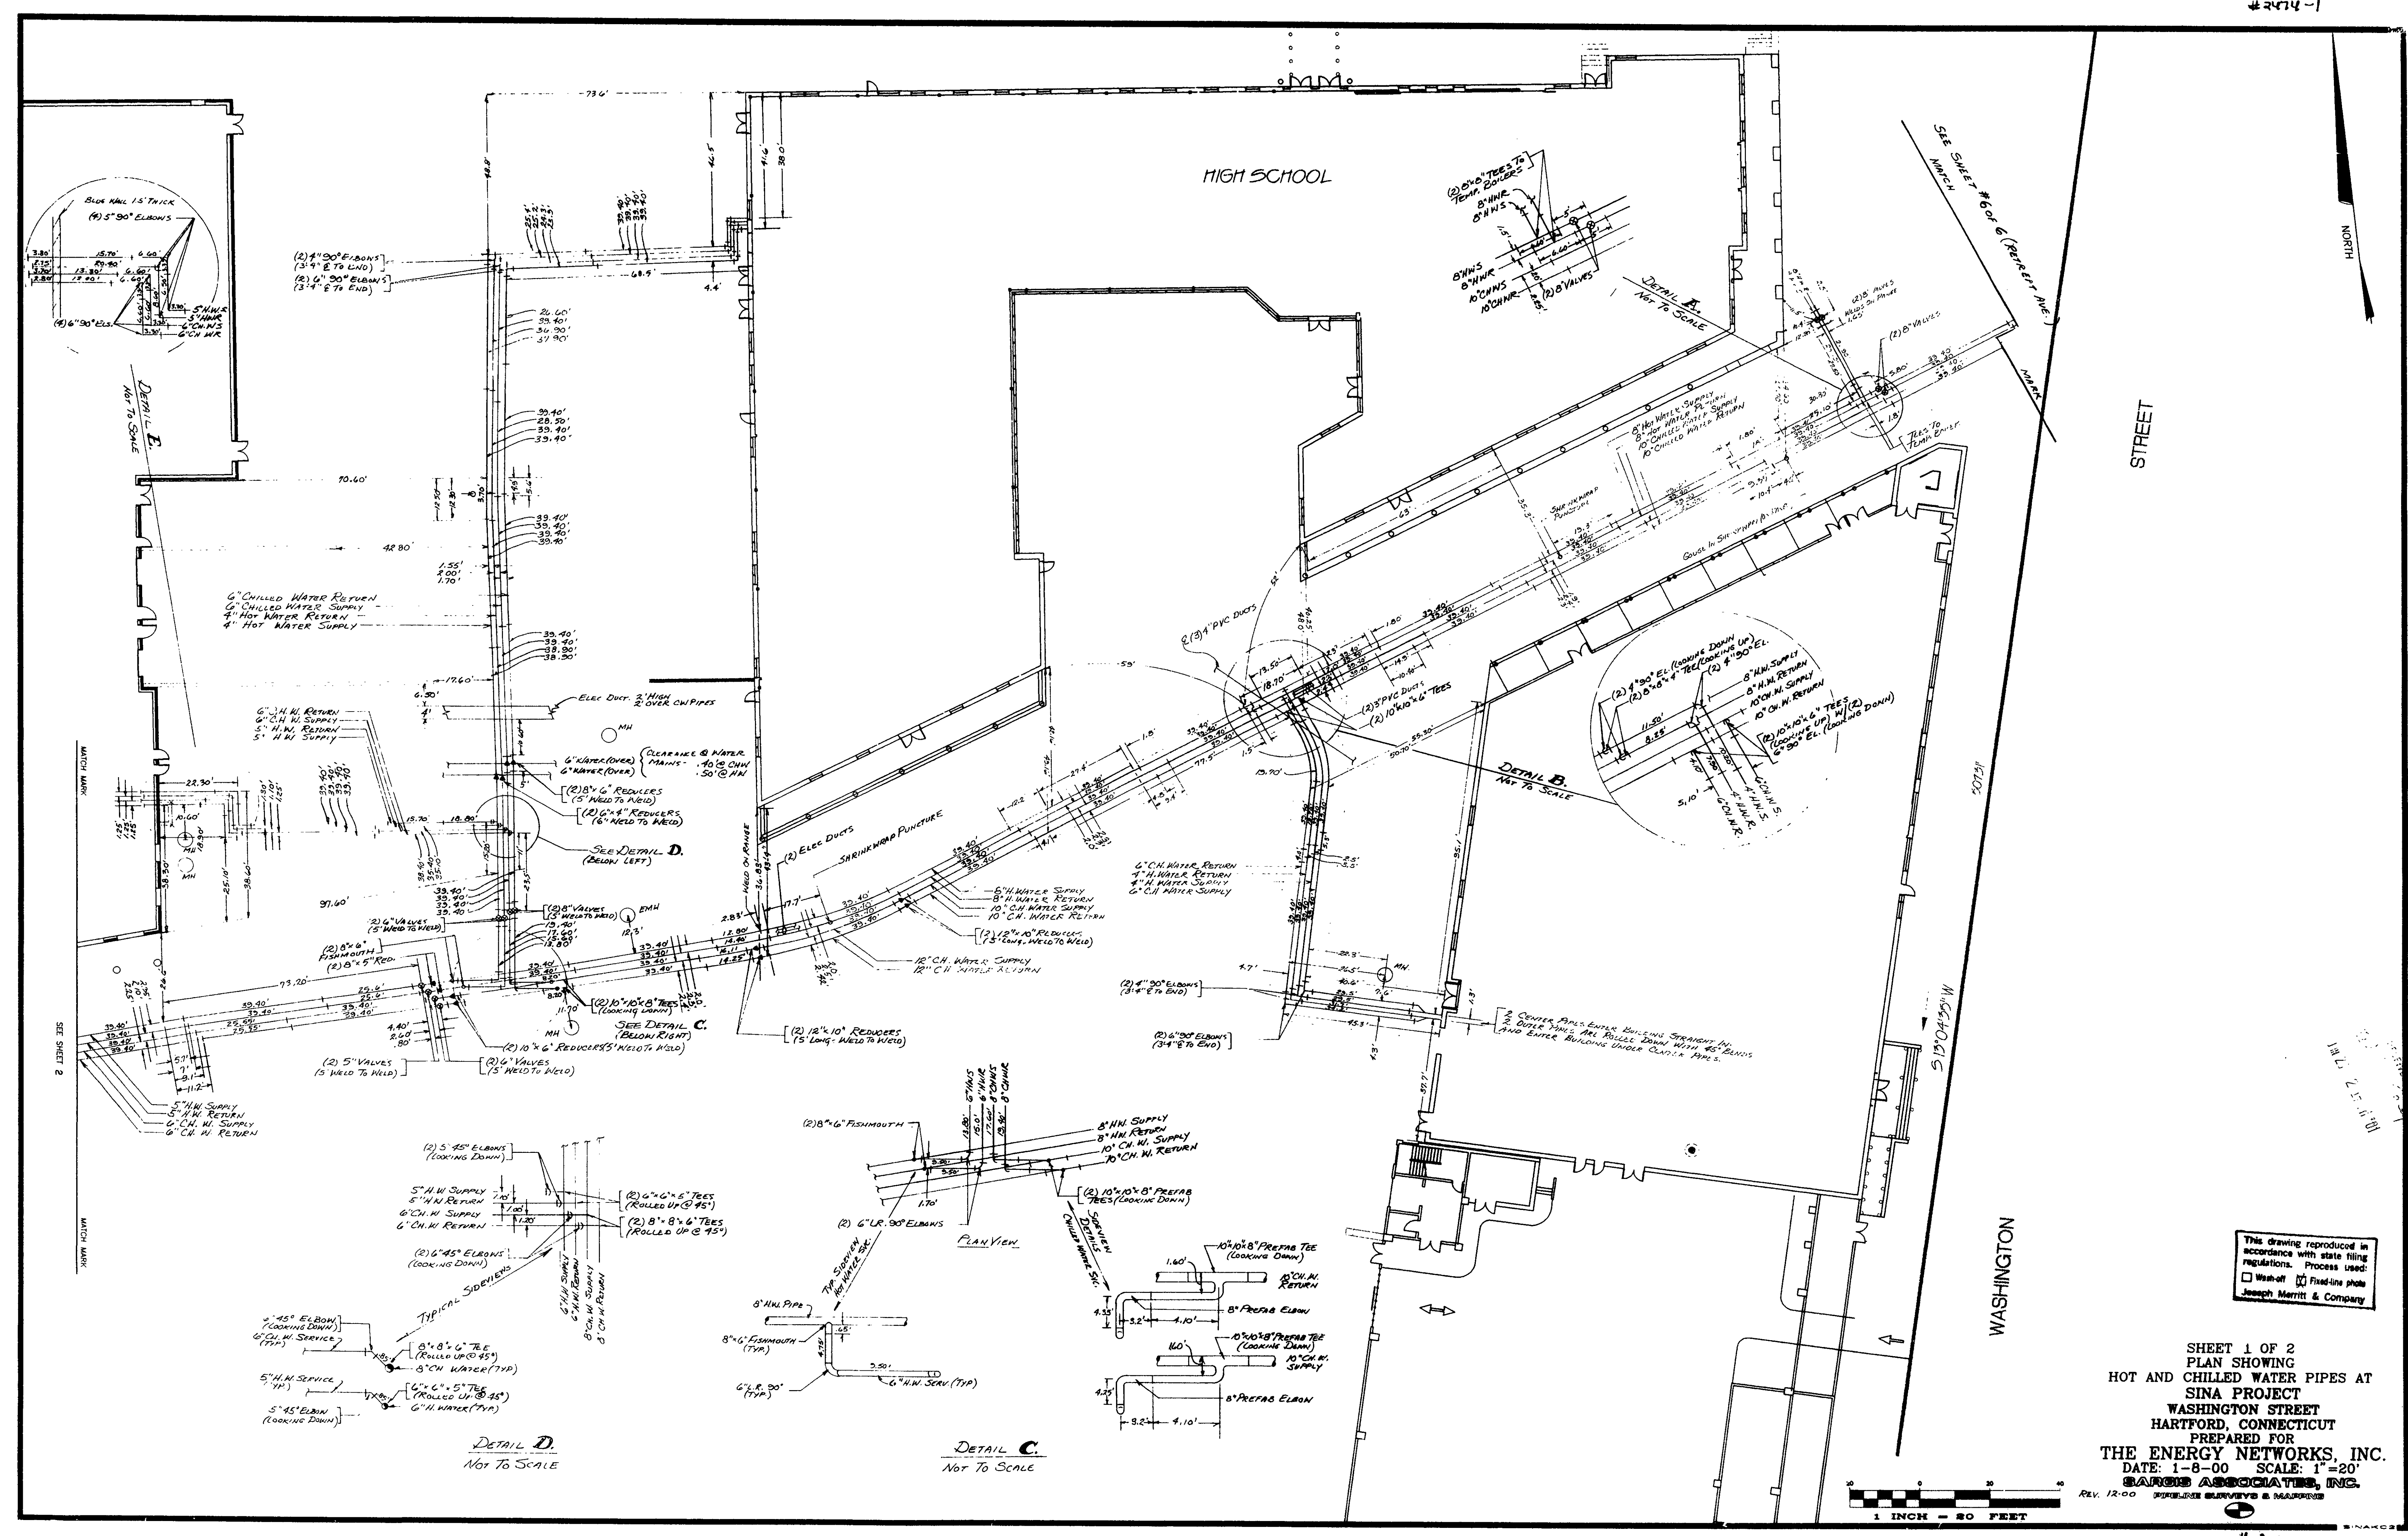

2474-1

This drawing reproduced in accordance with state filing regulations. Process used: Wash-off Fixed-line photo Joseph Merritt & Company

SHEET 1 OF 2
PLAN SHOWING
HOT AND CHILLED WATER PIPES AT
SINA PROJECT
WASHINGTON STREET
HARTFORD, CONNECTICUT
PREPARED FOR
THE ENERGY NETWORKS, INC.
DATE: 1-8-00 SCALE: 1"=20'
SARGES ASSOCIATES, INC.
REV. 12-00

1 INCH = 20 FEET

0 1 2 3 4
INCHES