#2474-2

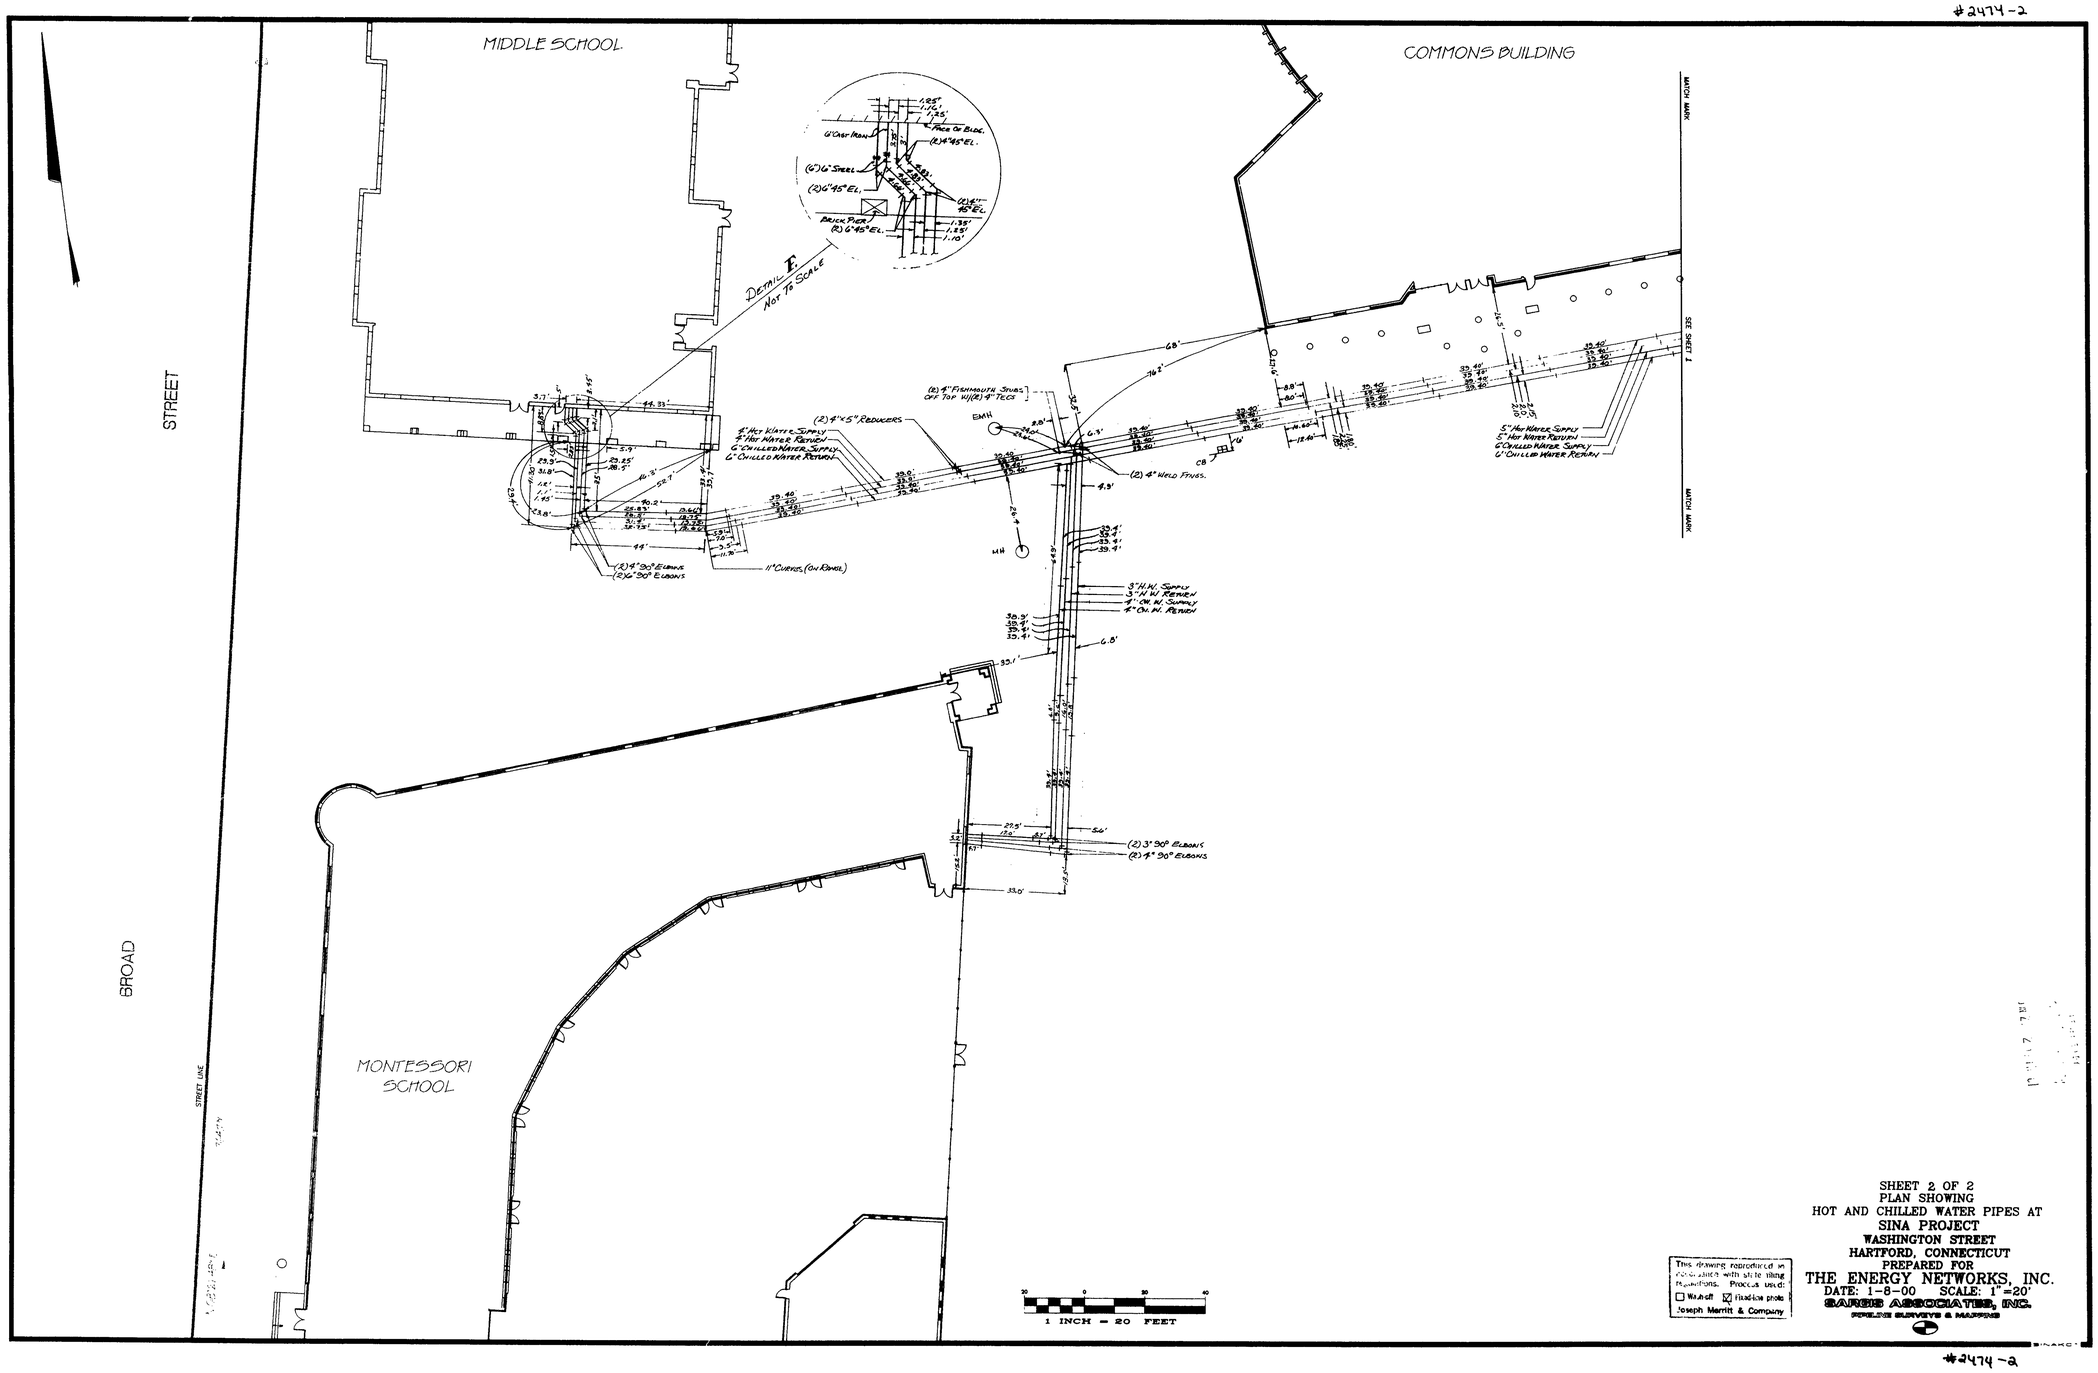

This drawing reproduced in accordance with state laws and regulations. Process used:
☐ Washoff ☒ Fixation prints
Joseph Merritt & Company

SHEET 2 OF 2
PLAN SHOWING
HOT AND CHILLED WATER PIPES AT
SINA PROJECT
WASHINGTON STREET
HARTFORD, CONNECTICUT
PREPARED FOR
THE ENERGY NETWORKS, INC.
DATE: 1-8-00 SCALE: 1"=20'

2474
2

#2474-2