


2475

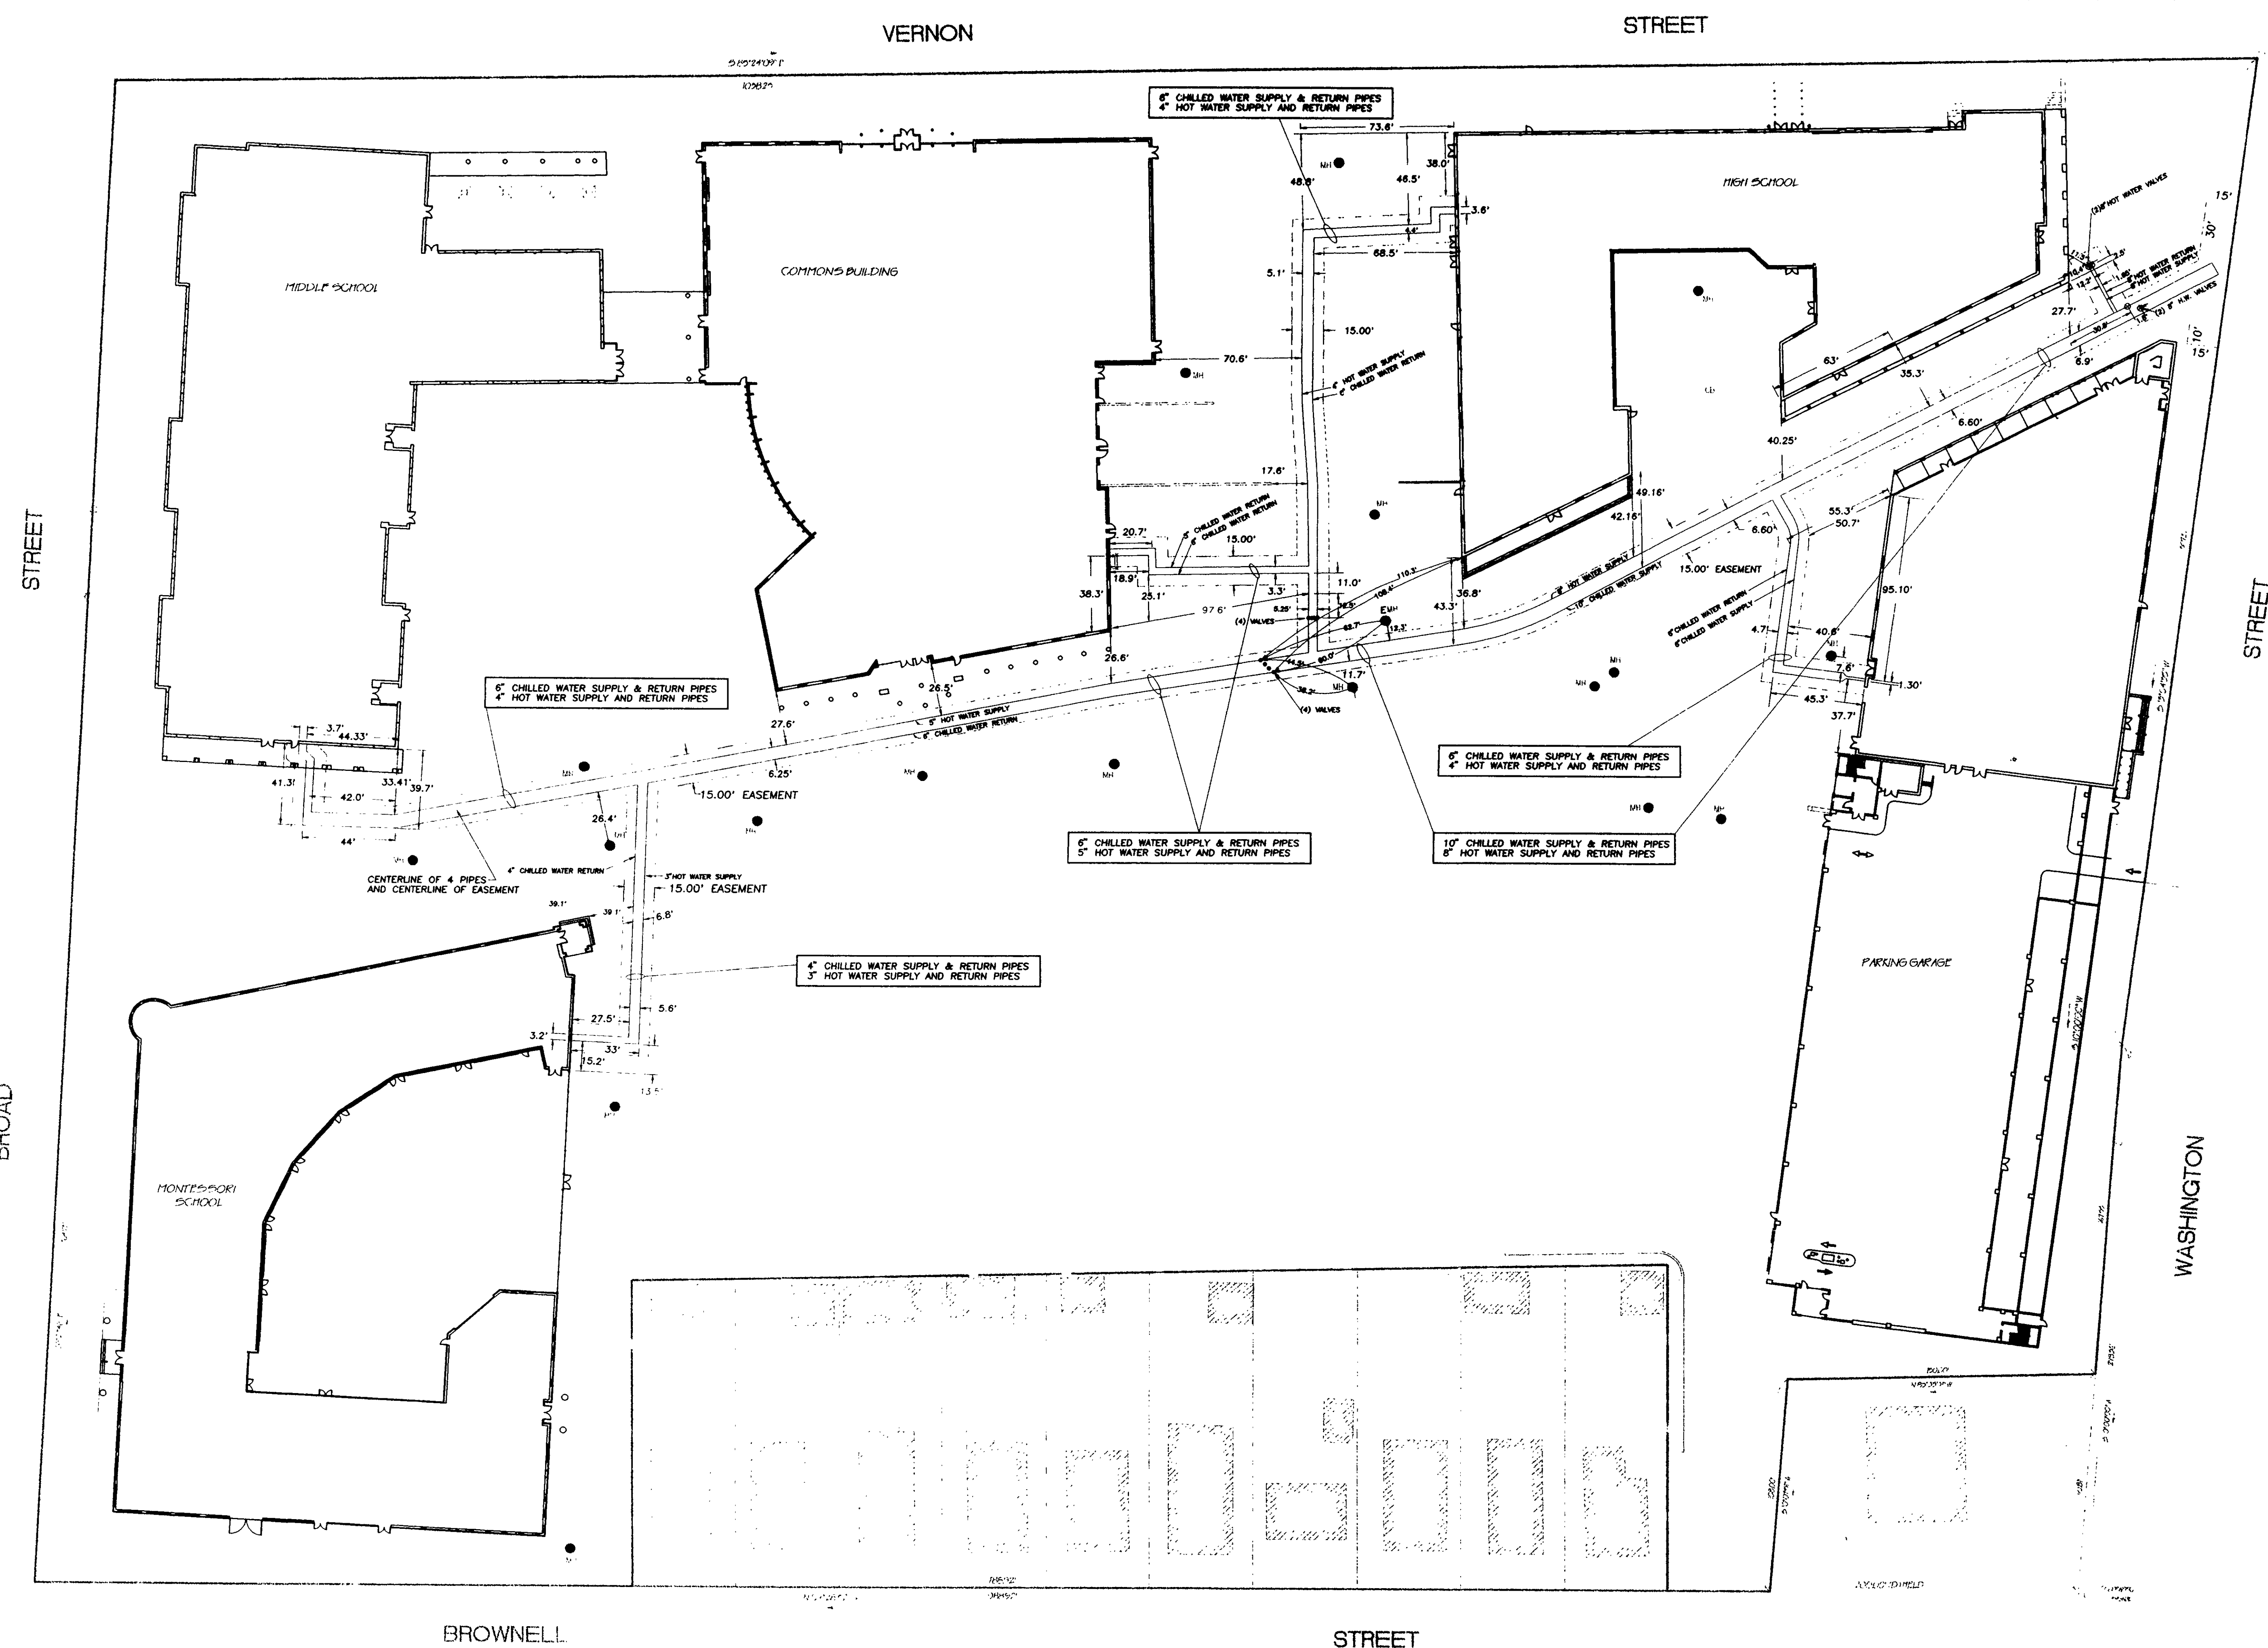

2475

1 INCH = 40 FEET

NOTE: 4 PIPE SYSTEM - OUTER 2 PIPES SHOWN

PIPE LOCATION SURVEY
HOT AND CHILLED WATER PIPES AT
SINA PROJECT
WASHINGTON STREET
HARTFORD, CONNECTICUT
EASEMENT IN FAVOR OF
THE ENERGY NETWORKS, INC.
DATE: 1-8-00 SCALE: 1"=40'
SARGIS ASSOCIATES, INC.
REGISTERED SURVEYORS & ENGINEERS

This drawing reproduced in
accordance with state filing
regulations. Process 09-04
[] Marked [] Field Note
Joseph Martin & Company

0 1 2 3 4
INCHES