


The portion of New Park Ave.
shown on this map is a
established public street of
the City of Hartford

Paul G. Blint
Survey Superintendent

#2487

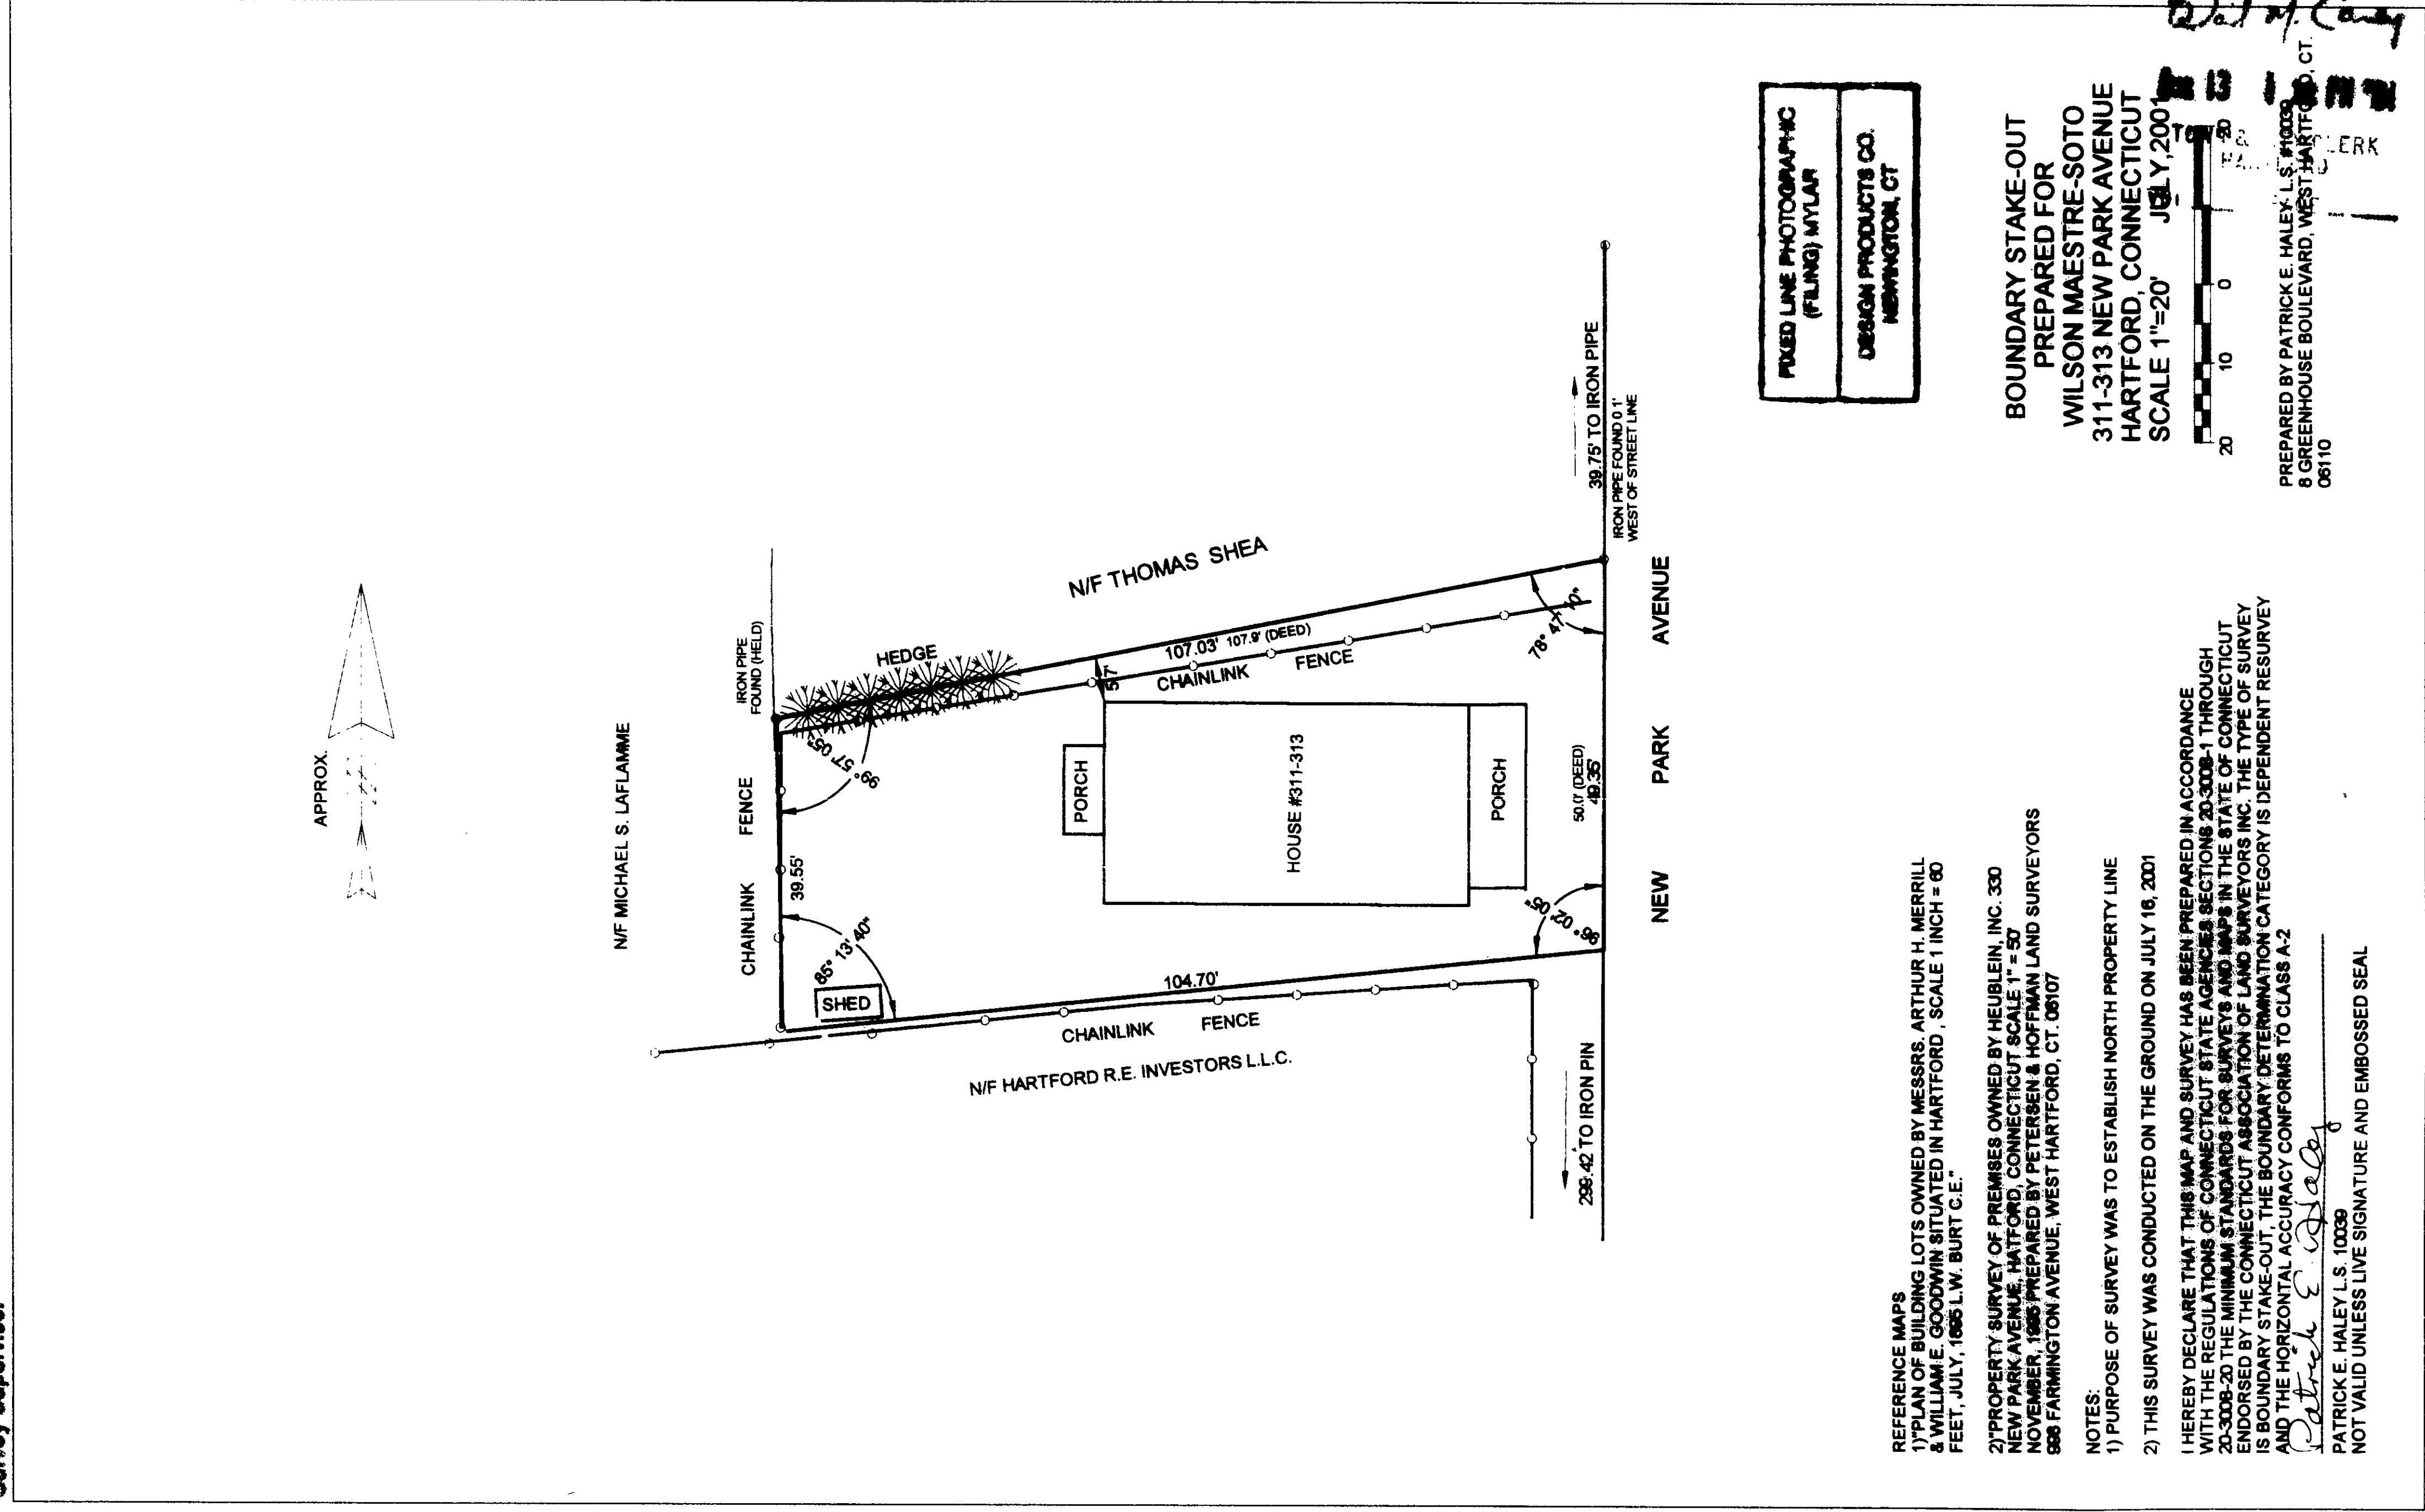

0 1 2 3 4
INCHES

2487

2487

#2487