2501-2

#2501-2

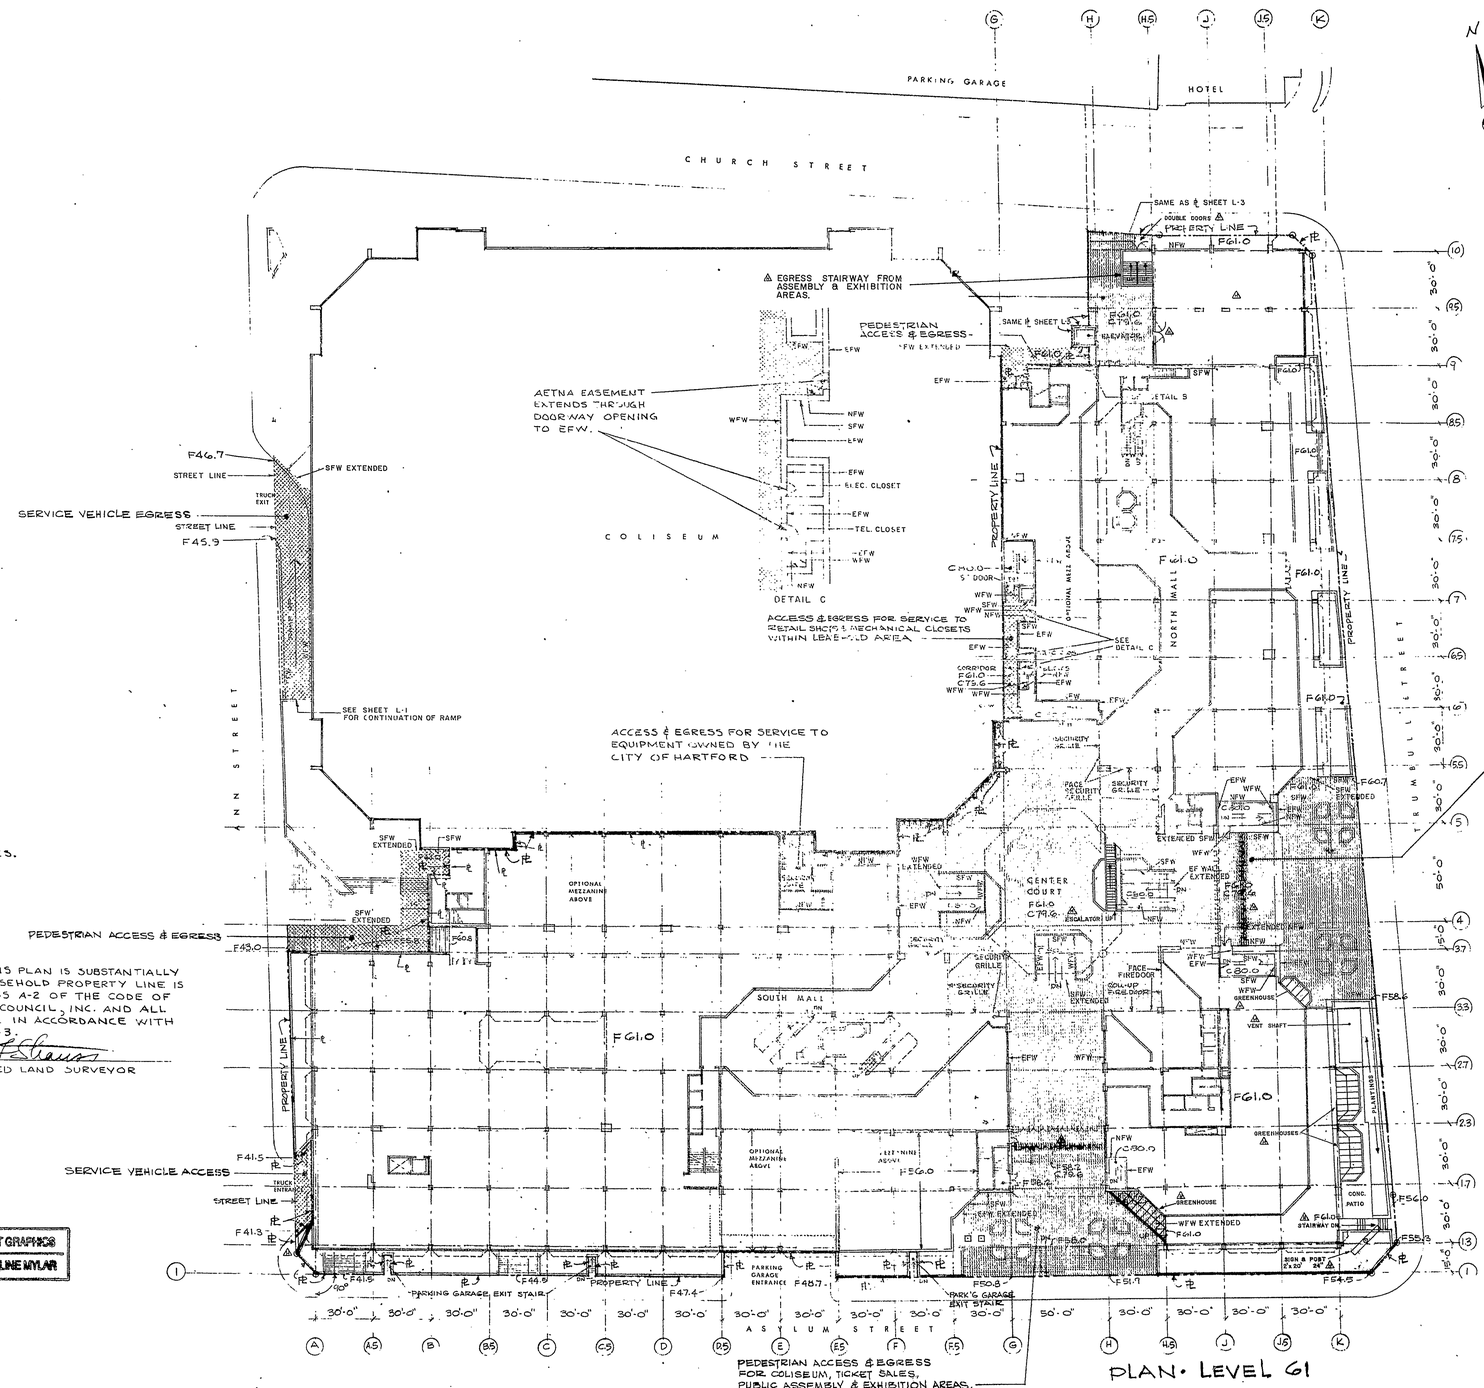

LEGEND

NFW	NORTH FACE OF WALL
SFW	SOUTH FACE OF WALL
EFW	EAST FACE OF WALL
WFW	WEST FACE OF WALL

NOTES:

1. SEE SHEET L-1 FOR NOTES.

I HEREBY CERTIFY THAT THIS PLAN IS SUBSTANTIALLY CORRECT AND THAT THE LEASEHOLD PROPERTY LINE IS IN ACCORDANCE WITH CLASS A-2 OF THE CODE OF CONNECTICUT TECHNICAL COUNCIL, INC. AND ALL OTHER MEASUREMENTS ARE IN ACCORDANCE WITH NOTE 1 ON DRAWING L-3.

REGISTERED LAND SURVEYOR

STATE OF CONNECTICUT

CREST GRAPHICS
FIXED LINE MYLAR

The roadways at the streets bounding this map are dedicated public roads of the City of Hartford

10/28/01

The Hartford Center

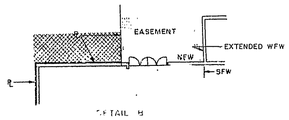

I hereby certify that all the items indicated by the symbol △ are items added or modified on this existing map by my office on or about May 1, 1985.

Roderick D. Hewitt L.S. #8432
Certificate date 10/01/01

AS-BUILT △ REVISIONS AS OF MAY 1, 1985 THE HARTFORD CENTER HARTFORD, CONN		STATE OF CONNECTICUT RODERICK D. HEWITT No. 8432 REGISTERED LAND SURVEYOR
HEWITT ENGINEERING P.C. Engineers and Surveyors Berlin, Connecticut		PROJECT NO. 85041
DATE: MAY 1, 1985	DRAWN & CHECKED BY: JCE & /	SHEET NO. 2 OF 3

LEGEND

- PROPERTY OF CITY OF HARTFORD
- AETNA LEASEHOLD AREA
- AETNA EASEMENT ON CITY PROPERTY
- CITY EASEMENT ON AETNA LEASEHOLD AREA
- F 00.0 BOTTOM LIMITING ELEVATION OF LEASEHOLD OR EASEMENT AREA (NOMINAL FLOOR ELEVATION).
- C 00.0 TOP LIMITING ELEVATION OF LEASEHOLD, EASEMENT OR OWNED AREA
- ⊥ PROPERTY LINE. SEE 80 LEVEL PLAN, SHEET L-3 FOR BOUNDARY DESCRIPTION.

LEASEHOLD & EASEMENT PLAN
LEVEL 61

THE HARTFORD CENTER
HARTFORD, CONNECTICUT

0 — 50 FT SCALE 1" = 32 FT 24 MAY 1974

REVISED NOV. 14, 1974

MORTON S. FINE and ASSOCIATES
711 Cottage Grove Rd. Bloomfield, Conn.
Engineers Landscape Architects Surveyors

DAYBOOK No. 010496 "B"

L2

#2501-2

EAS FILE CORP. IRVINE, CA 2501 2