
0 INCHES 1

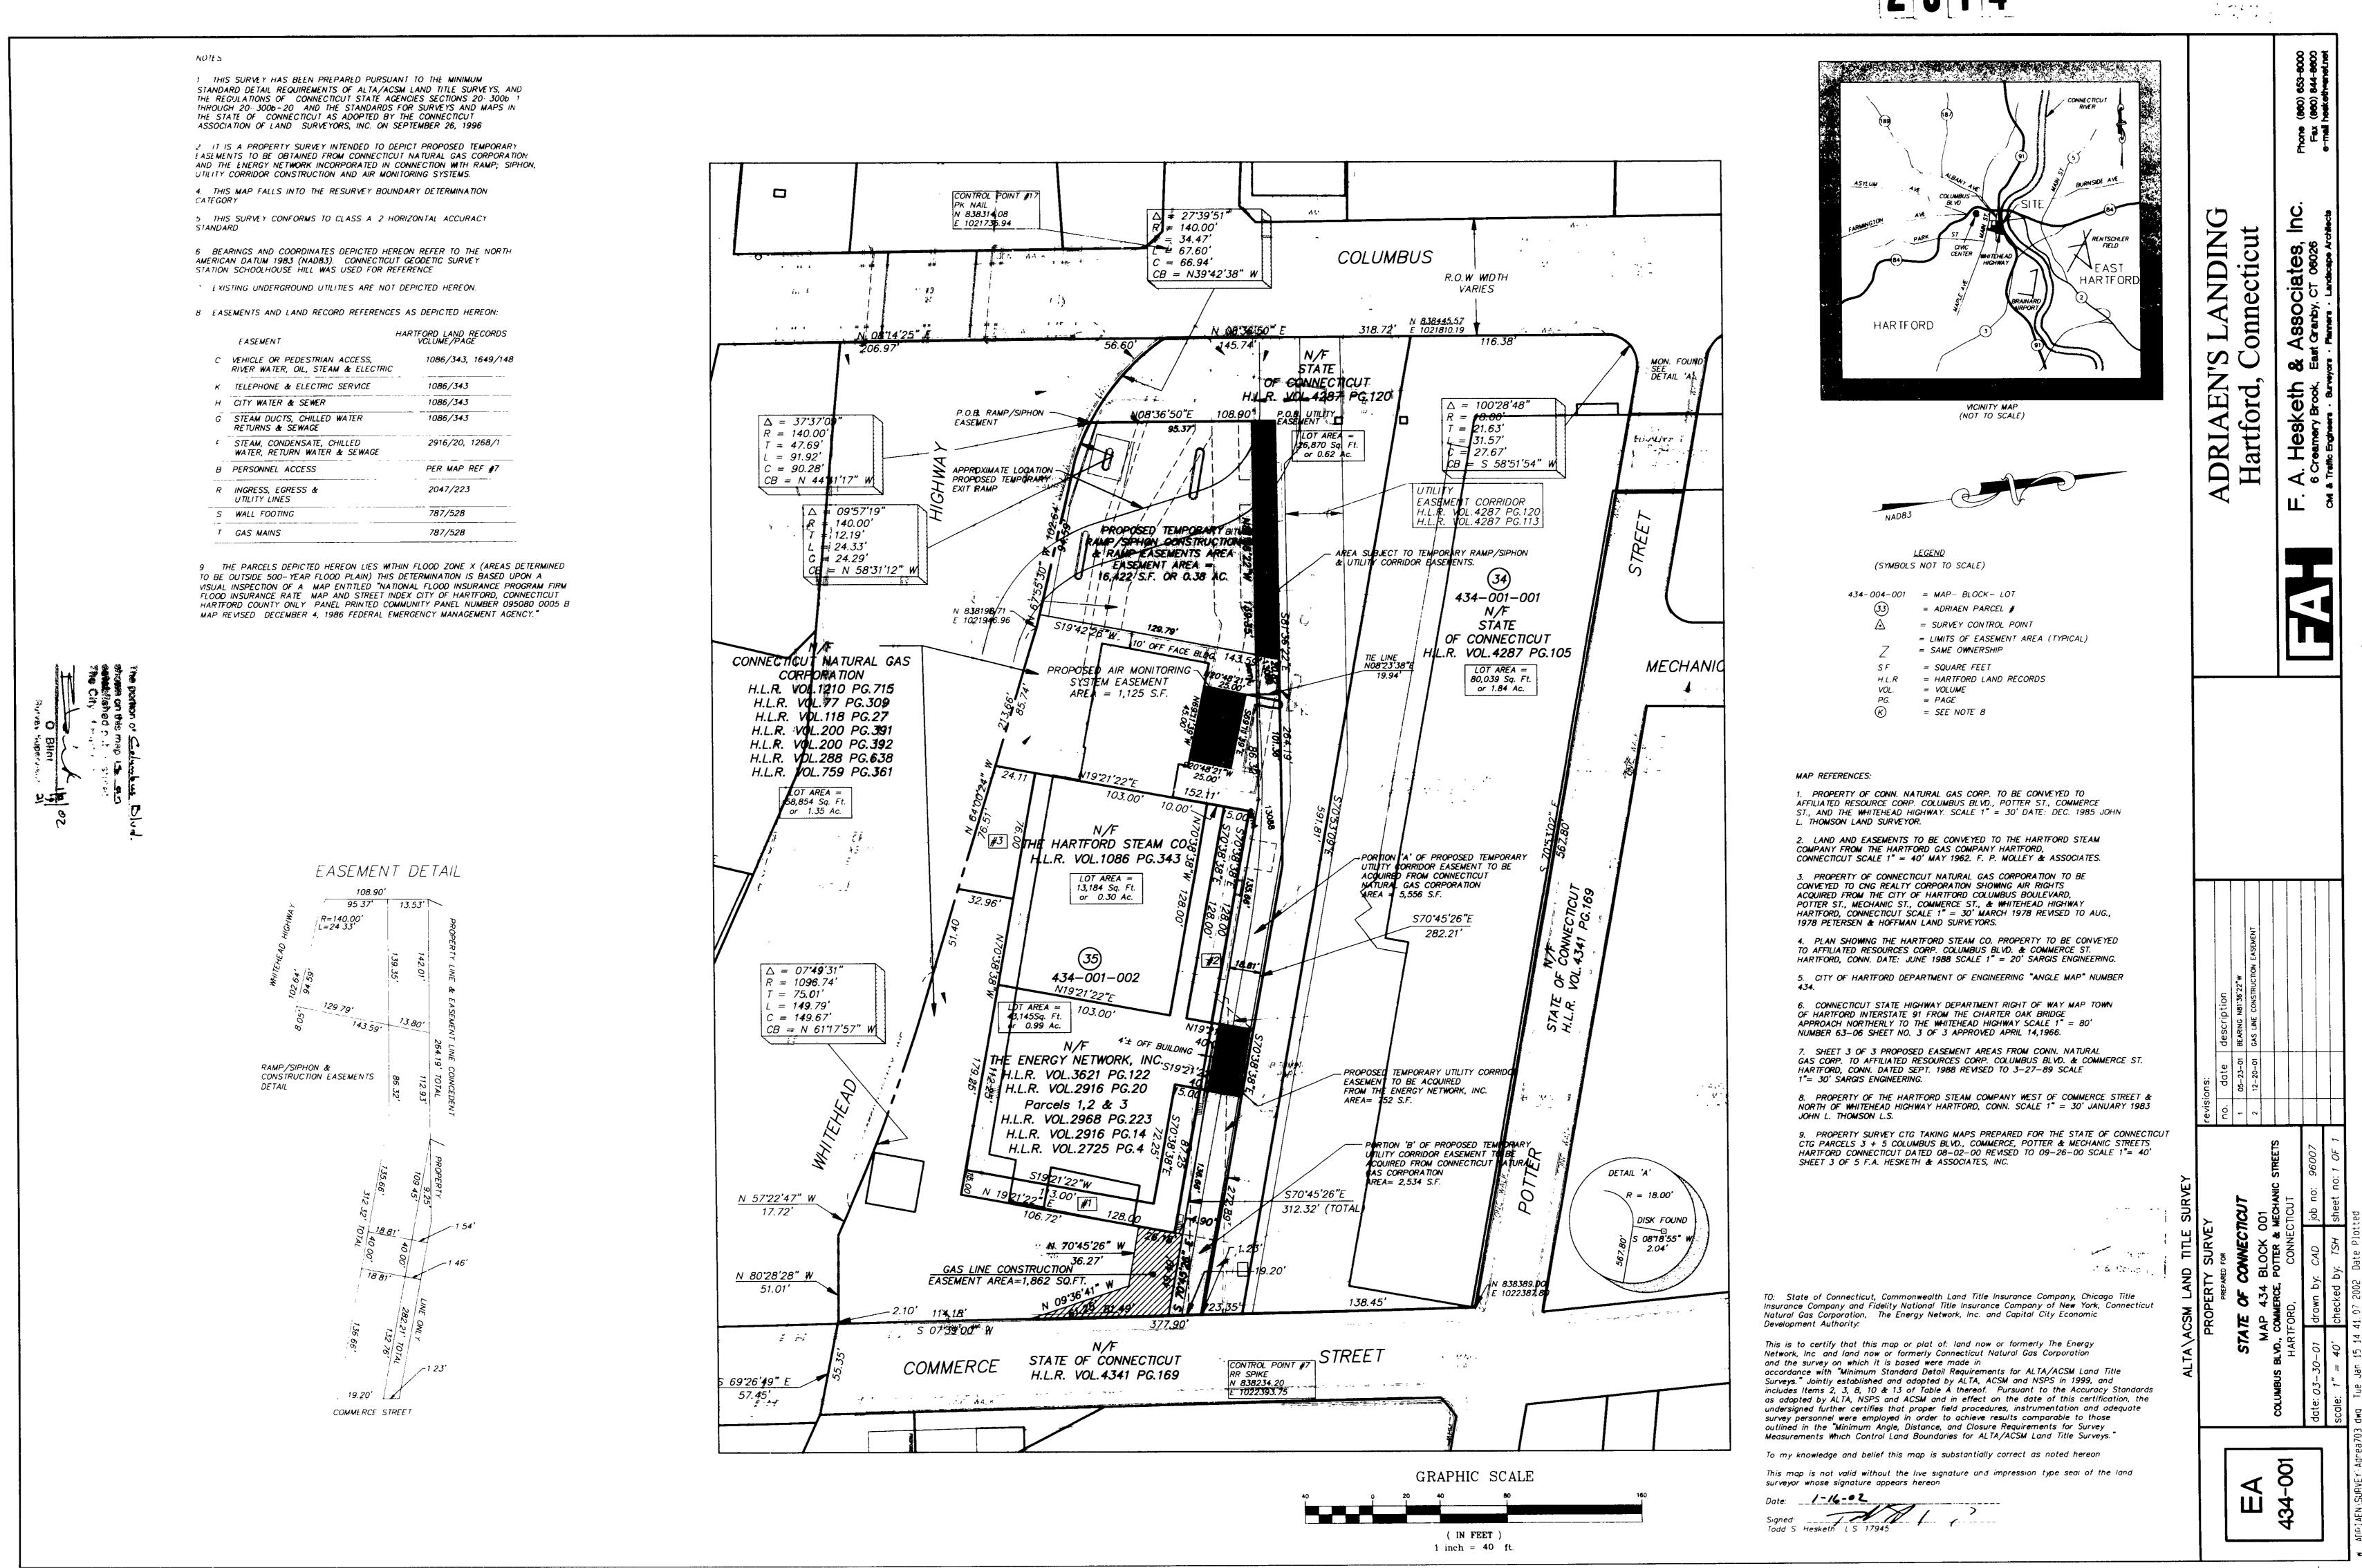

EASI FILE CORP INTINE, CA EFH 34
25/4