



2524

162524

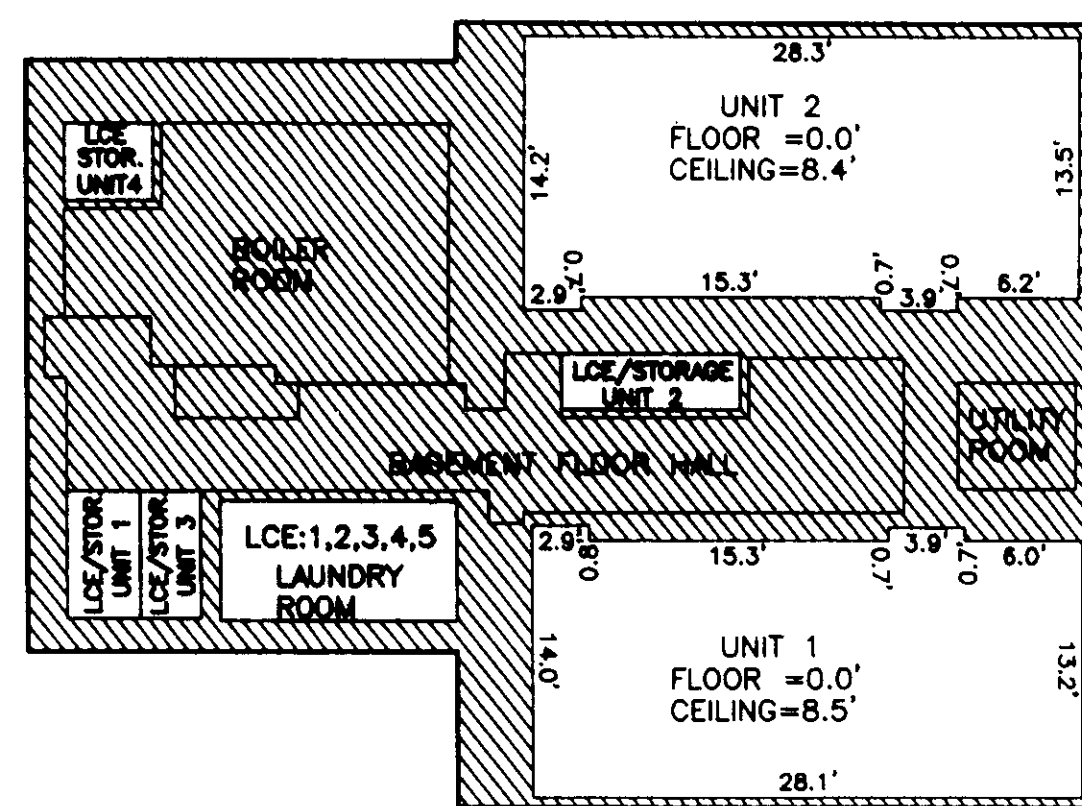


BASEMENT FLOOR PLAN

#23

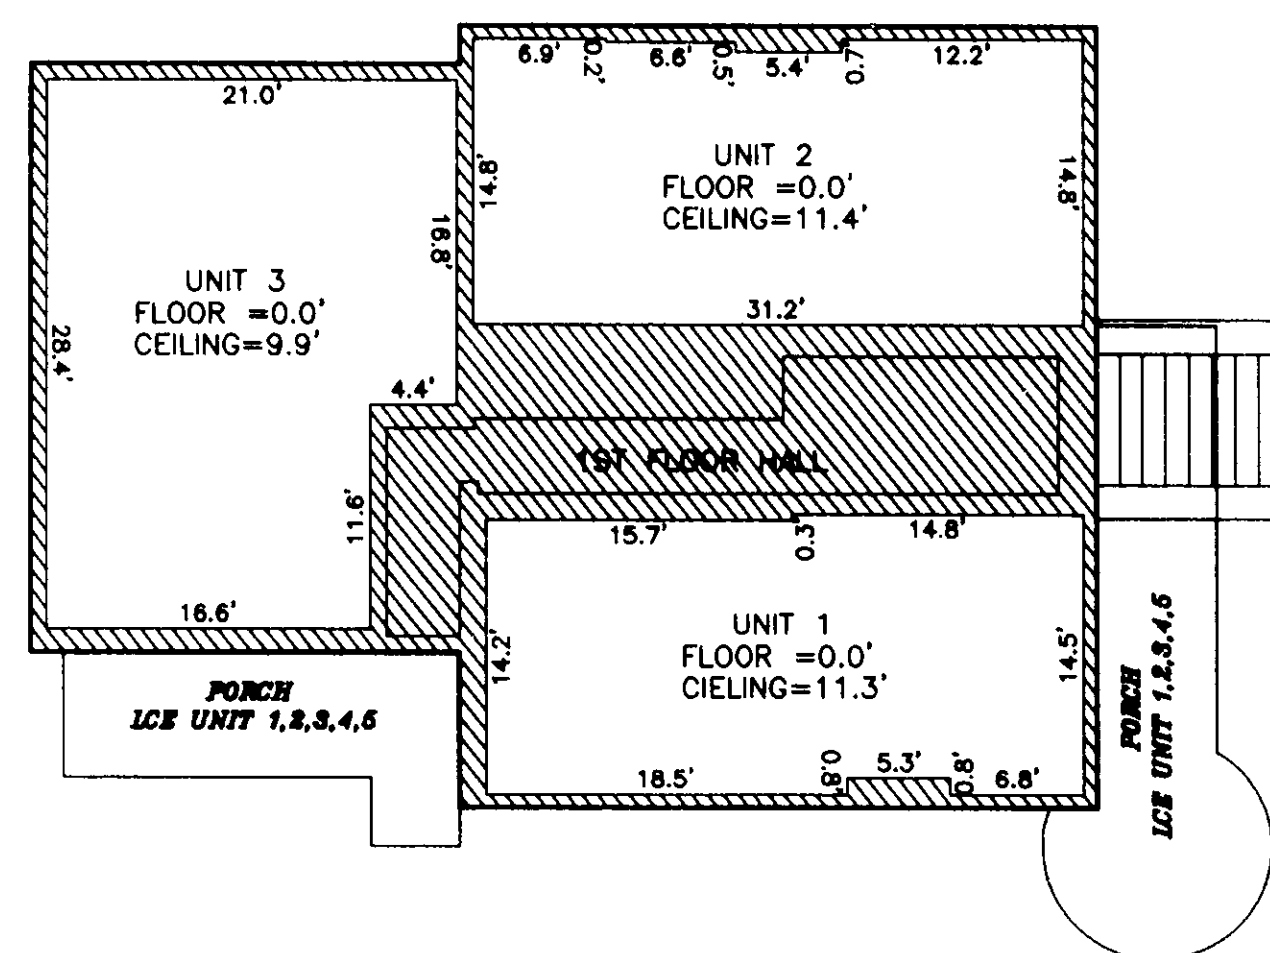


FIRST FLOOR PLAN

#23

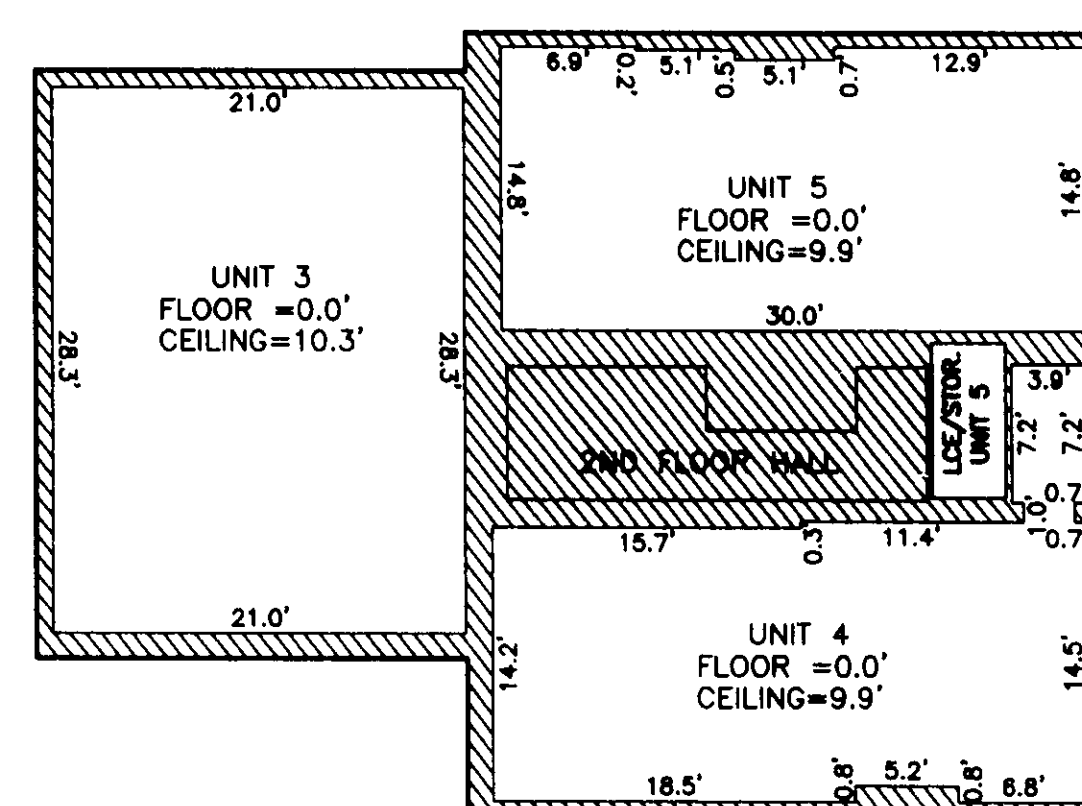

SECOND FLOOR PLAN

#23

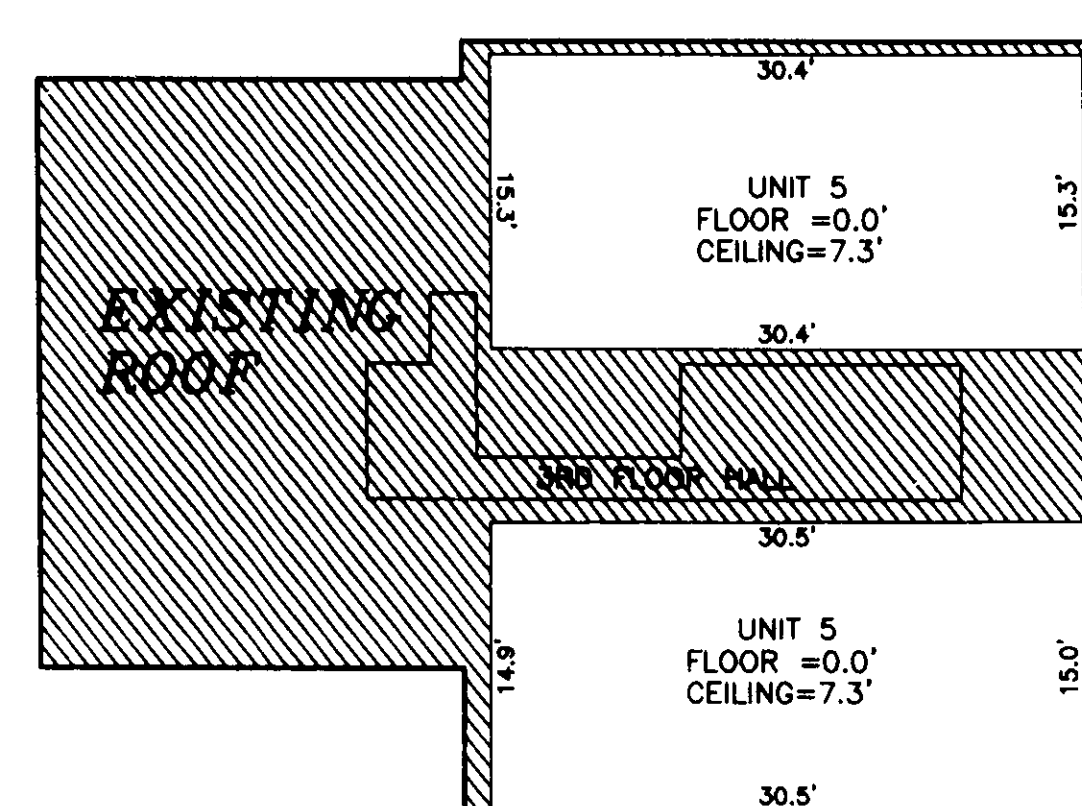


THIRD FLOOR PLAN

#23


NOTES FOR #23

DIMENSION SHOWN ON THIS PLAN TAKEN
FROM MAP SHOWING BOUNDARY RESURVEY OF CONDOMINIUM
ON THE PLACE II, EXHIBIT A-4 28 CHARTER OAK PLACE, HARTFORD, CT.
BY: Aeschliman Land Surveying, DATE: 1-5-93.

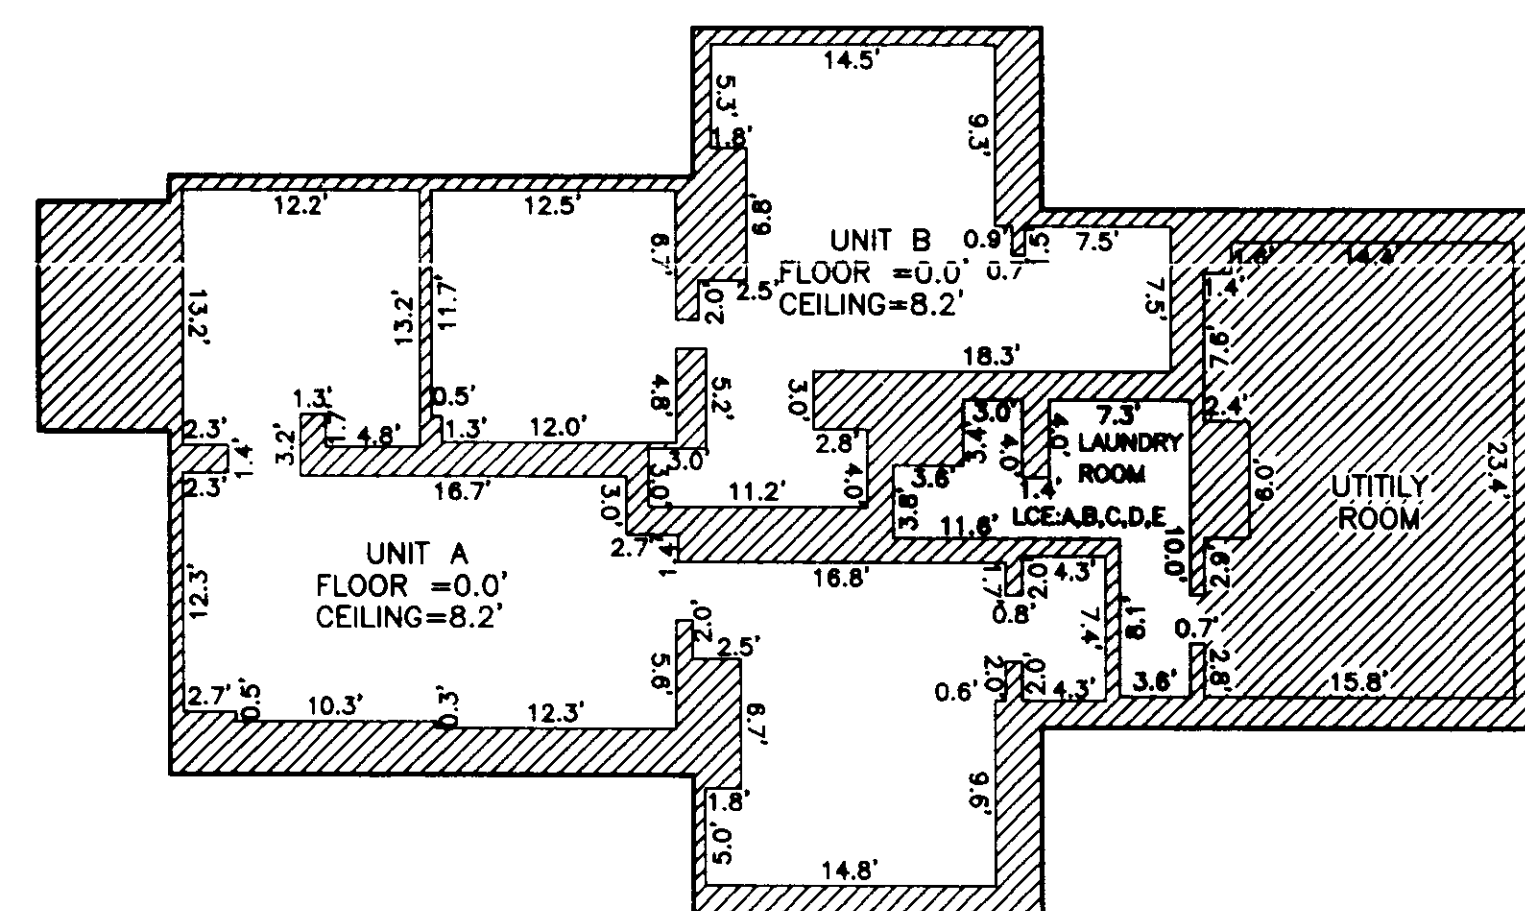


BASEMENT FLOOR PLAN

#27

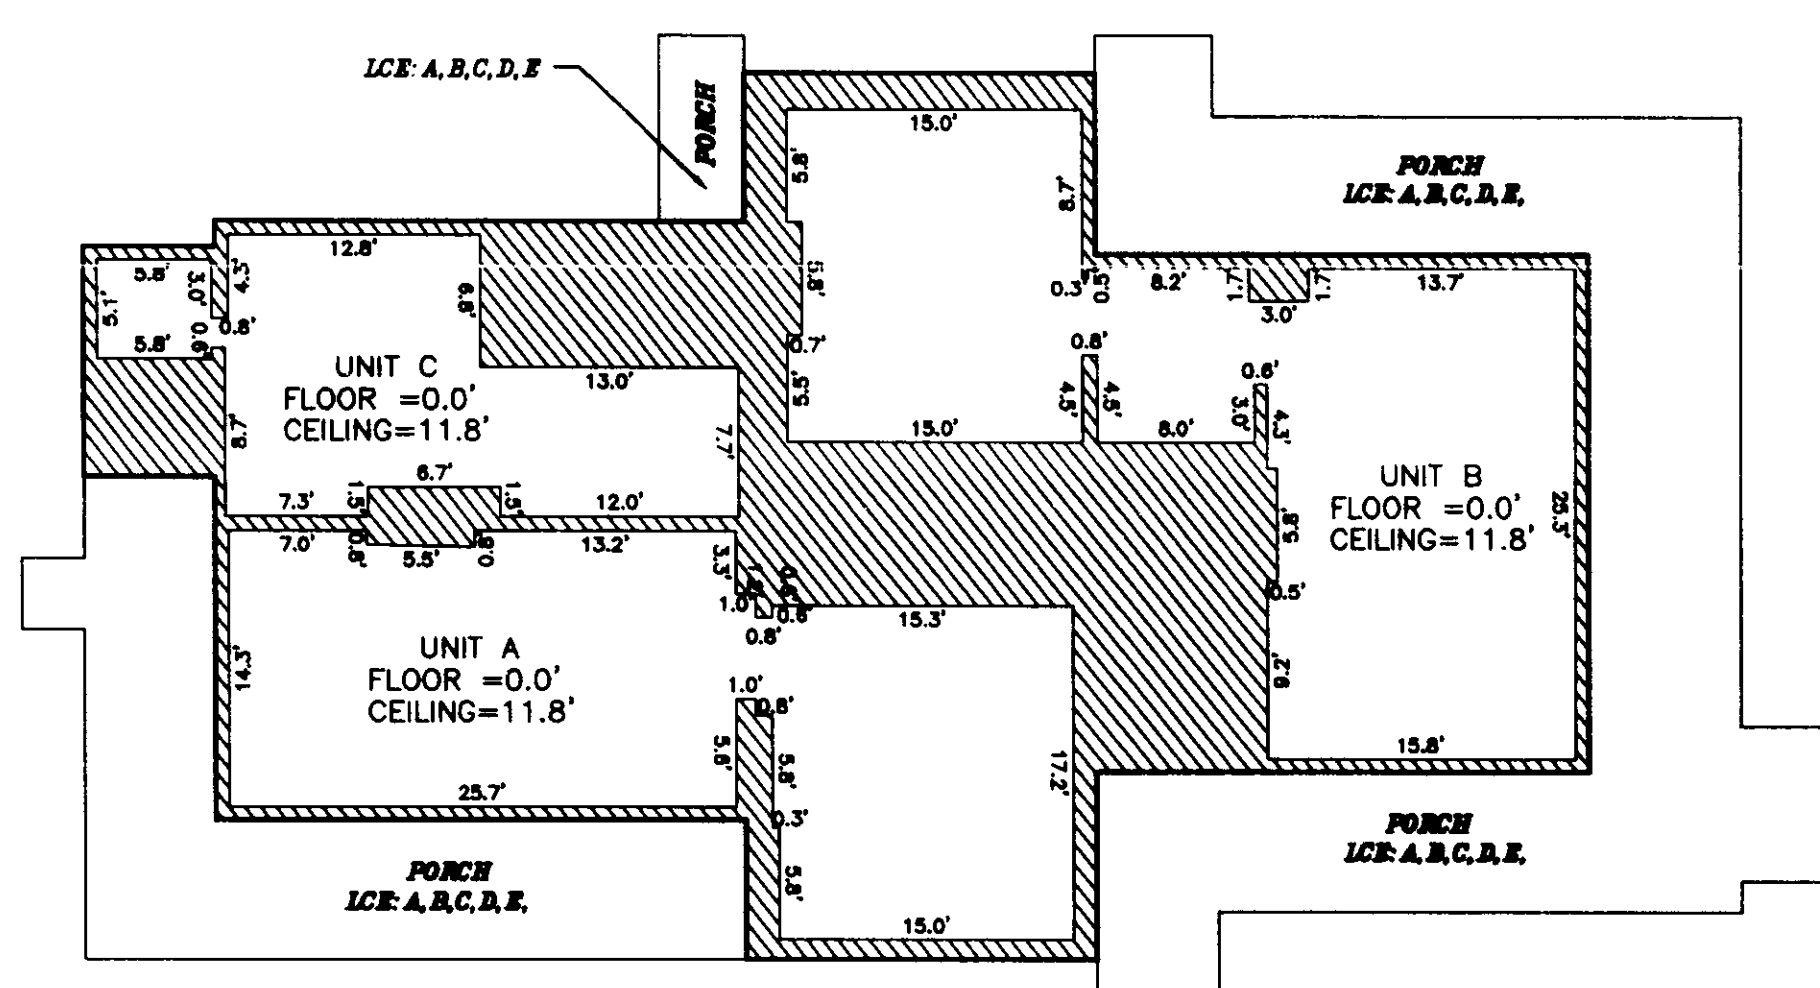

FIRST FLOOR PLAN

#27

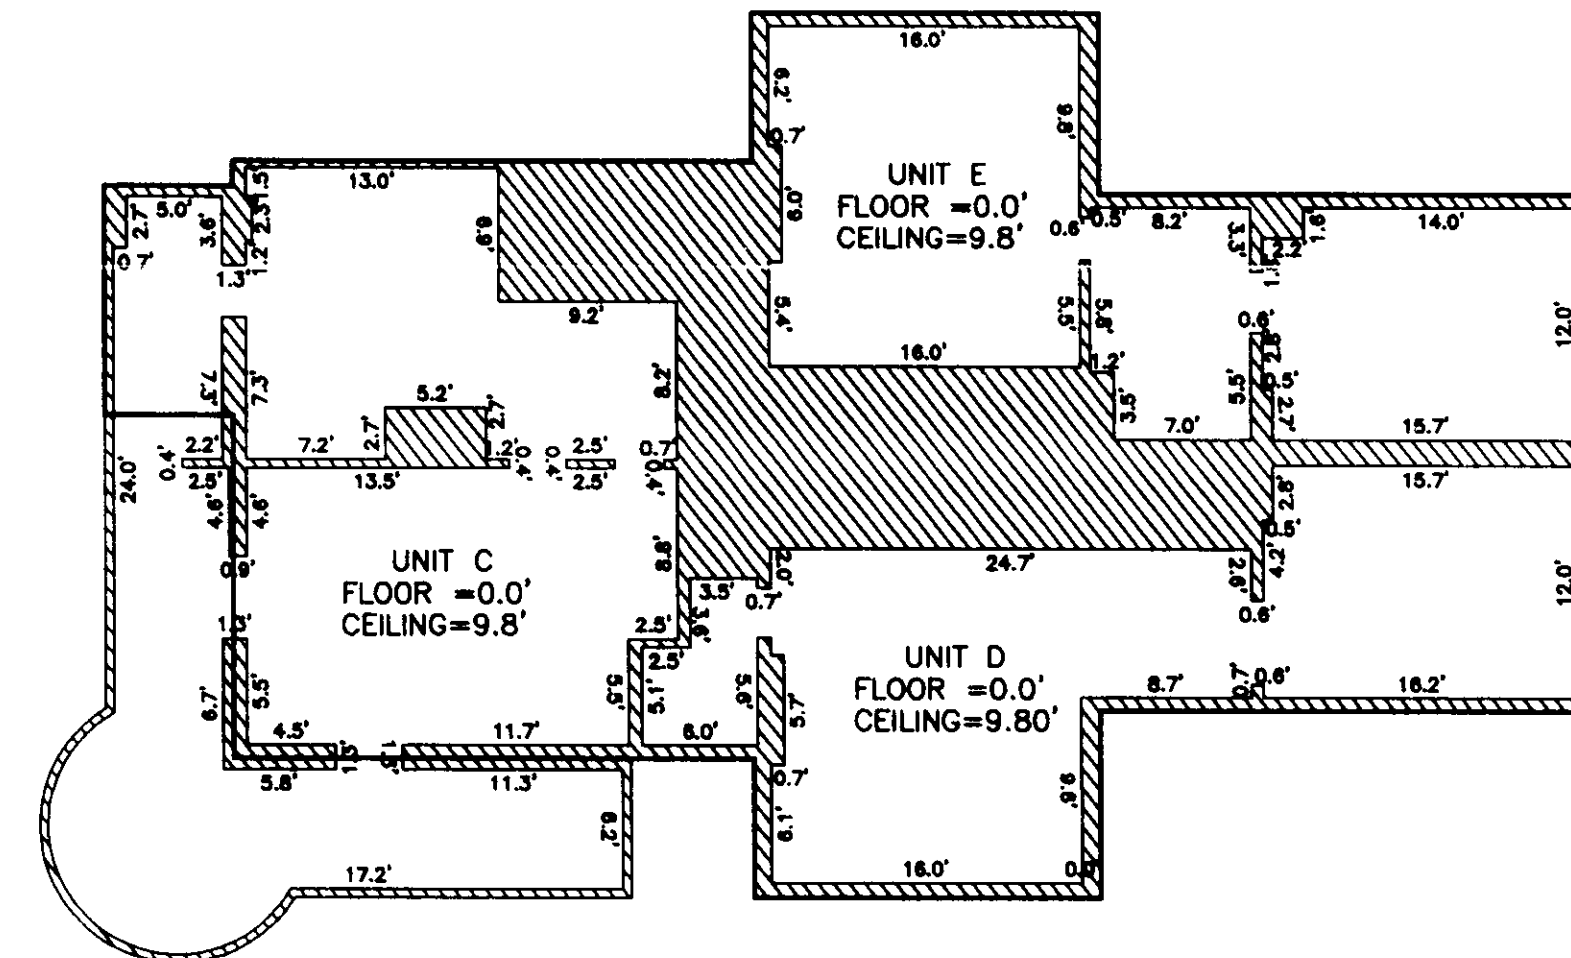

SECOND FLOOR PLAN

#27

NOTES FOR #27


DIMENSIONS SHOWN ON PLAN TAKEN FROM PLANS ENTITLED
GATLING MANSION LIMITED PARTNERSHIP EXHIBIT D 27 CHARTER OAK PLACE
HARTFORD, CT. BY: JEFFERY BAILY

INFORMATION SHOWN ON THIS PLAN CONTAINS ALL
INFORMATION REQUIRED OF PLANS UNDER SECTION
47-228 OF THE GENERAL STATUTES OF CONNECTICUT
REVISED TO JANUARY 1, 1987

RICHARD MEEHAN, L.L.S. 12330

LEGEND

LIMITED COMMON ELEMENT
COMMON ELEMENT

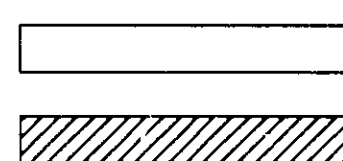

NOTE: THIS DRAWING IS AN INSTRUMENT OF SERVICE. IT IS THE PROPERTY OF MEEHAN & GOODIN, INC. AND SHALL NOT BE REPRODUCED OR TRANSMITTED IN ANY FORM OR BY ANY MEANS, ELECTRONIC OR MECHANICAL, INCLUDING PHOTOCOPYING, RECORDING, OR BY ANY INFORMATION STORAGE AND RETRIEVAL SYSTEM, WITHOUT THE WRITTEN PERMISSION OF MEEHAN & GOODIN, INC.	
MEEHAN & GOODIN, INC. Engineers - Surveyors, P.C. 387 North Main Street, Manchester, CT 06040 (860) 643-2520 FAX (860) 649-8806	
DATE	REVISION
PLAN PREPARED FOR GATLING ARMS CONDOMINIUM HARTFORD, CONN.	
PROJ: 01-188	SHEET NO. 2 OF 2
DATE: MAY 17, 2001	SCALE: N.T.S.
DRAWN: JFS	DESIGN: JFS
23-27 CHARTER OAK PLACE HARTFORD, CT.	
EXHIBIT A - 4 UNIT PLANS	

0 INCHES 1 2 3 4

2524