
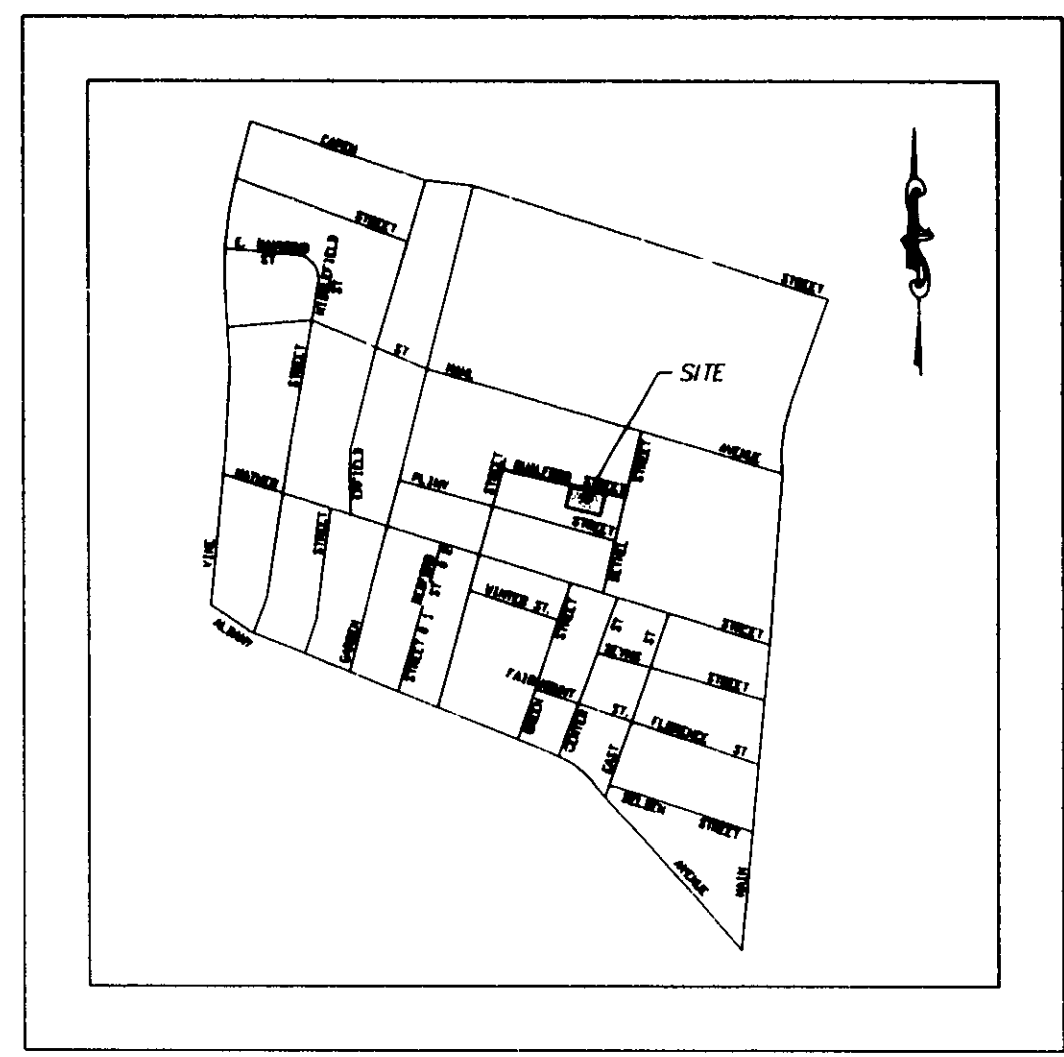


Guilford St
15' W
Plot 2/2/02

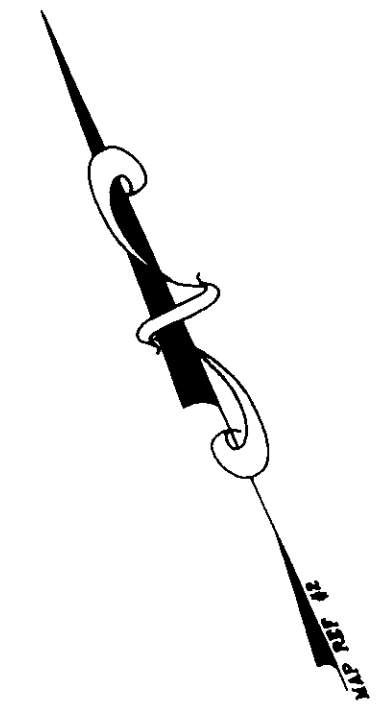

VICINITY MAP
(NOT TO SCALE)

GUILFORD STREET

BETHEL STREET

