


EASI FILE CORP. IRVINE, CA EPM 34
2548

2548

#2548

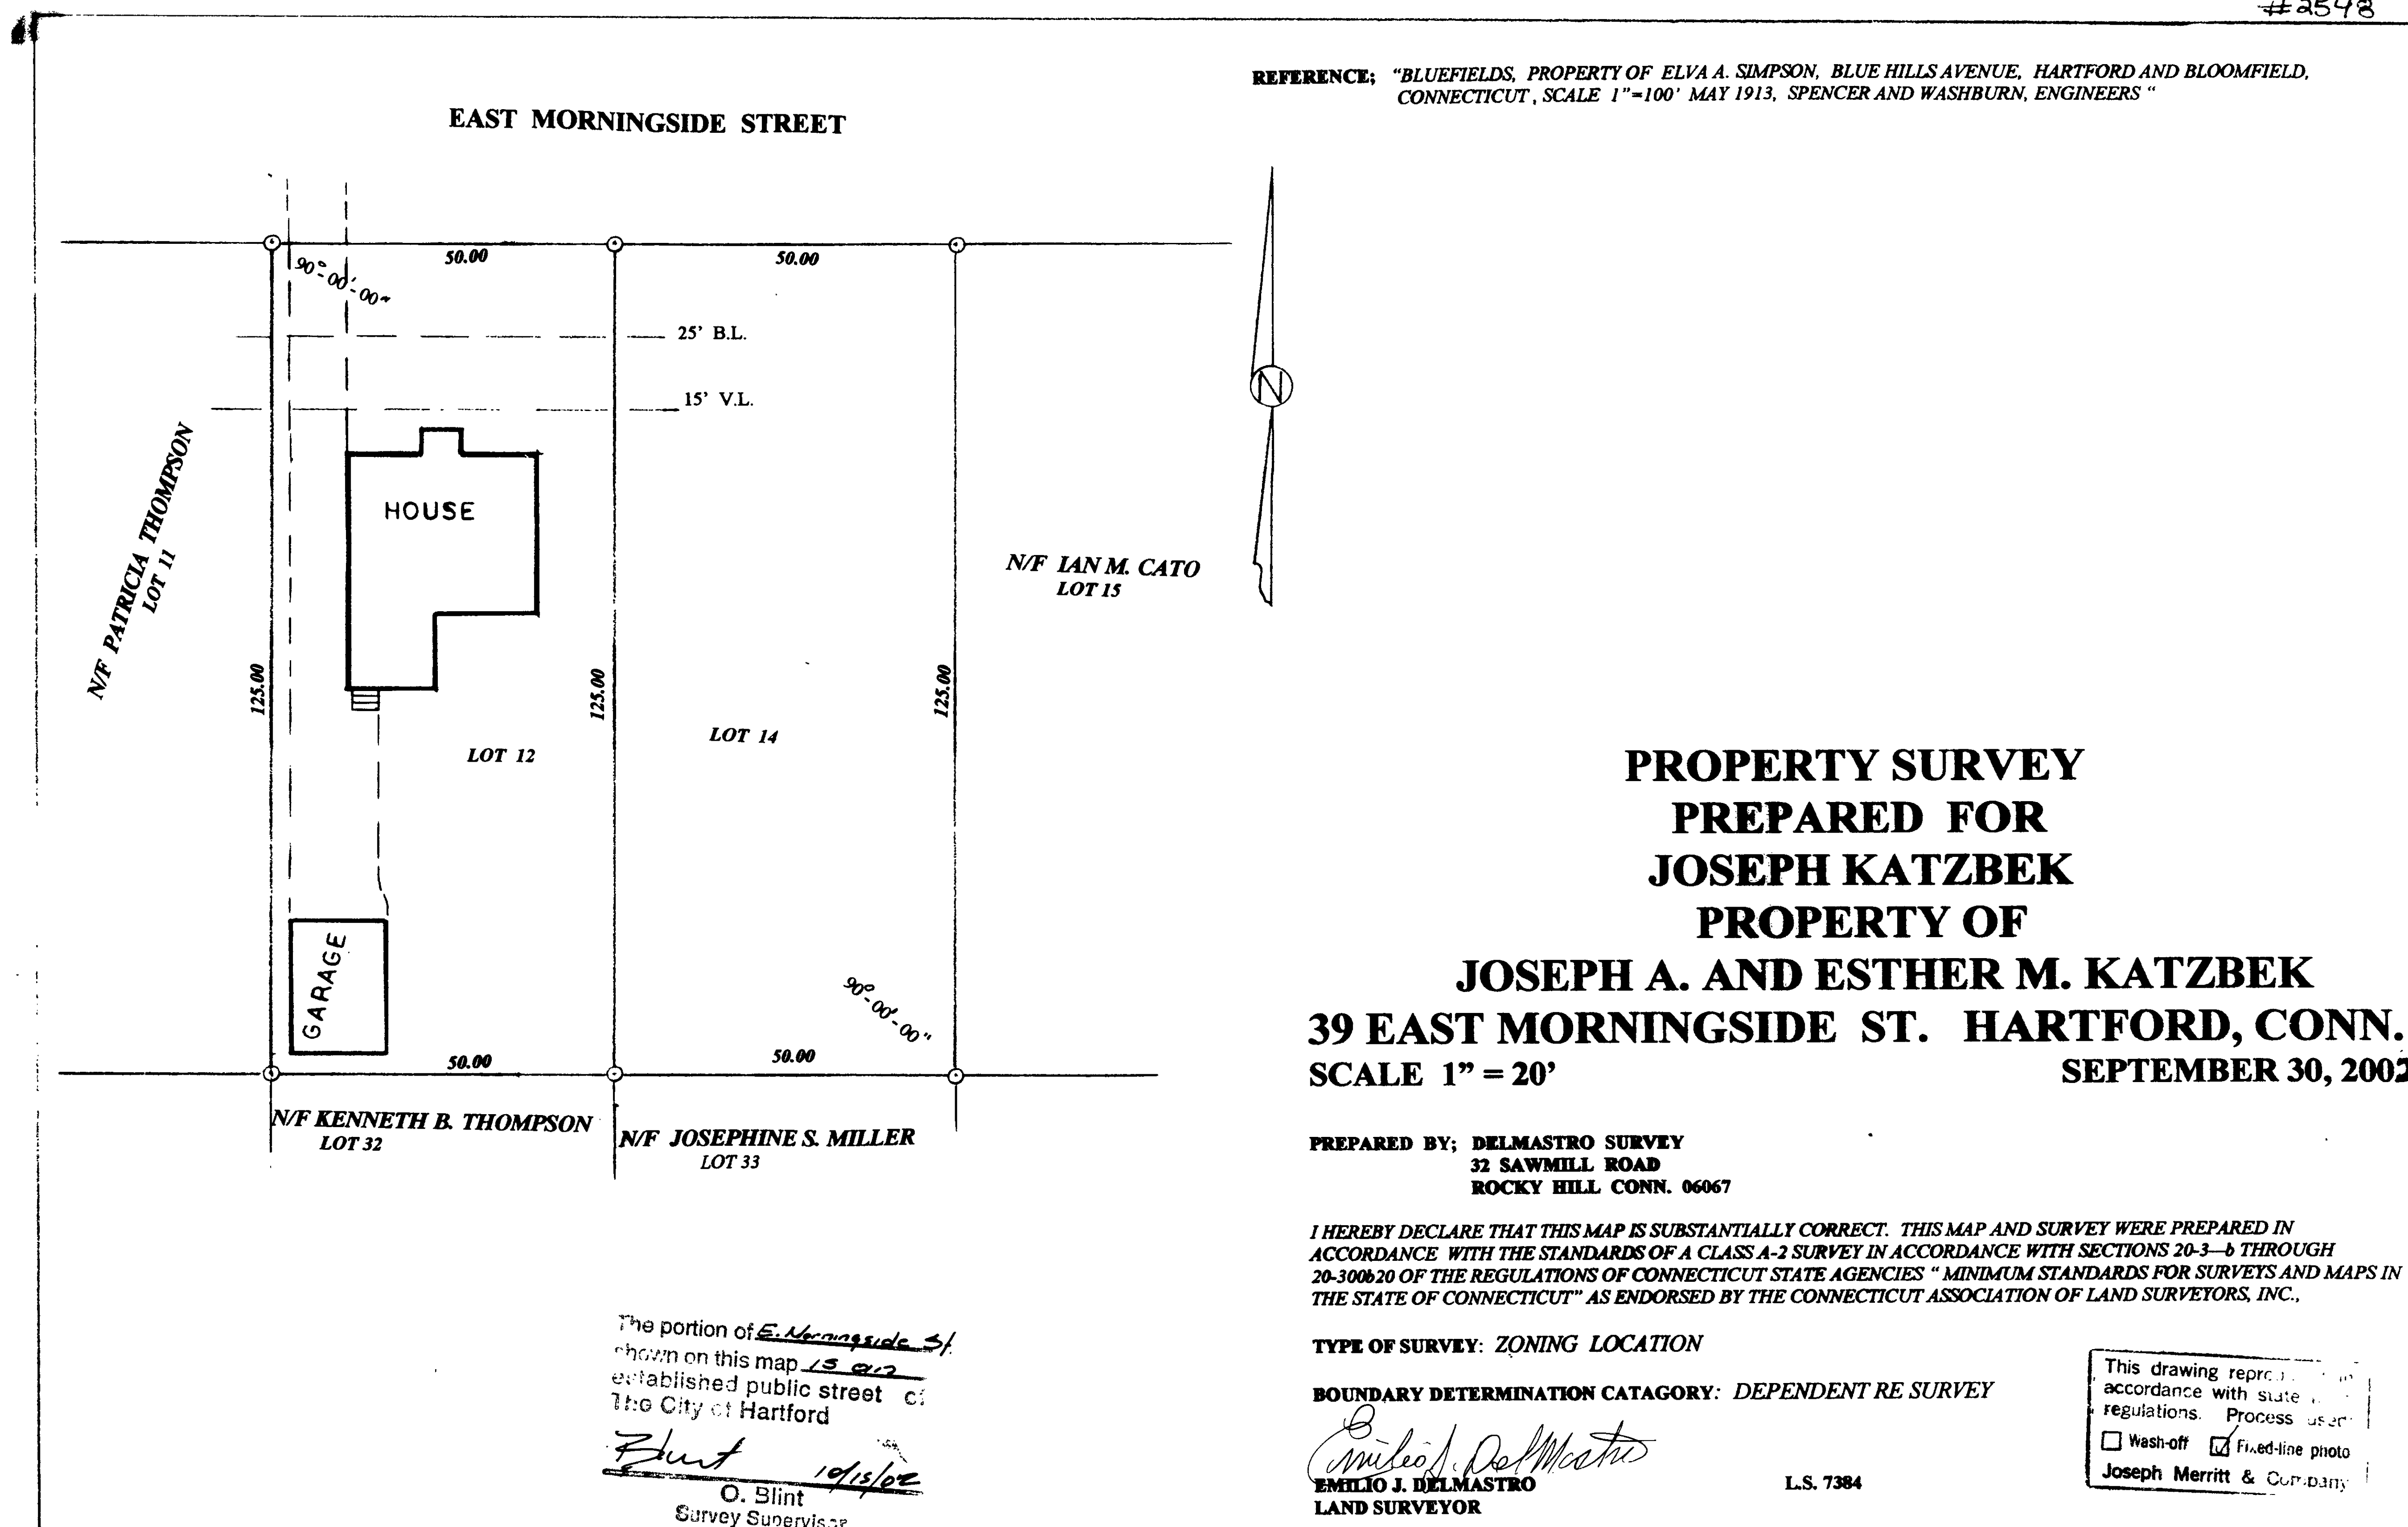

0 INCHES 1 2 3 4 #2548