


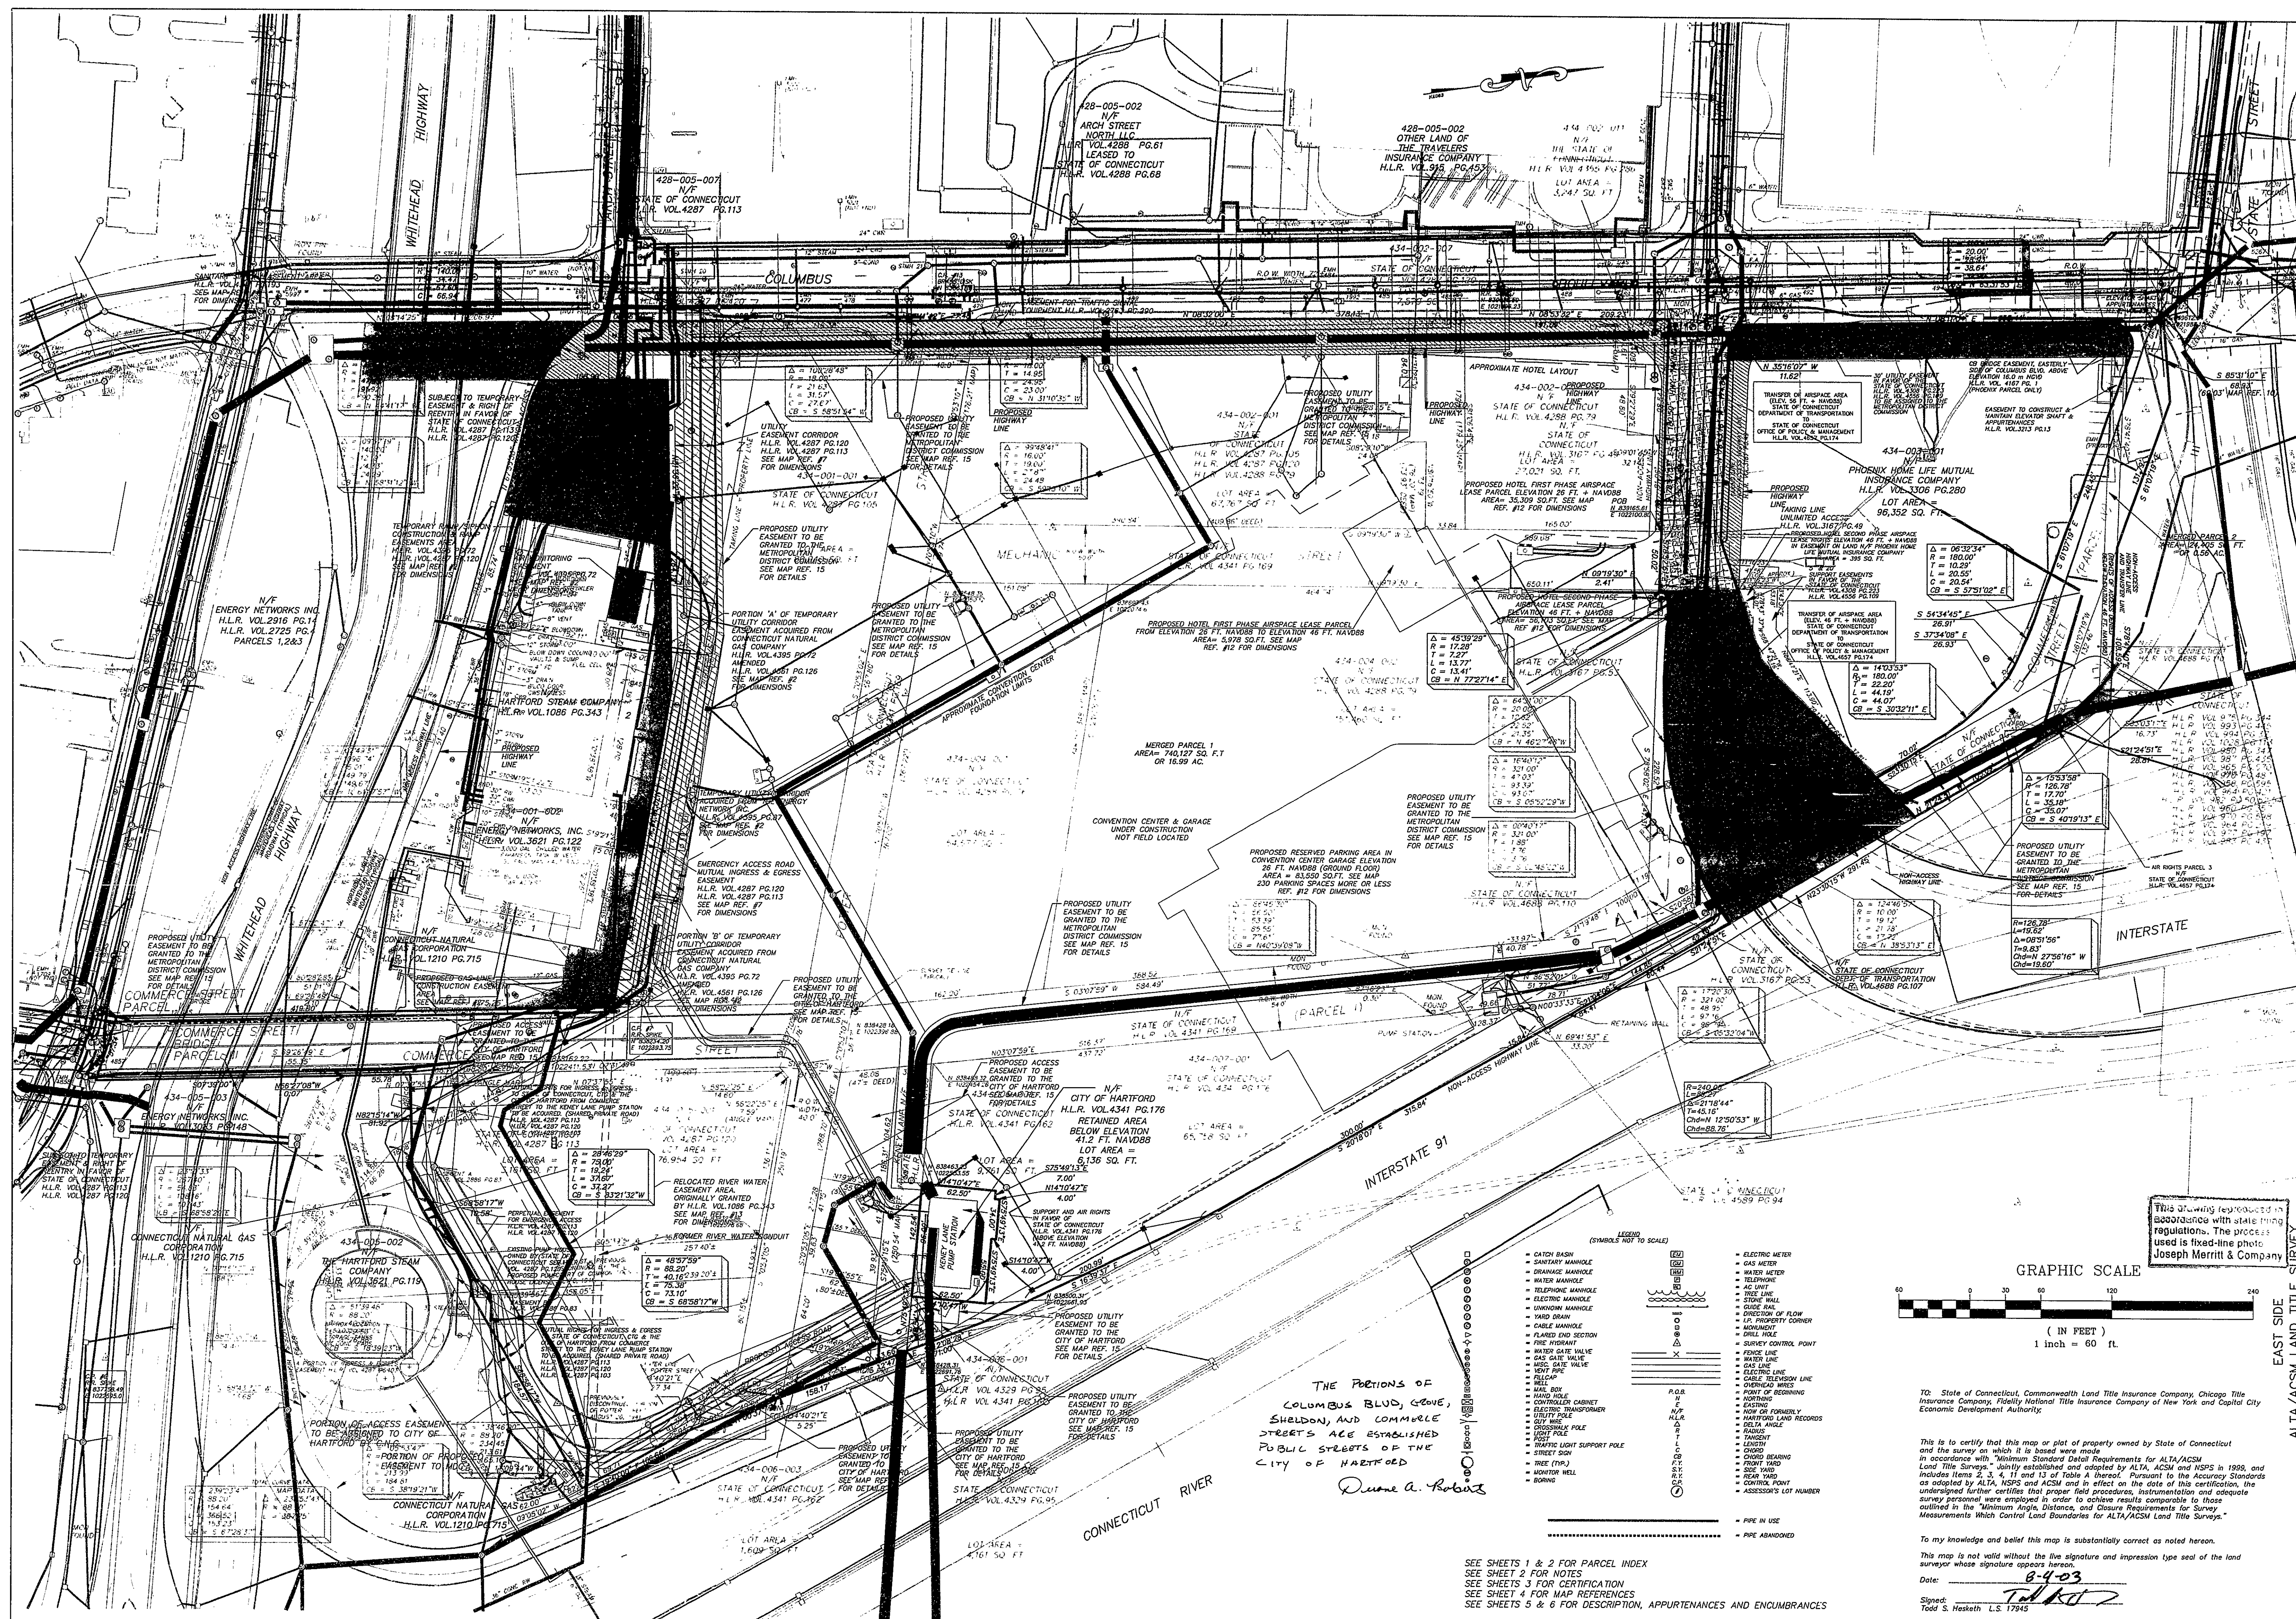

Phone (860) 653-8000
Fax (860) 844-8600
e-mail heeketh@anet.net

F. A. Hesketh & Associates, Inc.
6 Creamery Brook, East Granby, CT 06026
Civil & Traffic Engineers • Surveyors • Planners • Landscape Architects

[illegible]

PERIMETER SURVEY
PREPARED FOR
ADRIAEN'S LANDING

ALTA

#2609 - 3