


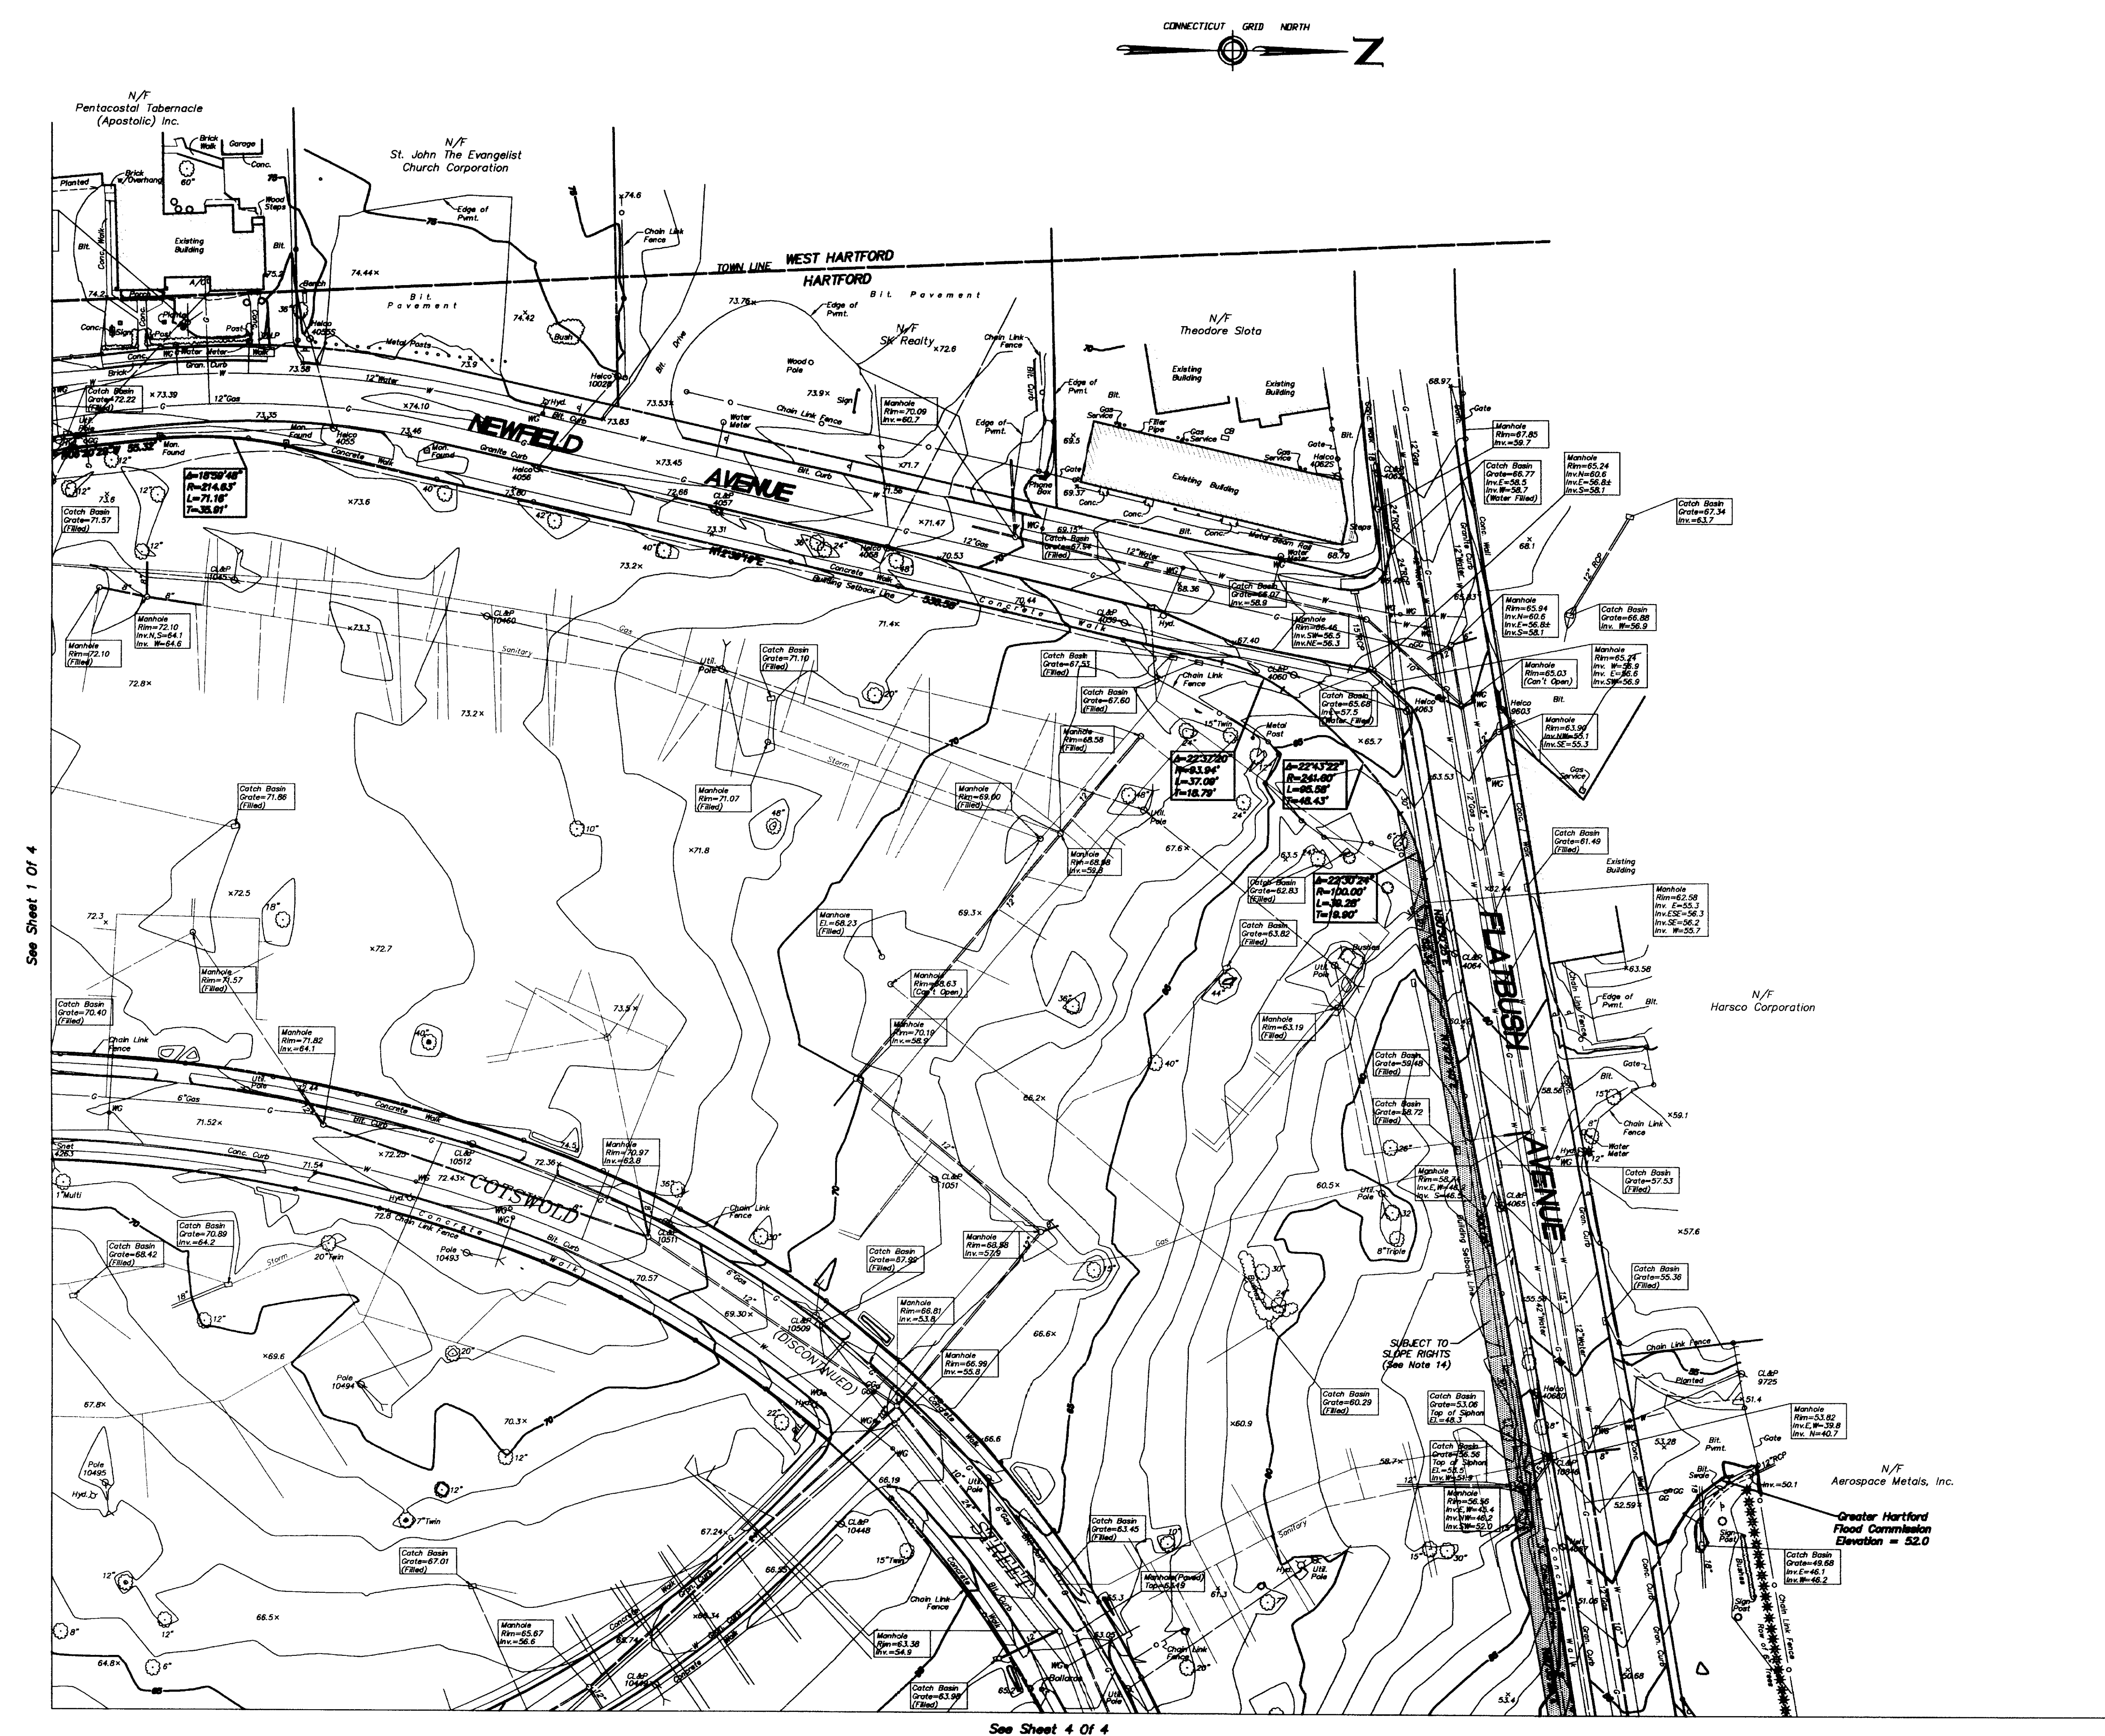

PROPERTY & TOPOGRAPHIC SURVEY
ALTA/ACSM LAND TITLE SURVEY
CHARTER OAK RETAIL CENTER
FLATBUSH AVENUE, OVERLOOK TERRACE & NEWFIELD STREET
HARTFORD, CONNECTICUT

THIS DRAWING WAS REPRODUCED IN
ACCORDANCE WITH STATE FILING
REGULATIONS PROCESS USED
ORIGINAL INK ON MYLAR
URS CORPORATION AES



No.	Date	Revision description
1	8-25-00	Proposed Easements Added
2	7-28-02	Partial Revised
3	5-28-02	Correction Made

TO MY KNOWLEDGE AND BELIEF THIS MAP IS
SUBSTANTIALLY CORRECT AS NOTED HEREON

[Signature]
MICHAEL R. WILSON, L.S.
TRUE AND VALID COPIES OF THIS MAP OR PLAN MUST BEAR THE ORIGINAL
SIGNATURE AND EMBOSSED SEAL OF THE ABOVE NAMED LAND SURVEYOR.
UNAUTHORIZED REPRODUCTION OR ALTERATION IS FORBIDDEN.

EMBOSSER NO. 14206

Embossed seal

URS Surveying and Mapping by URS Corporation A/E/S 500 Enterprise Drive, Suite 30 Rocky Hill, Connecticut 06067-4002 Tel. (860) 528-6882	
Scale: 1" = 40'	Project #
Date: MARCH 2002	1540-1
Field book #	F.S. & F.R.
Search #	3853
Drawn by	SK, EL
Checked by	K.C.
Map Title #	E8-20

SHEET 2 OF 4
SEE SHEET 4 FOR NOTES