



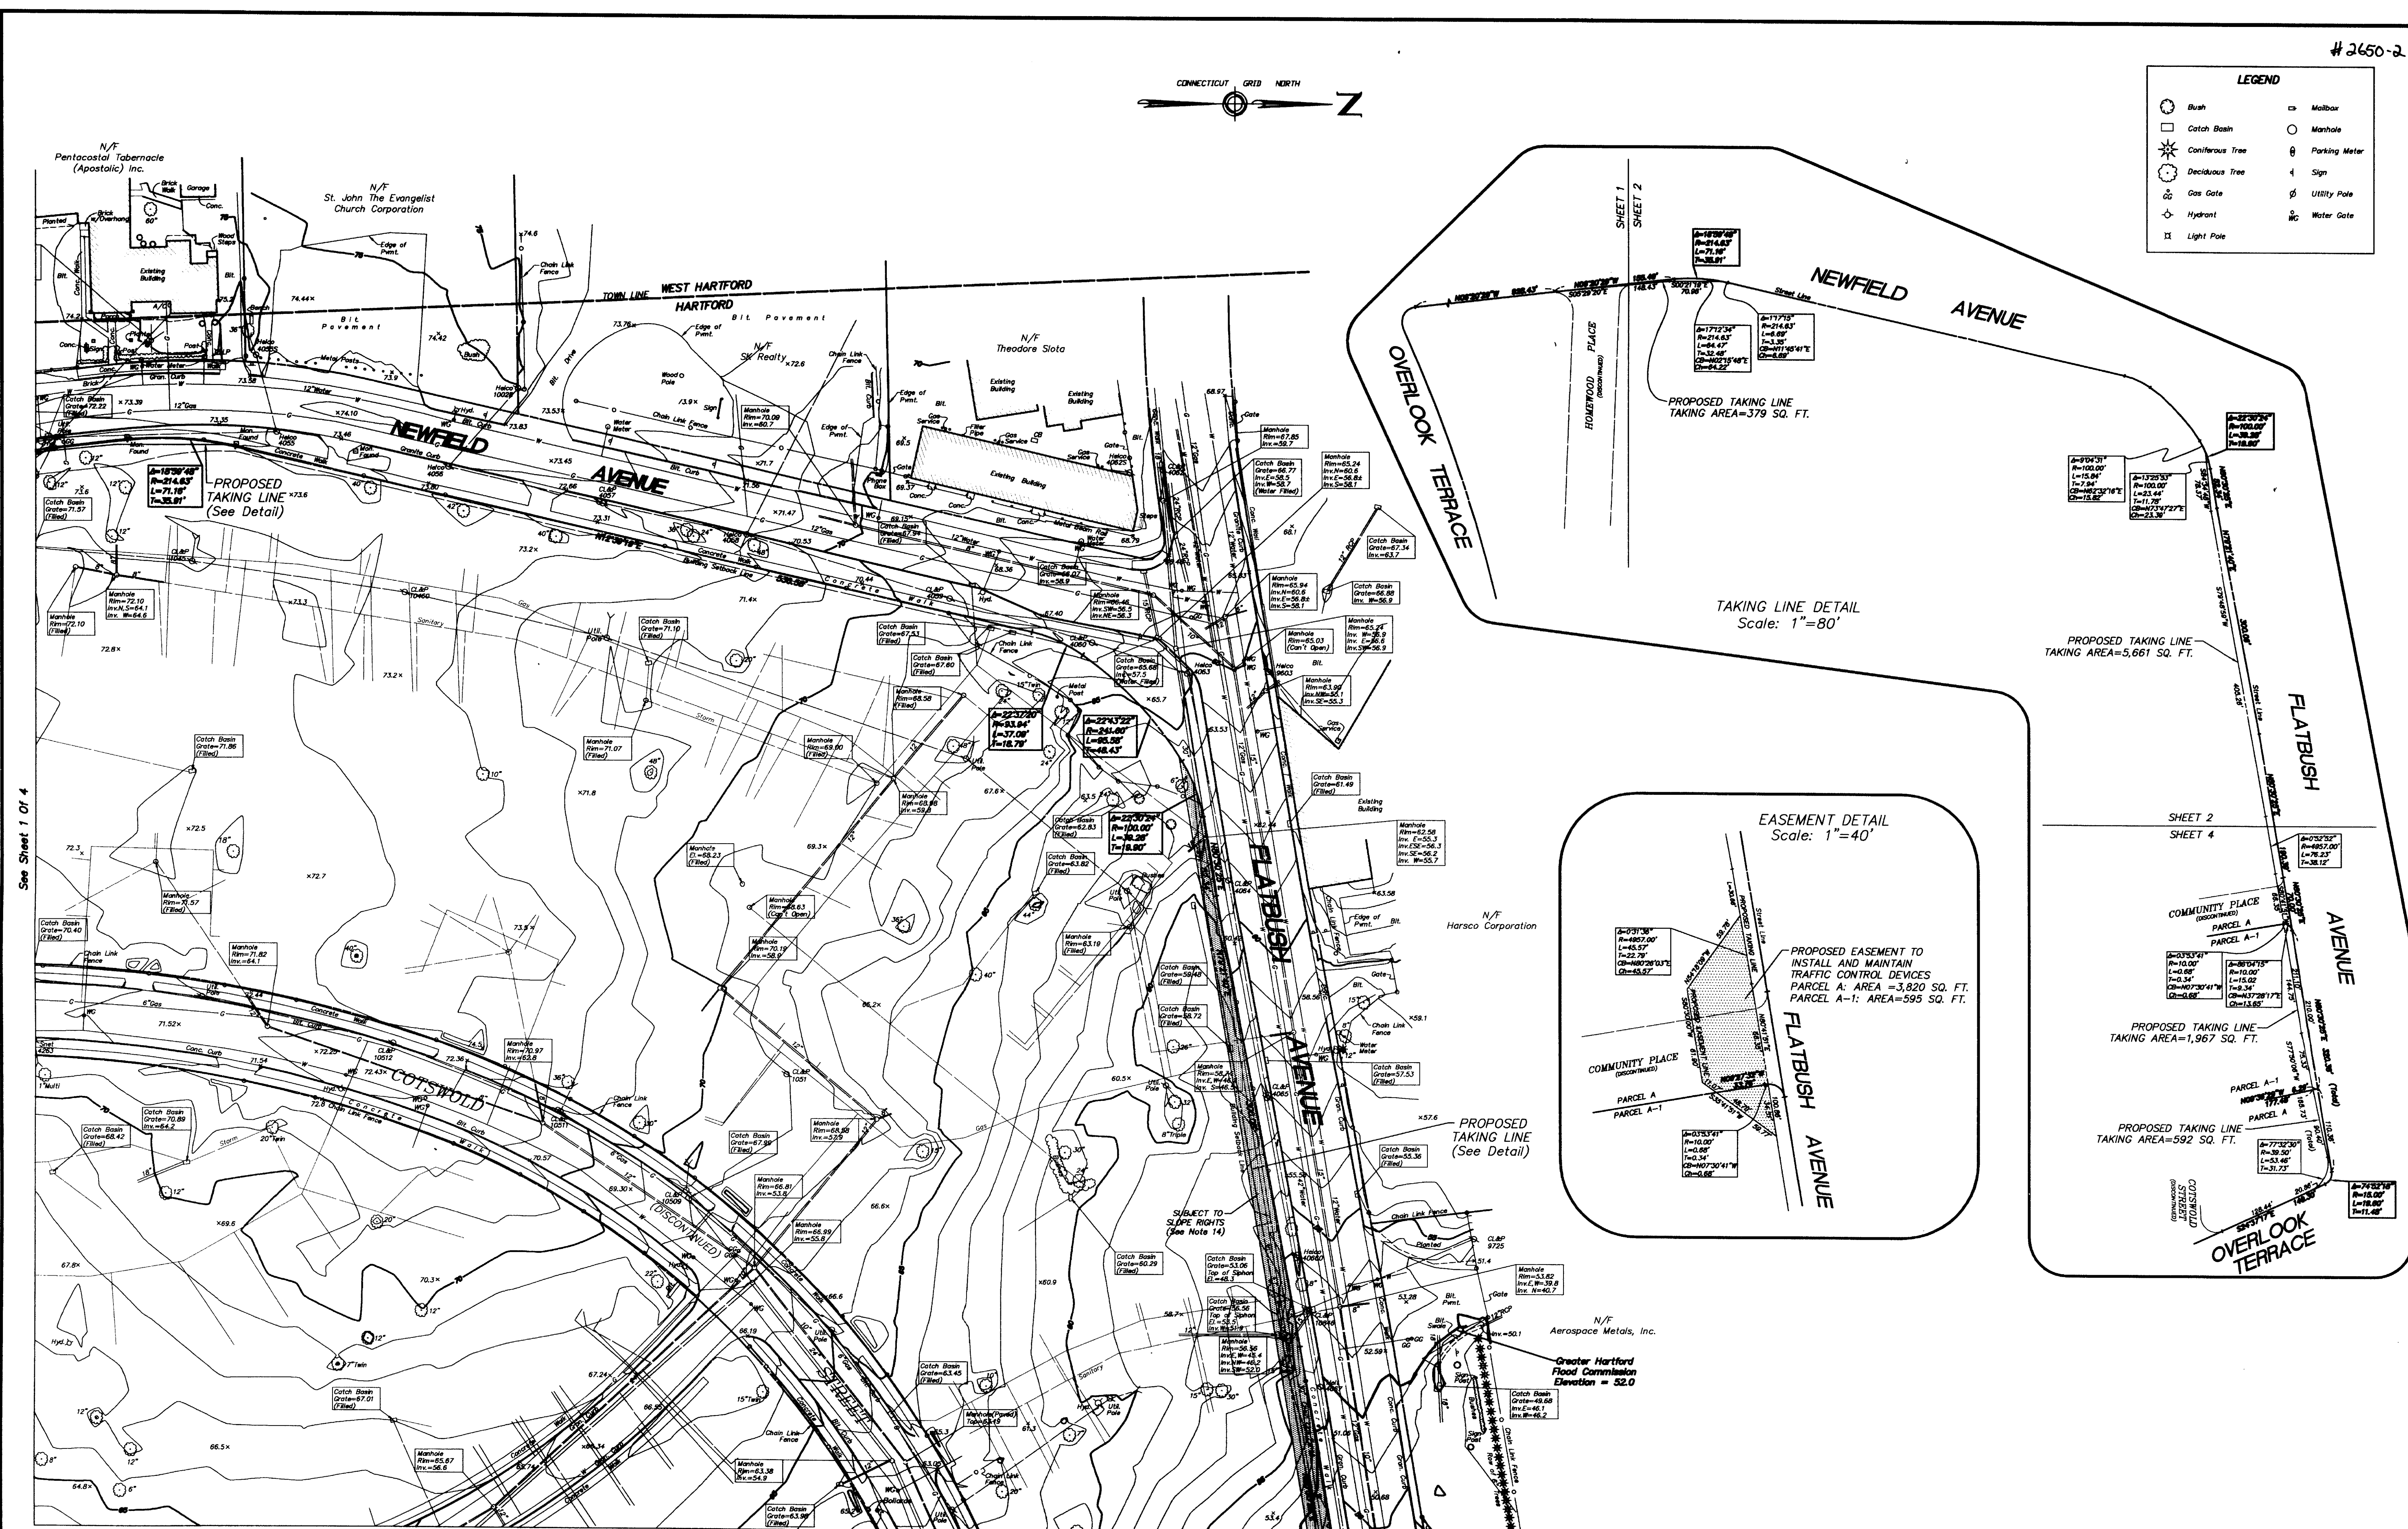

PROPERTY & TOPOGRAPHIC SURVEY
ALTA/ACSM LAND TITLE SURVEY
CHARTER OAK MARKETPLACE
FLATBUSH AVENUE, OVERLOOK TERRACE & NEWFIELD AVENUE
HARTFORD, CONNECTICUT

THIS DRAWING WAS REPRODUCED IN
ACCORDANCE WITH STATE FILING
REGULATIONS PROCESS USED
ORIGINAL INK ON MYLAR
JRS CORPORATION AES

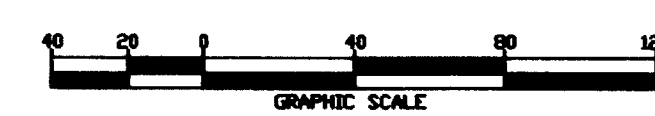

No.	Date	Revision description
1	1-23-04	Issuing Line Revised
2	7-17-05	Proposed Taking Line & Easement Added
3	8-23-05	Proposed Taking Line & Easement Added (BPP/ABP)
4	7-28-06	Proposed Easement Added (BPP/ABP)
5	5-28-06	Proposed Easement Added

TO MY KNOWLEDGE AND BELIEF THIS MAP IS
SUBSTANTIALLY CORRECT AS NOTED HEREON

[Signature]

MICHAEL G. WILKES, L.S. LICENSE NO. 14206

TRUE AND VALID COPIES OF THIS MAP OR PLAN MUST BEAR THE ORIGINAL
SIGNATURE AND UNDOUBTED SEAL OF THE ABOVE NAMED LAND SURVEYOR.
UNAUTHORIZED REPRODUCTION OR ALTERATION IS FORBIDDEN.

Embodied used

URS Surveying and Mapping by URS Corporation A-E-S 500 Enterprise Drive, Suite 30 Rocky Hill, Connecticut 06067-4002 Tel. (860) 526-8882			
Scale: 1" = 40' Date: MARCH 2002 Field book # 1540-1 Search # 3853	Crew Chief C.S. & F.R. Drawn by SK, EL Checked by [Signature]	Project # FT-00002210.00 Rep file # E9-20	

SHEET 2 OF 4
SEE SHEET 4 FOR NOTES