


2741

#2741

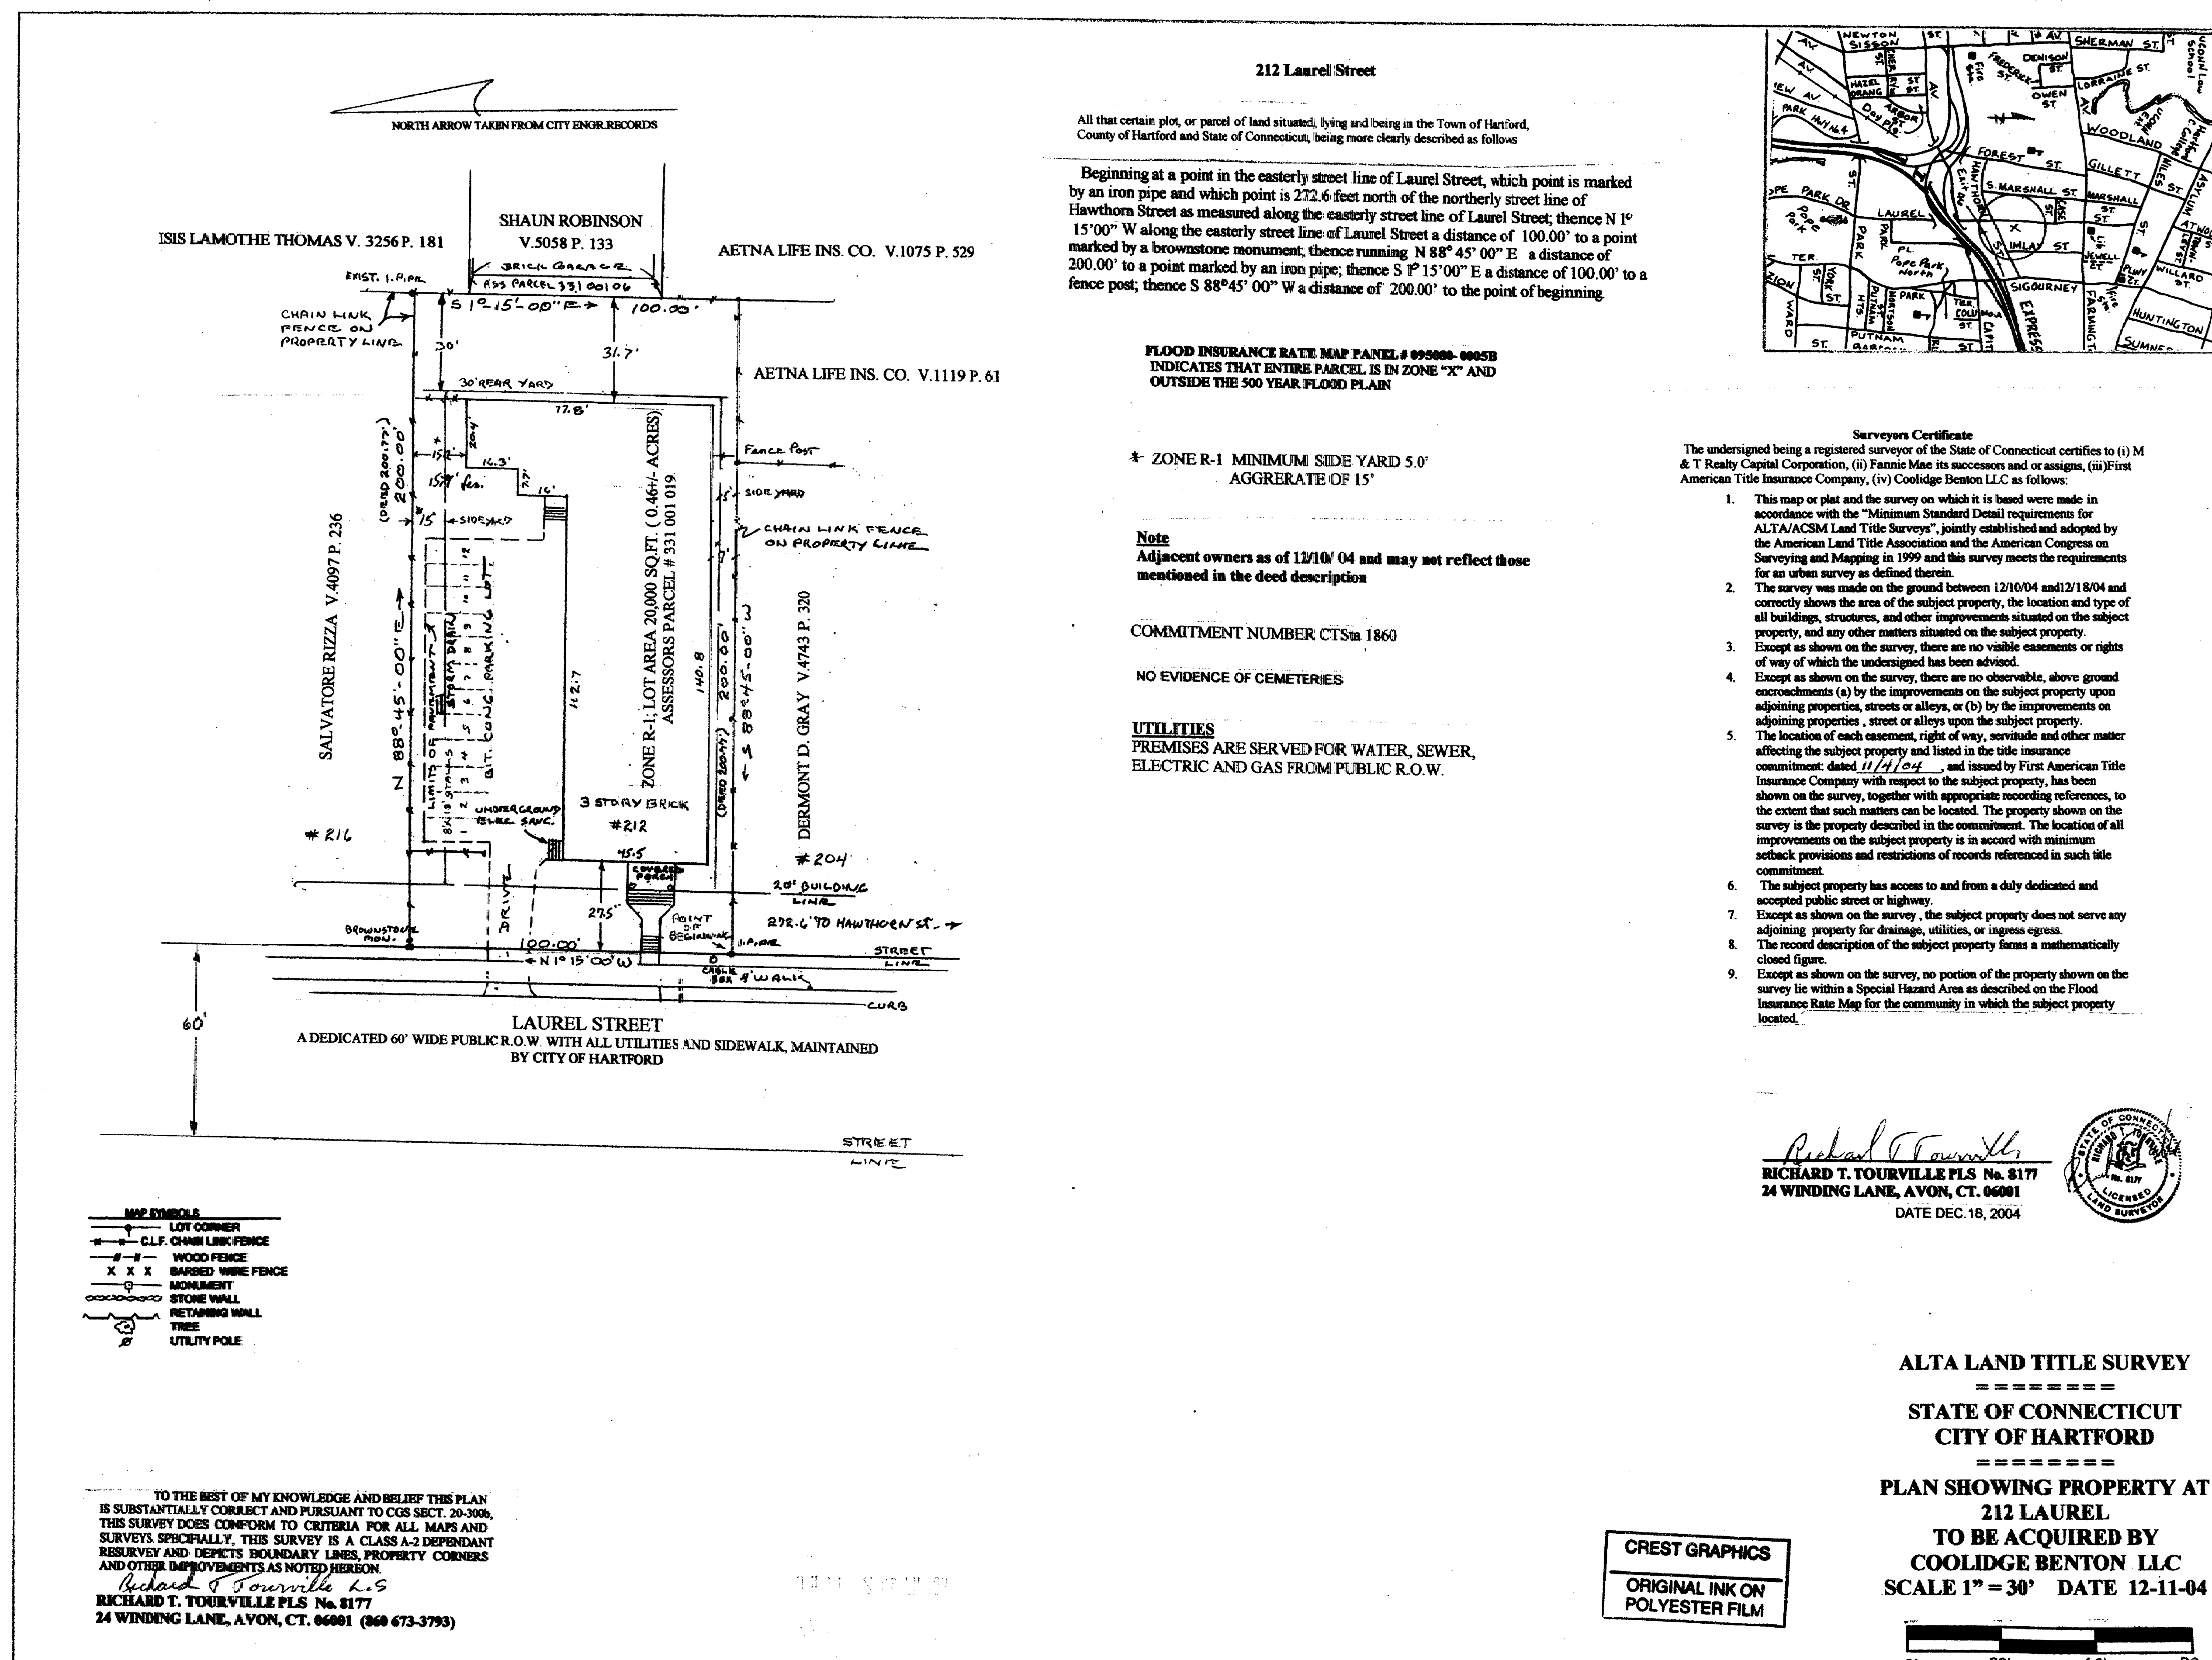

#2741

