


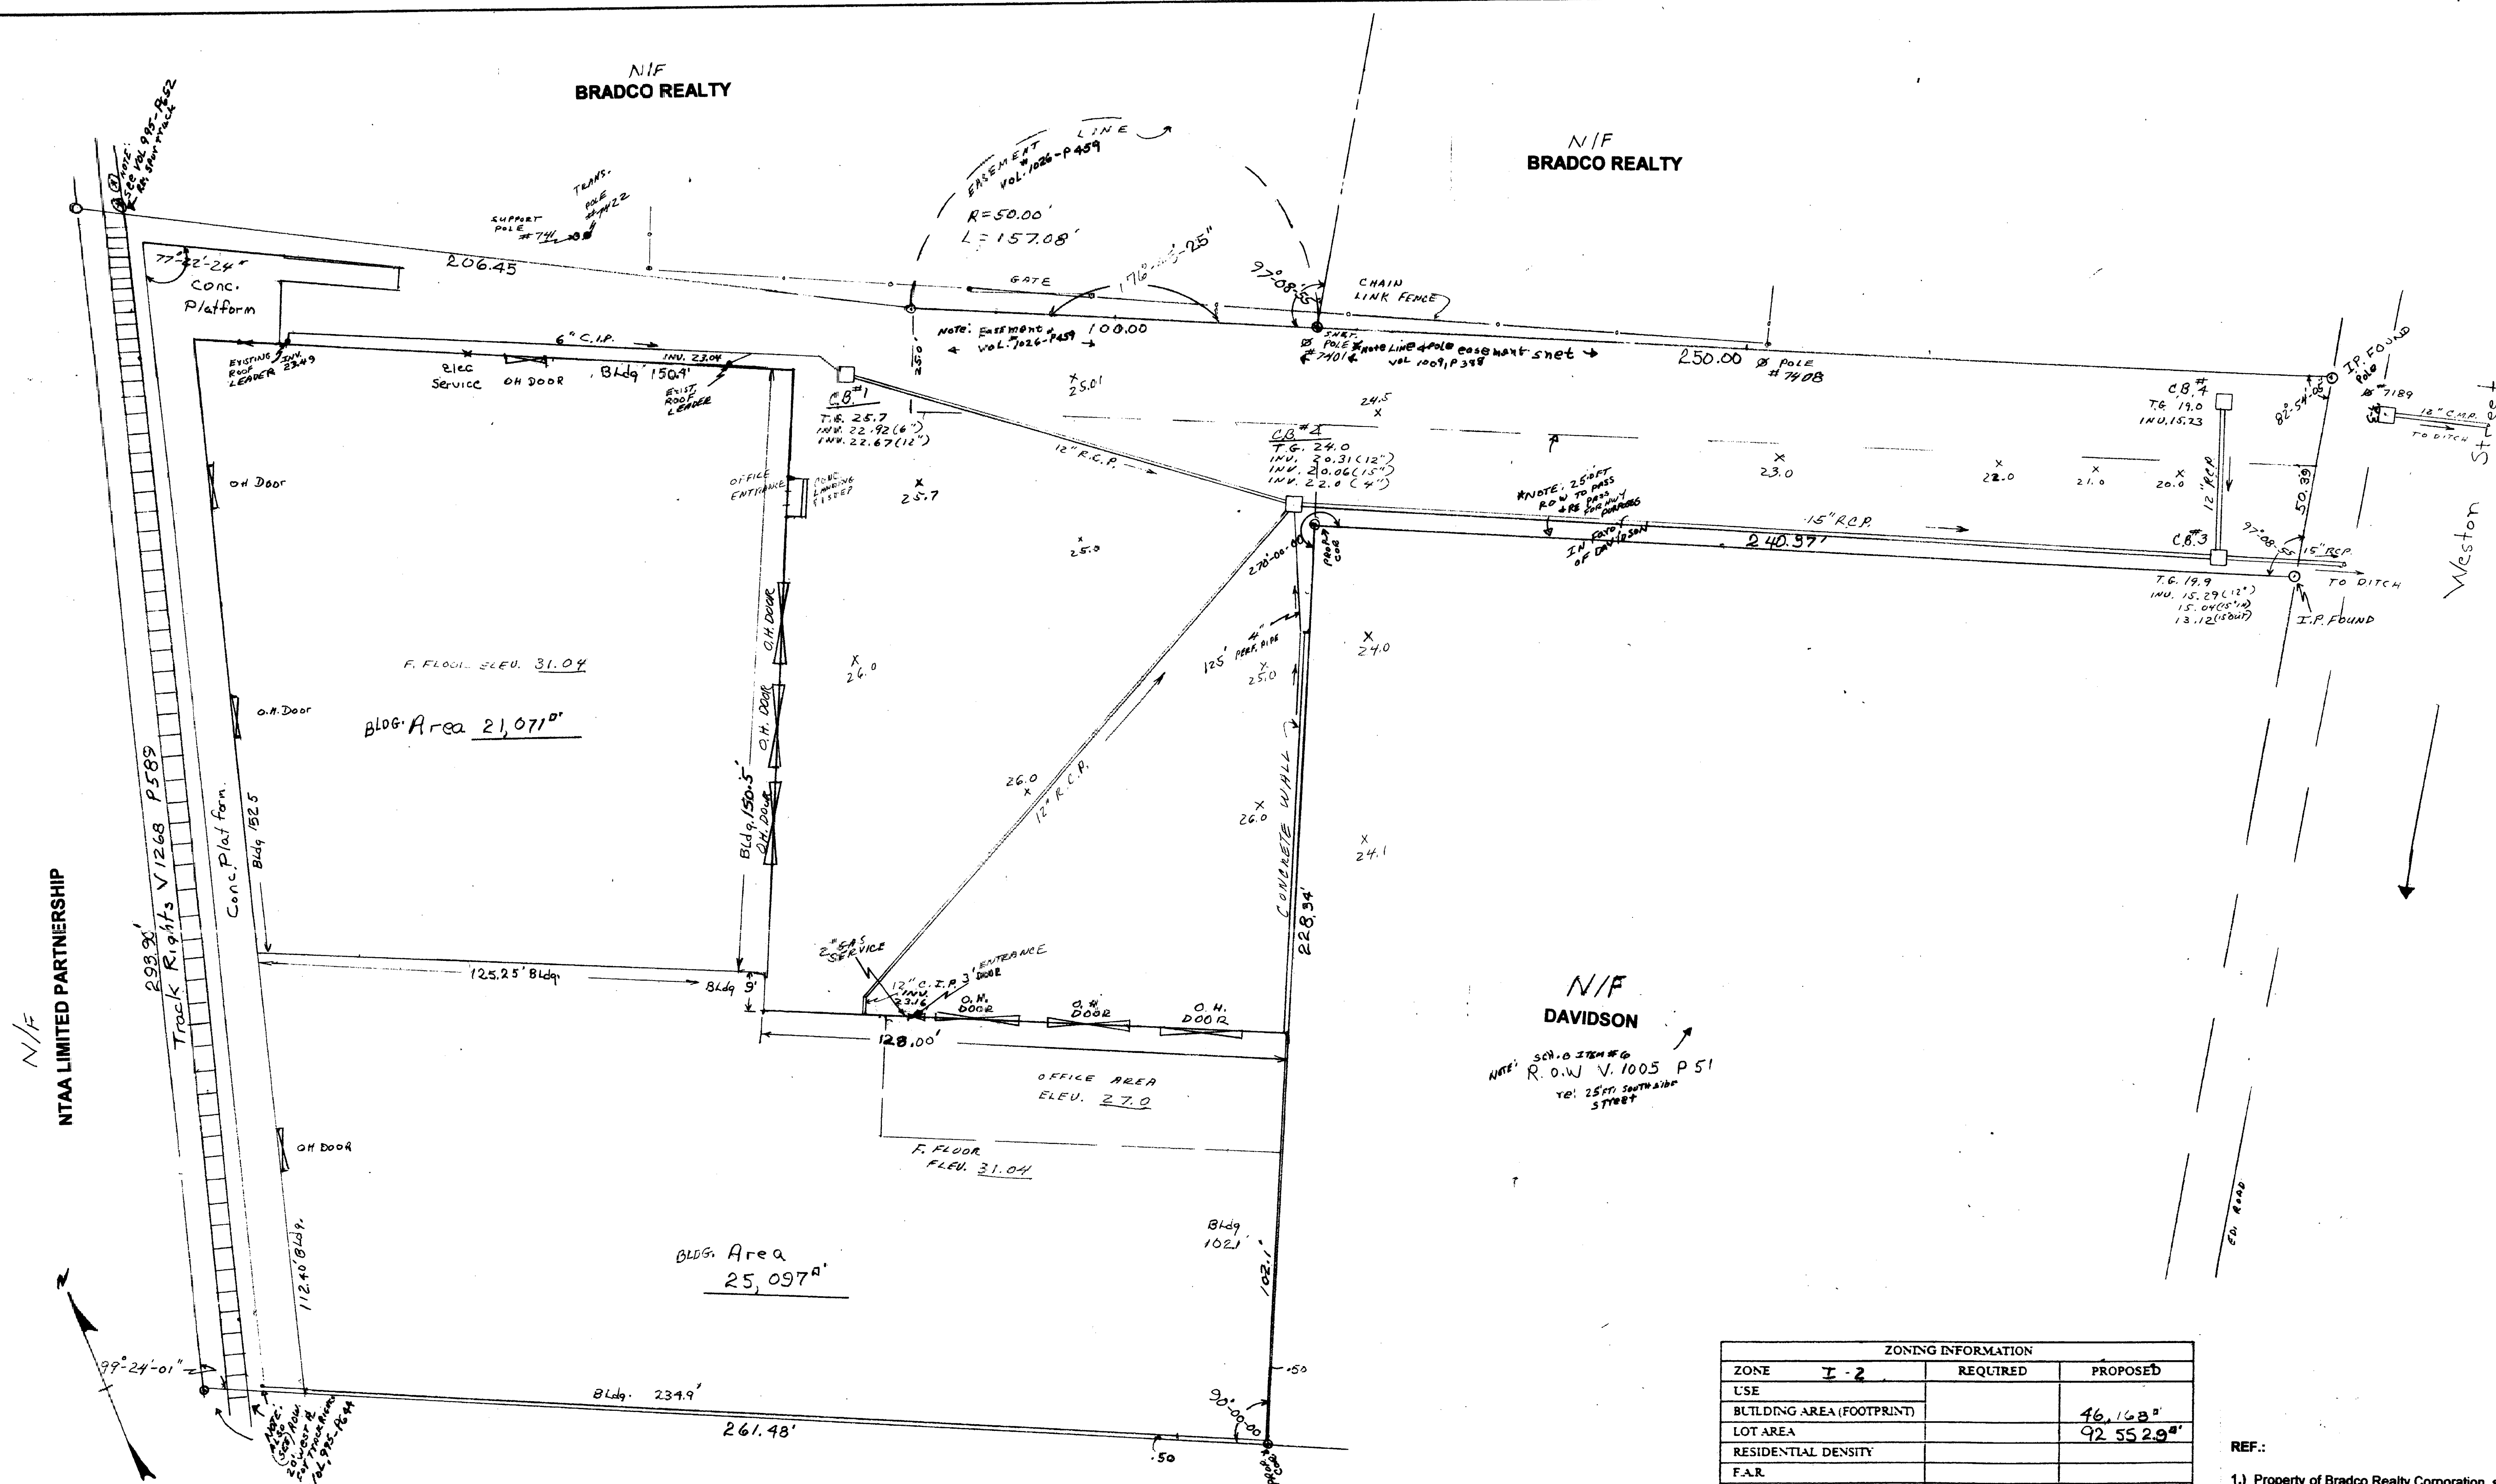

N/F  
NTAA LIMITED PARTNERSHIP

NOTES:  
1) THIS SURVEY HAS BEEN PREPARED IN ACCORDANCE WITH THE REGULATIONS OF CONNECTICUT STATE AGENCIES.  
2) THE BOUNDARY DETERMINATION CATEGORY IS A LOCATION IMPROVEMENT SURVEY BASED UPON THE REFERENCES NOTED HEREON.  
3) THIS PROPERTY SURVEY CONFORMS TO CLASS "A-2" HORIZONTAL ACCURACY.  
4) THIS PLAN SHOULD NOT BE CONSIDERED VALID WITHOUT MY LIVE SIGNATURE AND EMBOSSED SEAL.

Carl H. Jaeger

| ZONING INFORMATION        |          |                |
|---------------------------|----------|----------------|
| ZONE                      | REQUIRED | PROPOSED       |
| USE                       |          |                |
| BUILDING AREA (FOOTPRINT) |          | 46,148 sq ft   |
| LOT AREA                  |          | 92,552.9 sq ft |
| RESIDENTIAL DENSITY       |          |                |
| F.A.R.                    |          |                |
| LOT OCCUPANCY             |          |                |
| LOT WIDTH                 |          |                |
| FRONT YARD                |          |                |
| SIDE YARD                 |          |                |
| REAR YARD                 |          |                |
| HEIGHT                    |          |                |
| USABLE OPEN SPACE         |          |                |
| PARKING SPACES            |          |                |

\*DENOTES NON-CONFORMING

REF:

- 1.) Property of Bradco Realty Corporation, scale 1"= 20' dated 10/14/87, revised 1/18/88.
- 2.) Property of NTAA Limited Partnership, scale 1"=30' dated 11/20/85 revised 2/8/88.
- 3.) Property of Morris N. Cohen & George H. Hyman Trustees, to be conveyed to David Cohen of Weston Street Hartford, Conn., scale 1"=40' dated July 1955, revised July 15, 1955 by Petersen & Hoffman, Eng'rs. (R.O.W. Vol. 1005, Page 51).
- 4.) Track rights reserved in a deed from George M. Hyman, et al, trustees, to Samuel Cohen, et al, dated July 8, 1957, and recorded in the Hartford Land Records in Volume 1268 at Page 589. *PRIOR OWNER OF PROPERTY*

This drawing is prepared in accordance with state filing regulations. The process used is fixed-line photo. Joseph Merritt & Company

PROPERTY OF  
TO BE CONVEYED TO  
BRADCO REALTY CORP.

225 Weston Street

TOWN OF Hartford, CT.

I HEREBY CERTIFY TO BRADCO REALTY CORP., LAND AMERICA AND LAWYERS TITLE INSURANCE CORPORATION THAT THIS MAP & SURVEY WERE PREPARED IN ACCORDANCE WITH THE STANDARDS OF CLASS A-2 SURVEY AS DEFINED IN THE CODE OF PRACTICE FOR STANDARDS AND ACCURACY OF SURVEY & MAPS ADOPTED DECEMBER 10, 1975 AS AMENDED BY THE CONN. ASSOCIATION OF LAND SURVEYORS, INC. Section 36-2a-1a, 36-2a-1b, 36-2a-1c, 