2779

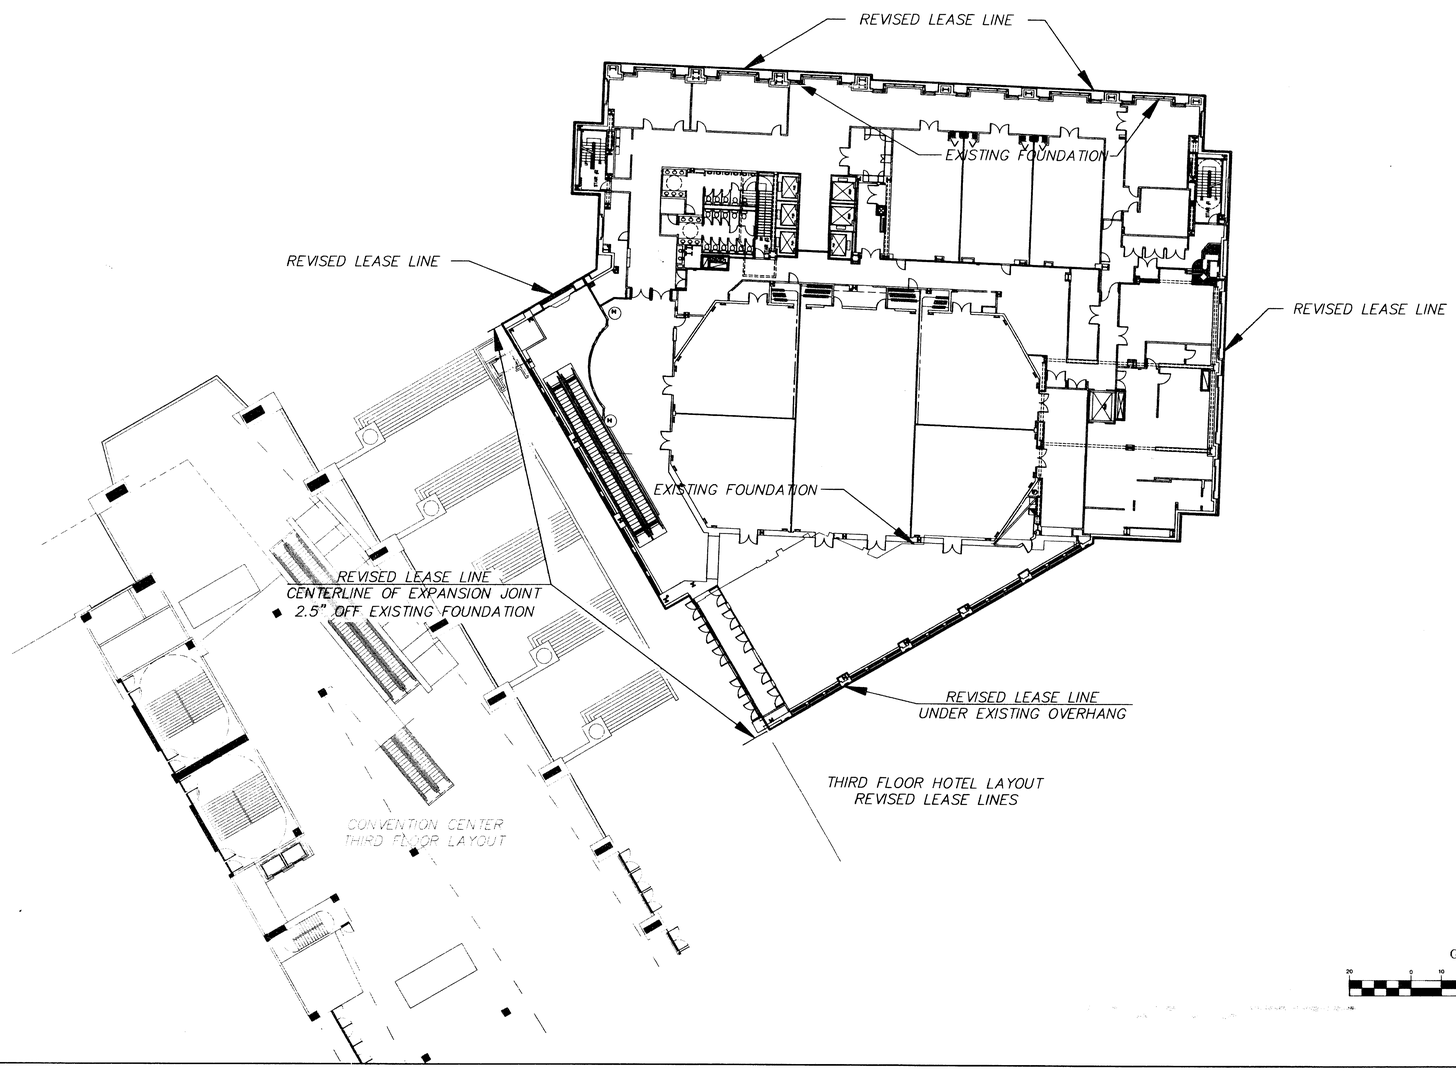

NAD83

GRAPHIC SCALE

20 0 10 20 40 80

(IN FEET)
1 inch = 20 ft.

THIS MAP PRODUCED BY ORIGINAL INK DRAWING ON POLYESTER FILM PRODUCED BY F.A. HESKETH & ASSOC. INC. EAST GRANBY, CT

ADRIAEN'S LANDING
Hartford, Connecticut

FAH F. A. Hesketh & Associates, Inc.
6 Creamery Brook, East Granby, CT 06026
Civil & Traffic Engineers · Surveyors · Planners · Landscape Architects
Phone (860) 653-8000
Fax (860) 844-8600
e-mail heskethassoc@net

revisions:			
no.	date	description	
1	03-07-02	LEASE AREAS	
2	03-21-02	REVISED LEASE - NEW HOTEL	
3	06-11-02	ADD SHEET 2 OF 2	
4	07-09-02	REVISED LEASE AREA	
5	08-11-02	ADD PHASING DETAIL AREA	
6	10-04-02	CORRECT DIMENSION	
7	12-24-02	FINALIZE	
8	01-31-03	MISC.	
9	02-07-03	ADD STAIRS	
10	05-30-03	CLIENT COMMENTS	
11	06-13-03	ADD FOOTIN TO CONVENTION	
12	09-24-03	REVISE HOTEL LAYOUT/CONVENTION PHASE	
13	09-24-03	REVISE HOTEL LAYOUT/CONVENTION PHASE	
14	08-11-05	NOWE THIS SHEET	
15	10-28-05	HOTEL AS BUILT/SHEET 3	
16	02-14-05	ADD UTILITIES	
17	02-17-05	SHEET 4	
18	02-23-05	SHEETS 5&7 = REV. LEASE AREAS	

THIRD FLOOR HOTEL LAYOUT

HOTEL LEASE PLAN
PREPARED FOR
STATE OF CONNECTICUT
ADRIAEN'S LANDING
HARTFORD, CONNECTICUT

date: 09-23-01 | drawn by: CAD | job no: 96007
scale: 1" = 20' | checked by: TSH | sheet no: 7 OF 7

EAH-7

2779