


ADRIAEN'S LANDING
Hartford, Connecticut

Phone (860) 855-9000
Fax (860) 844-9000
e-mail: hah@hah.com

F. A. Heketh & Associates, Inc.
6 Creamery Brook, East Granby, CT 06026
Civil & Traffic Engineers • Surveyors • Planners • Landscape Architects


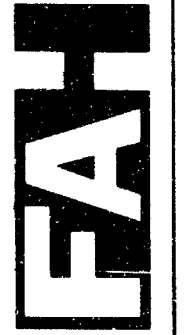


FIRST FLOOR HOTEL LAYOUT

HOTEL LEASE PLAN
PREPARED FOR
STATE OF CONNECTICUT
ADRIAEN'S LANDING
HARTFORD, CONNECTICUT

date: 09-23-01 drawn by: CAD job no: 96007
scale: 1" = 20' checked by: JSH sheet no: 6 OF 7

EAH-6

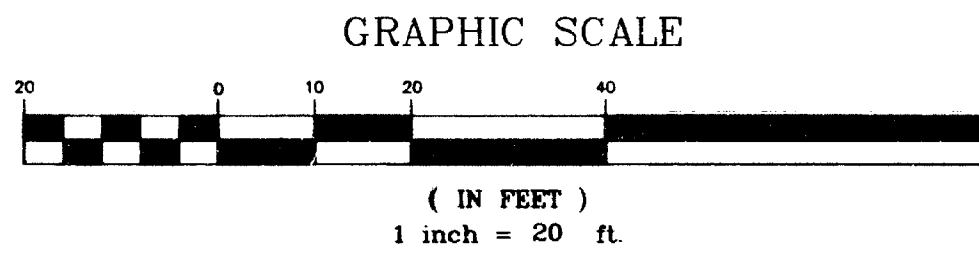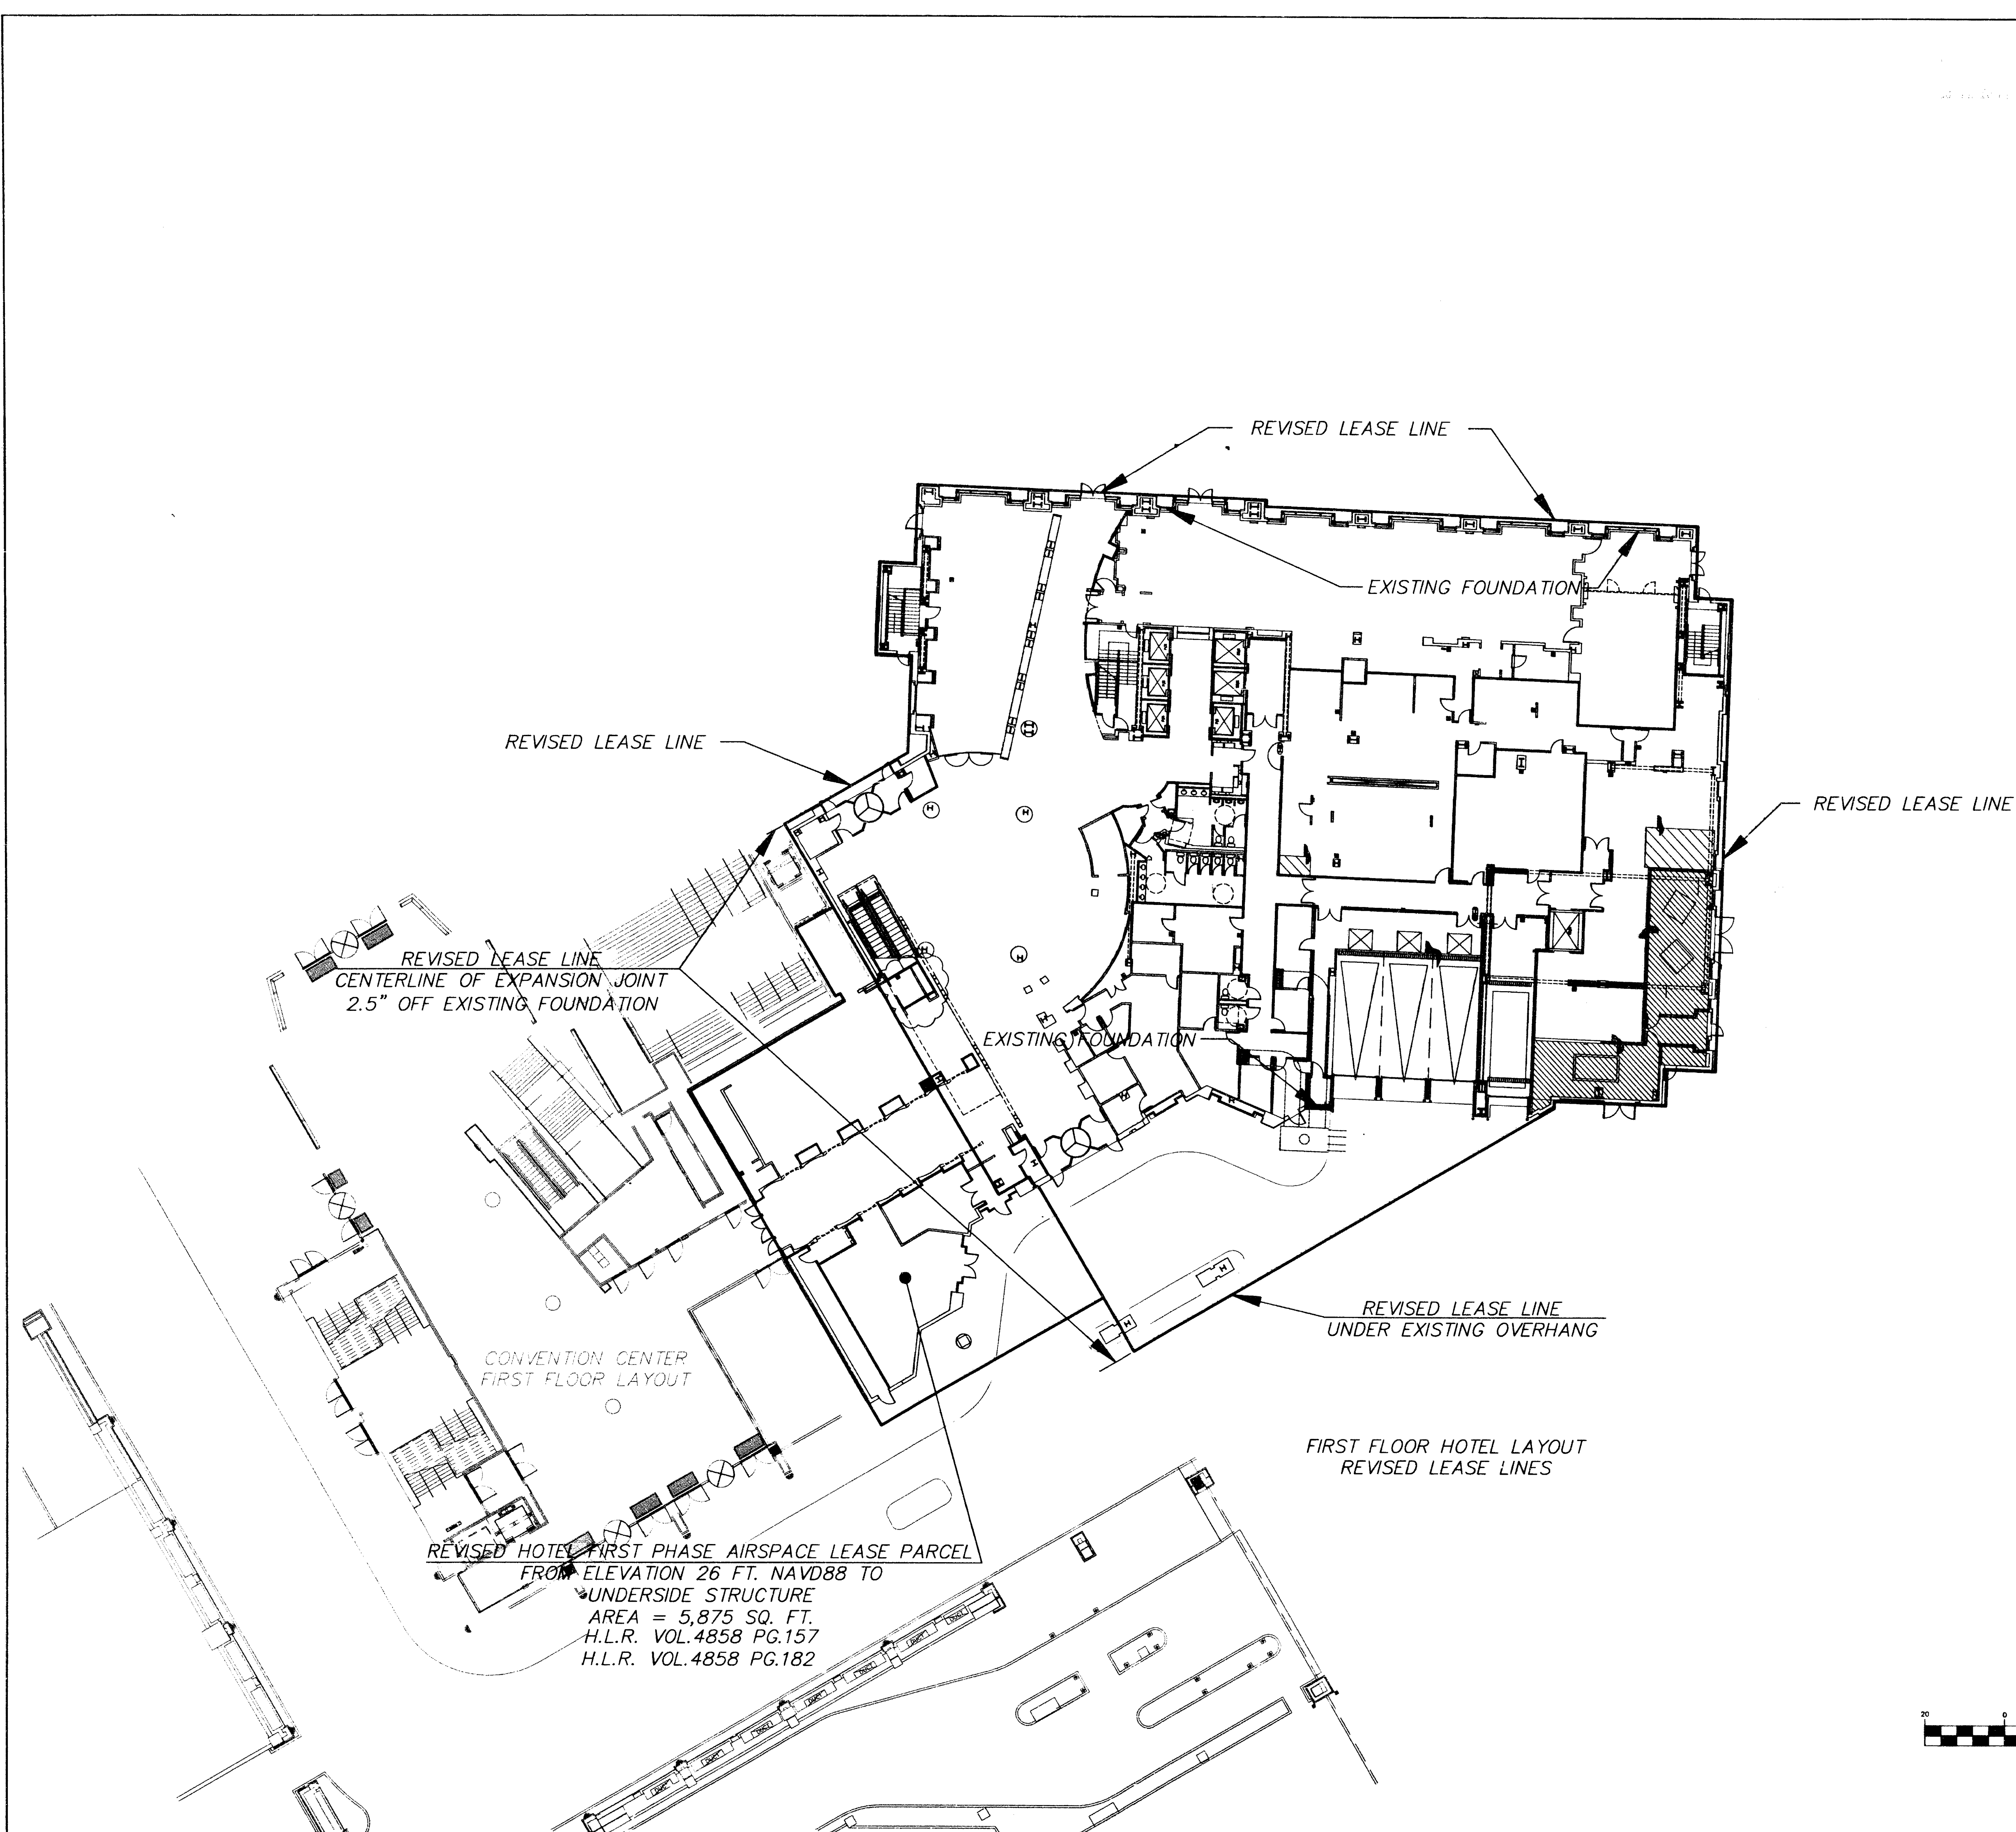

THIS MAP WAS PREPARED BY
GRAPHIC DESIGN & DRAWING
ON POLYGRAPHIC FILM
FOR THE STATE OF CONNECTICUT
F.A.H. & ASSOCIATES, INC.
EAST GRANBY, CT