
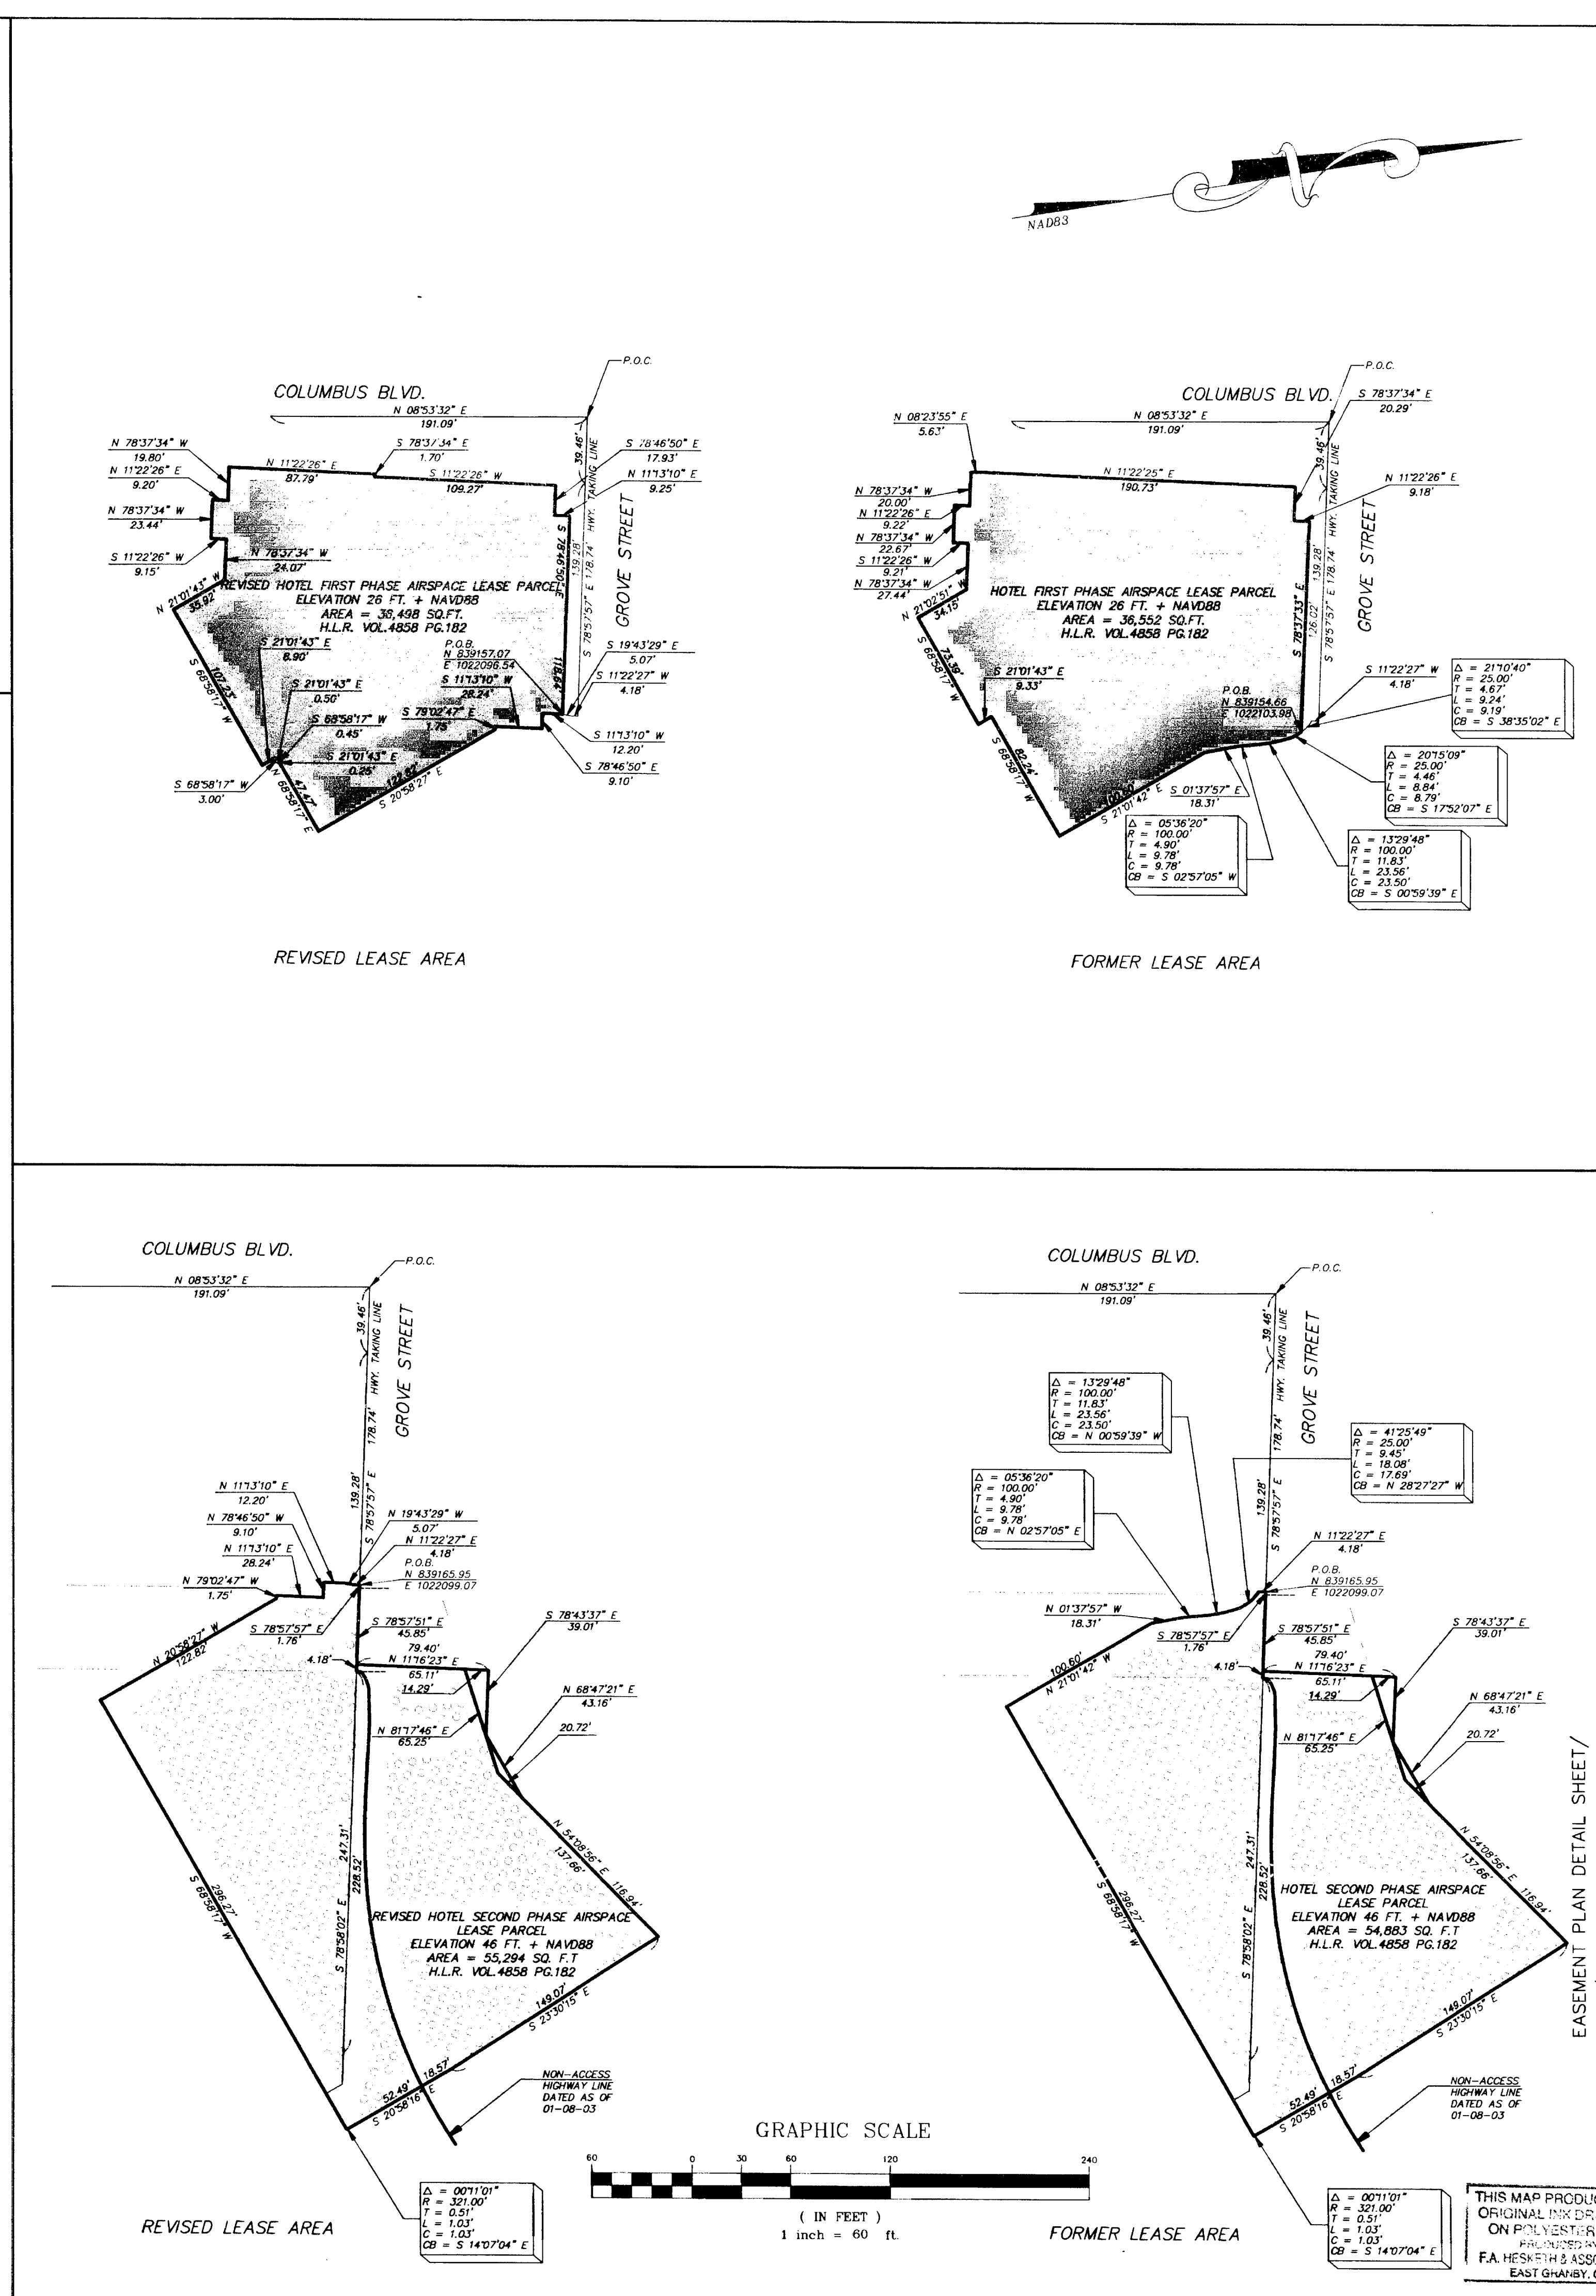


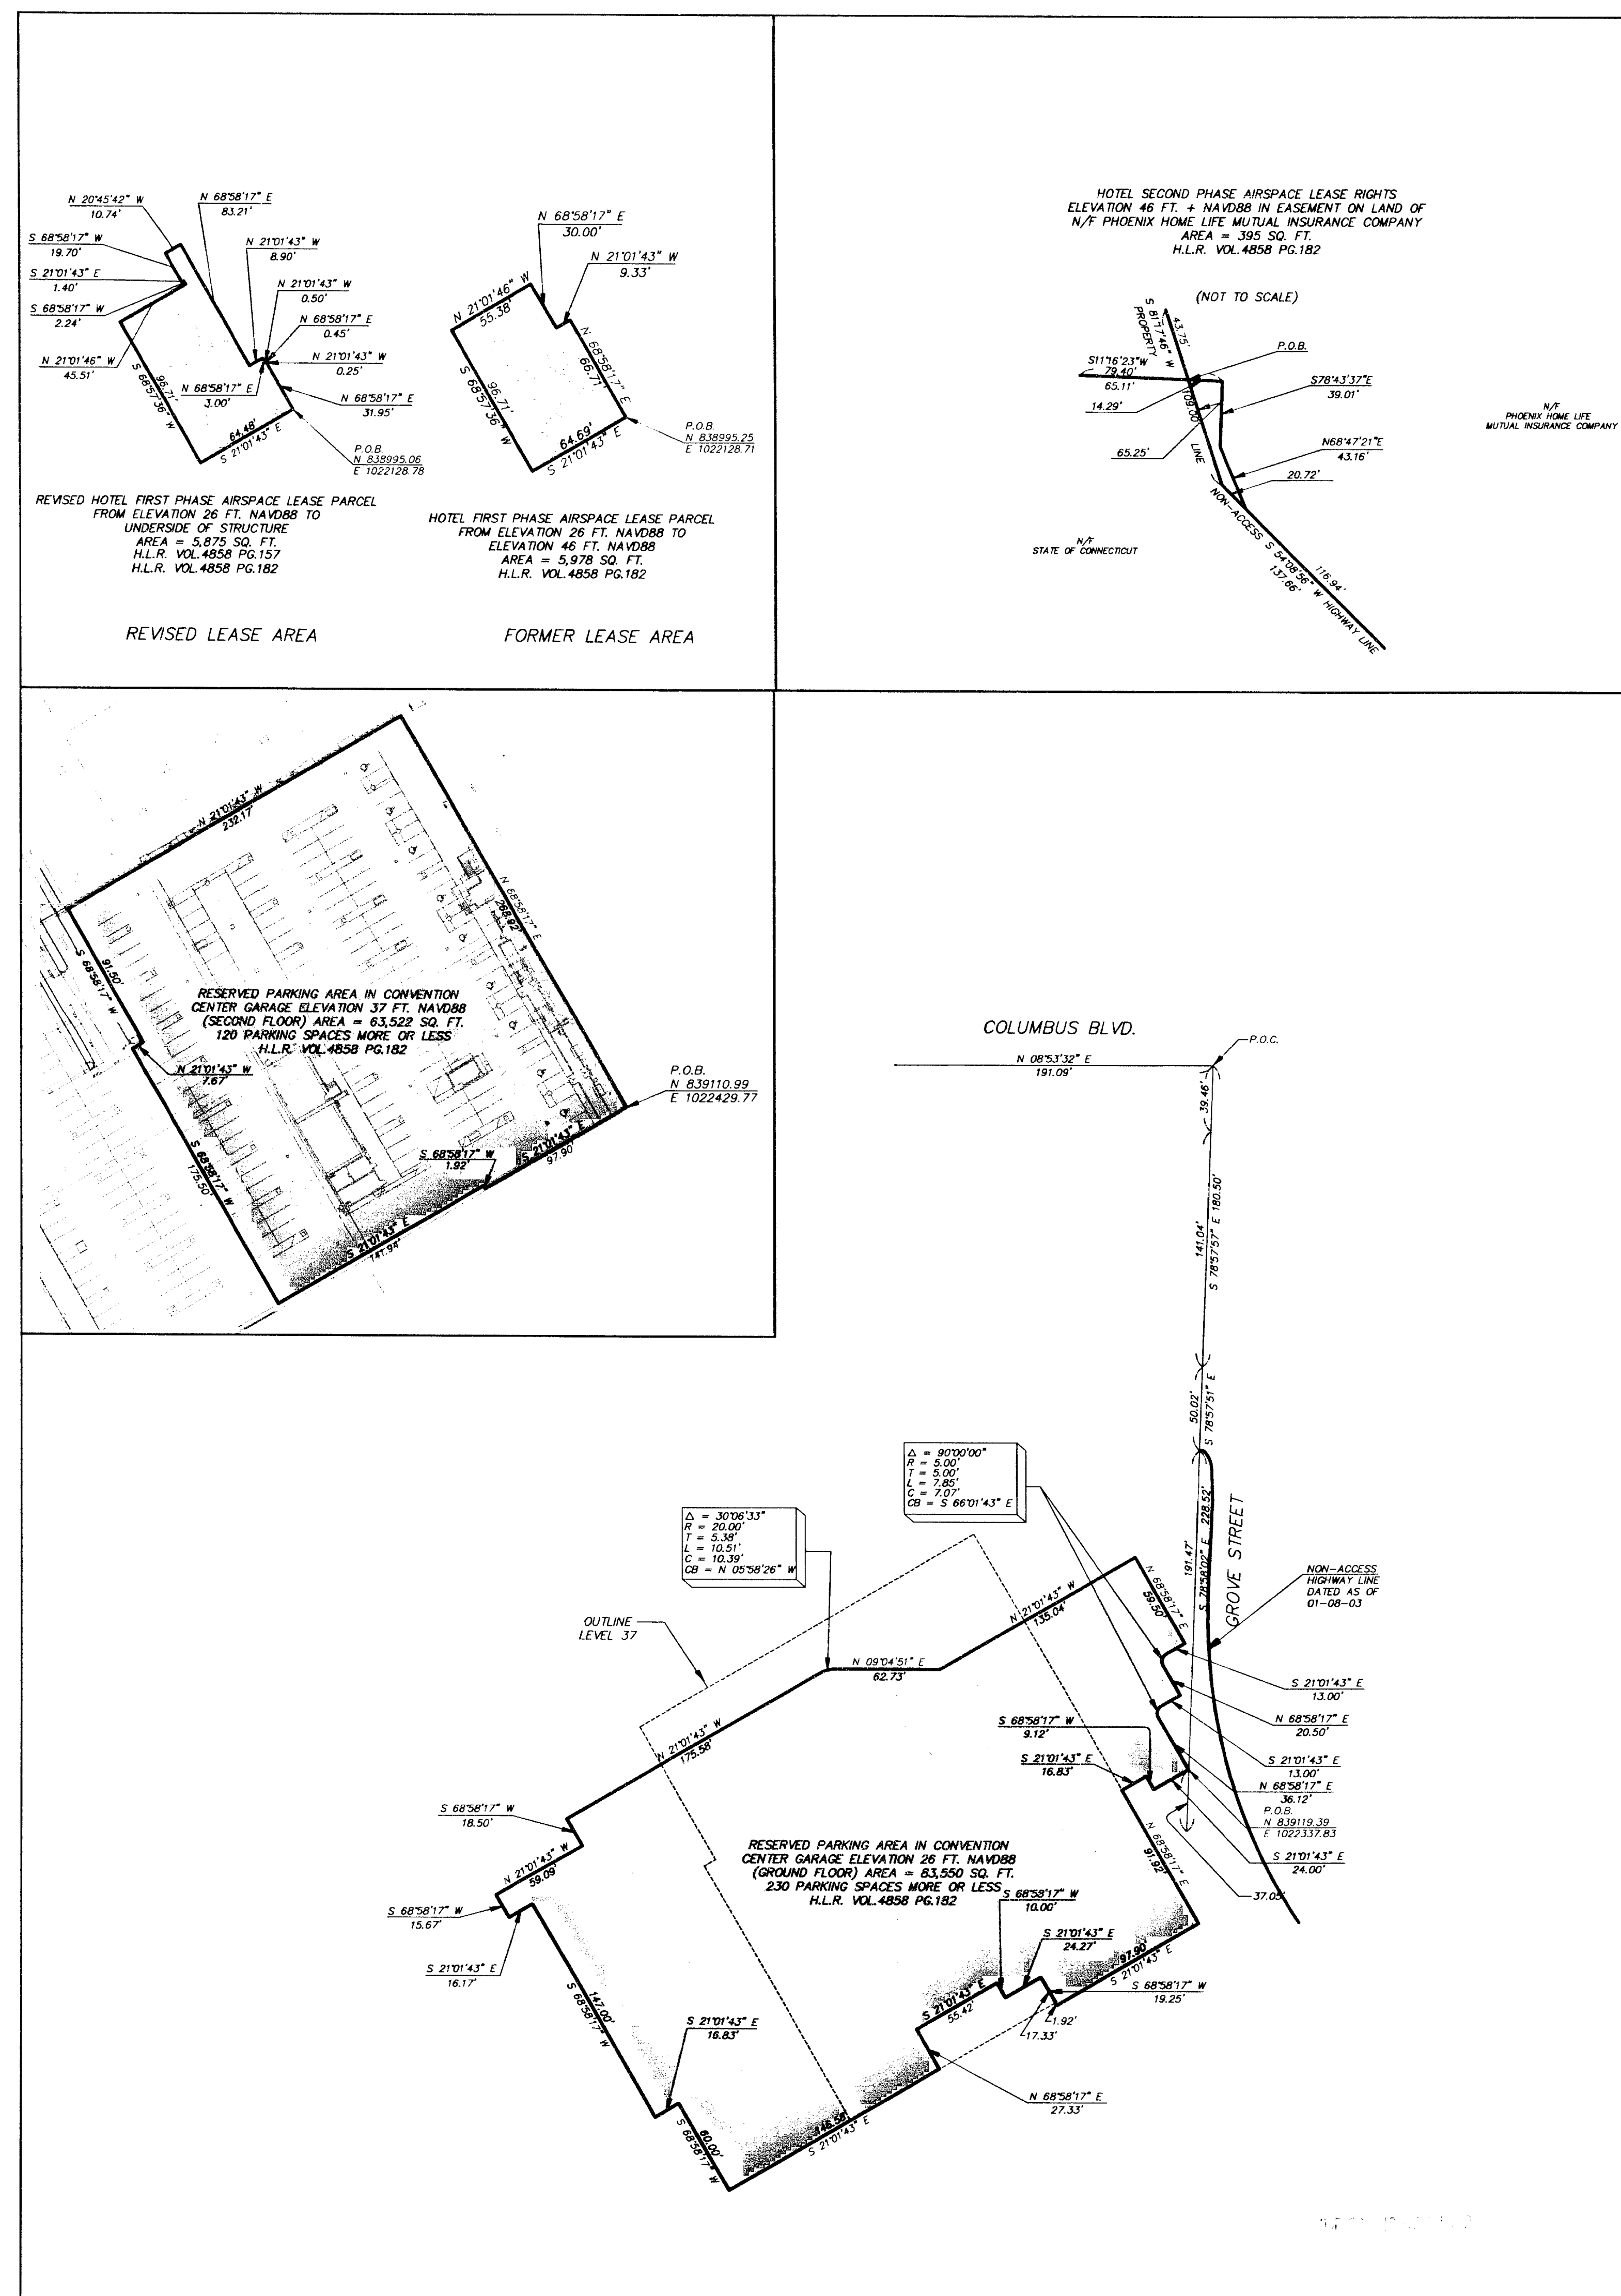

ADRIAEN'S LANDING
Hartford, Connecticut

F. A. Heskeith & Associates, Inc.
6 Creamery Brook, East Granby, CT 06026

EAH-2

NO.	DATE	DESCRIPTION
1	03-07-02	REVISED LEASE - NEW HOTEL

STATE OF CONNECTICUT
ADRIAEN'S LANDING
HARTFORD, CONNECTICUT

EAH-2

THIS MAP PRODUCED
ORIGINAL IN DRAWING
ON POLYESTER FILM
F.A. HESKEITH & ASSOCIATES
EAST GRANBY, CT