



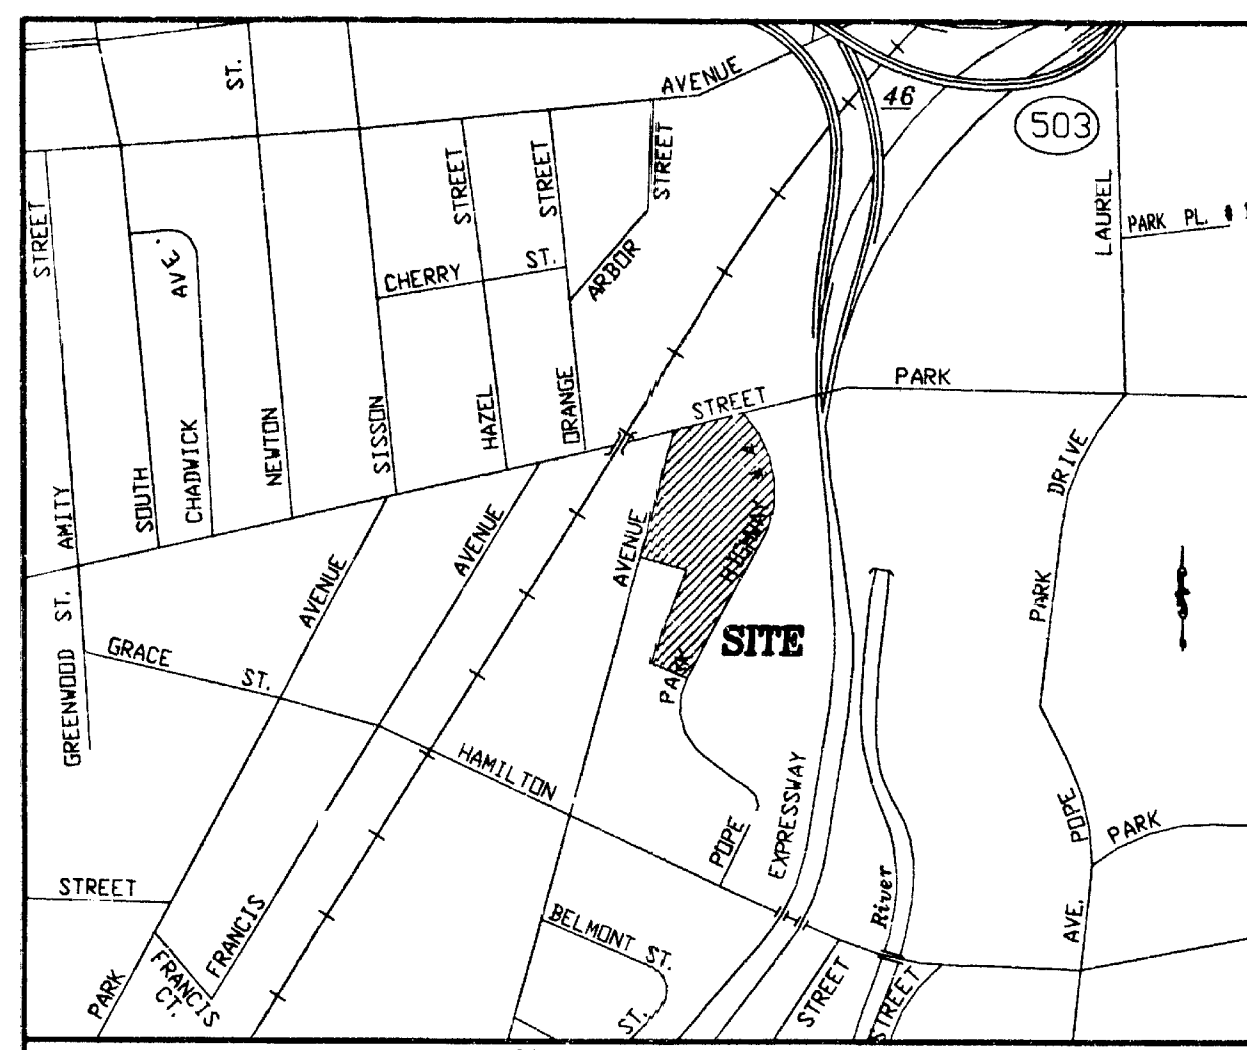

VICINITY MAP
N.T.S.

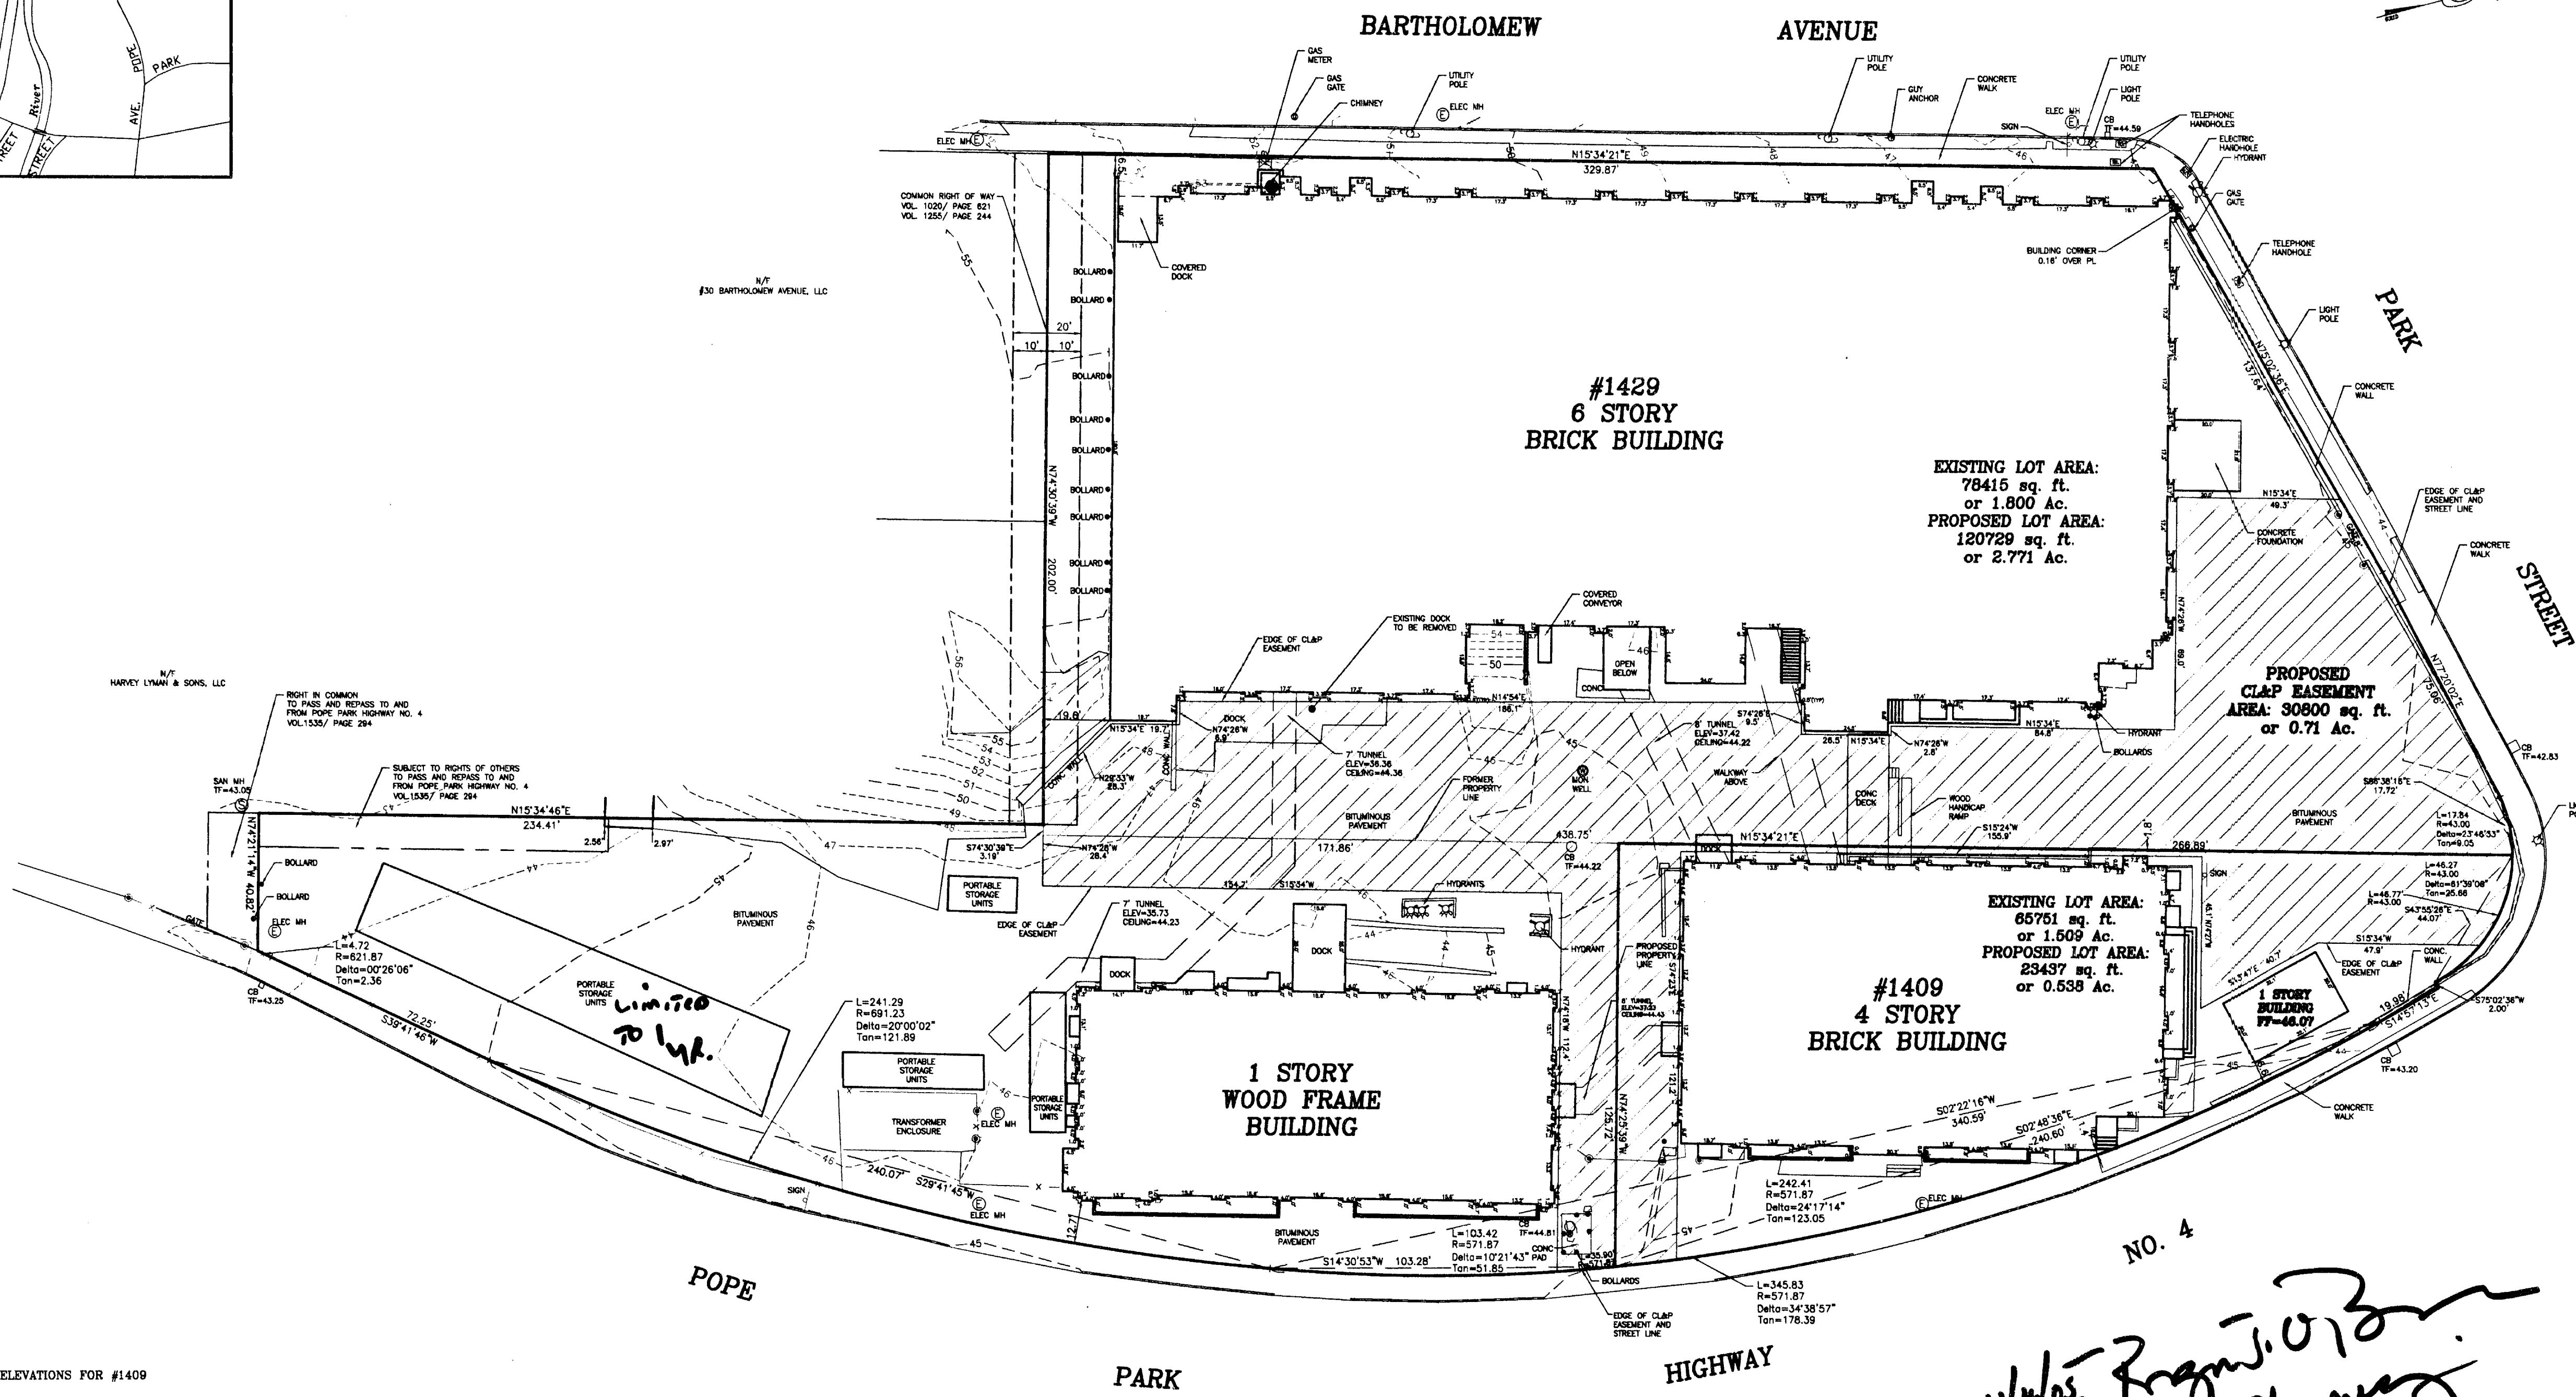

FLOOR ELEVATIONS FOR #1429

BASEMENT	-57.66
1st FLOOR	-55.39
2nd FLOOR	-57.50
3rd FLOOR	-59.22
4th FLOOR	-61.19
5th FLOOR	-63.08
6th FLOOR	-65.21
1st FLOOR MEZZANINE	-46.36
2nd FLOOR MEZZANINE	-48.44
3rd FLOOR MEZZANINE	-50.57
4th FLOOR MEZZANINE	-52.55
5th FLOOR MEZZANINE	-54.80
6th FLOOR MEZZANINE	-57.82

FLOOR ELEVATIONS FOR #1409

BASEMENT	-57.31
1st FLOOR	-47.11
2nd FLOOR	-61.98
3rd FLOOR	-67.16
4th FLOOR	-72.16

FLOOR ELEVATIONS FOR 1 STORY BUILDING

BASEMENT	-57.23
1st FLOOR	-47.21

NOTES

1. THE SURVEY AND MAP HAS BEEN PREPARED IN ACCORDANCE WITH SECTIONS 20-300B-1 THRU 20-300B-20 OF THE REGULATIONS OF THE CONNECTICUT STATE AGENCIES - STANDARDS FOR SURVEYS AND MAPS IN THE STATE OF CONNECTICUT AS ADOPTED BY THE CONNECTICUT ASSOCIATION OF LAND SURVEYORS, INC. ON SEP. 26, 1996. THIS IS A PROPERTY SURVEY BASED ON AN ORIGINAL SURVEY CONFORMING TO HORIZONTAL ACCURACY CLASS A-2 AND IS INTENDED TO DEPICT THE POSITION OF BOUNDARIES WITH RESPECT TO LOCATIONS OF ALL BOUNDARY MONUMENTATION, APPARENT IMPROVEMENTS AND FEATURES, RECORD EASEMENTS AND VISIBLE EVIDENCE OF THE USE THEREOF, RECORDS AND APPARENT MEANS OF ACCESS AND EGRESS LINES OF OCCUPATION AND USED RESTRICTIONS PERTAINING TO THE LOCATION OF BUILDINGS OR OTHER IMPROVEMENTS.
2. THE PERIMETER BOUNDARY IS BASED ON A RE-SURVEY.
3. THE SURVEY IS NOT VALID WITHOUT A LINE SIGNATURE AND EMBOSSED SEAL.


TO MY KNOWLEDGE AND BELIEF THIS MAP IS SUBSTANTIALLY CORRECT AS NOTED HEREON.

John H. Miller
JOHN H. MILLER, P.E., L.S.
LIC. NO. 4142

THIS MAP PRODUCED BY
ORIGINAL INK DRAWING ON
POLY FILM OR LINEN
CLOSE, JENSEN & MILLER, P.C.
1137 SILAS DEANE HIGHWAY
WETHERSFIELD, CT 06109

Walter R. Jensen
Dir. of Planning
CITY OF HARTFORD
PLANNING DIVISION
OFFICIAL APPROVED PLANS

ADOPTED BY: _____
DATE: _____
SIGNATURE: _____

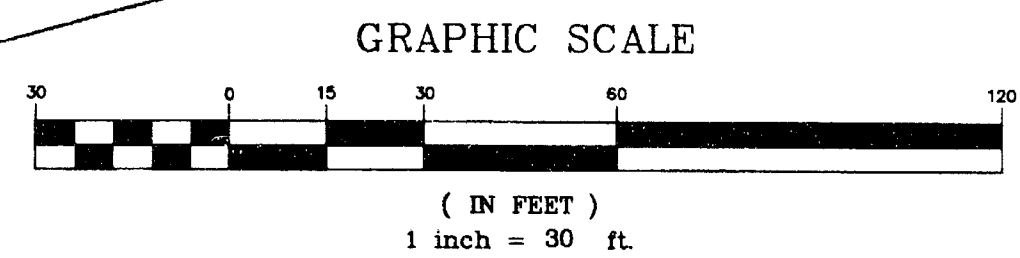

No. _____	Date _____	Description _____	Revisions _____
No. _____	Date _____	Description _____	Revisions _____

C. J. M.	Close, Jensen & Miller, P. C. Consulting Engineers, Land Planners & Surveyors 1137 Silas Deane Highway, Wethersfield, Conn. 06109, Tel. (860)563-9375	Compiled <u>A.E.A.</u> P.C. Check _____ Designed _____ Drawn <u>A.E.A.</u> Checked <u>A.E.A.</u> Scale 1"=30' Date 9/9/05 Sheet 1 of 1 Job No. _____ File No. _____
LOT LINE REVISION		
PROPERTY OF 2074-1429 PARK STREET, LLC 1405,1409,1429 PARK STREET HARTFORD CONNECTICUT		