

#2834

RECEIVED BY


D. J. Carey

JUL 14 4 55 AM '06


TO

VOLUME

WEST PRESTON STREET

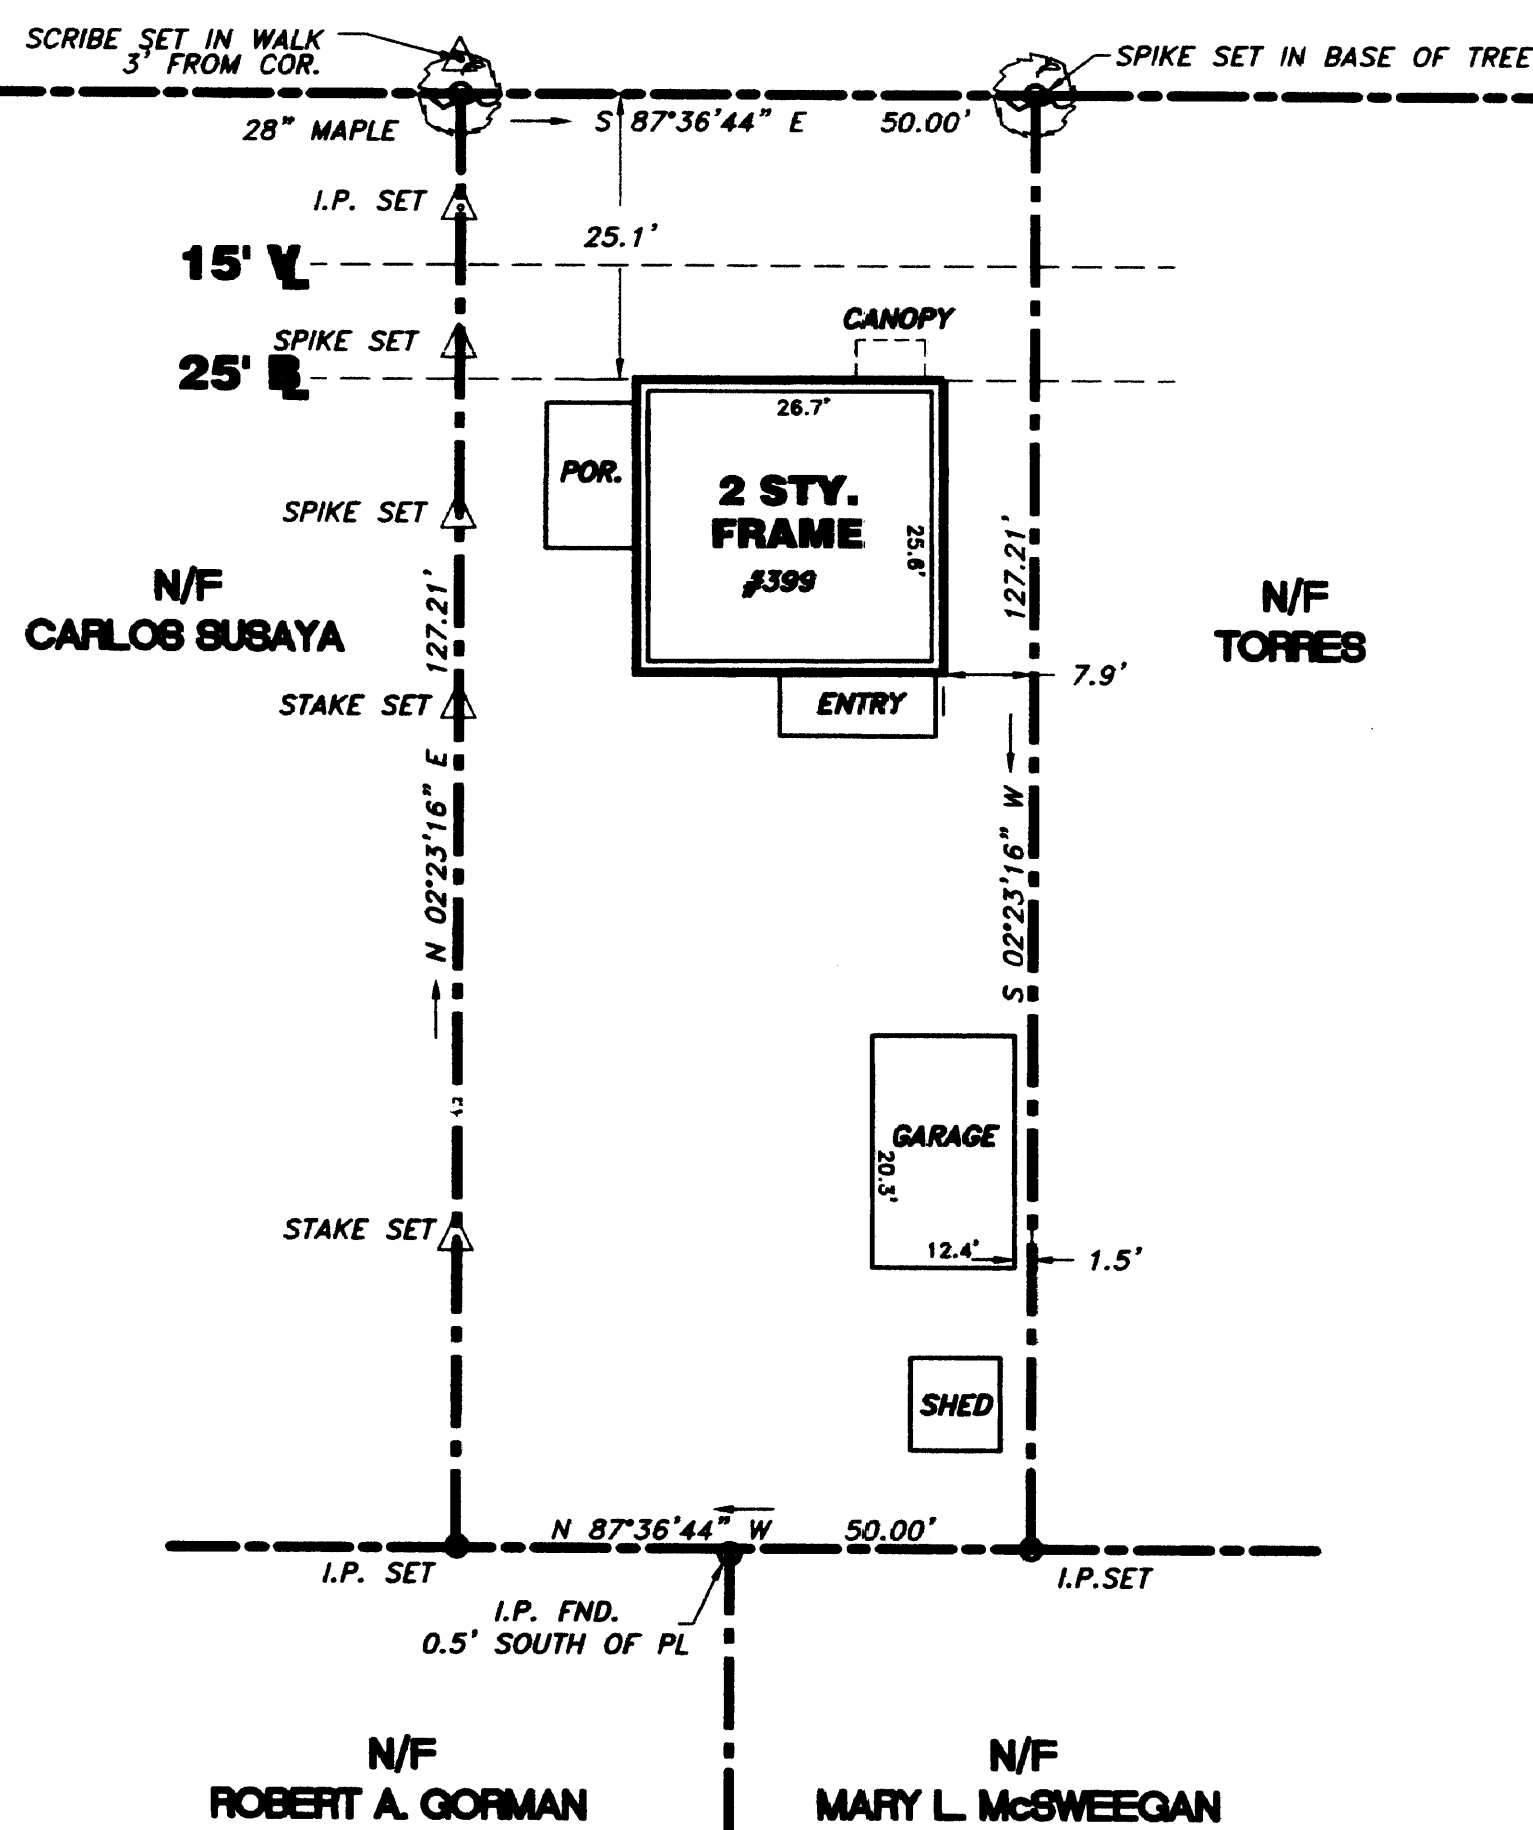

GRAPHIC SCALE

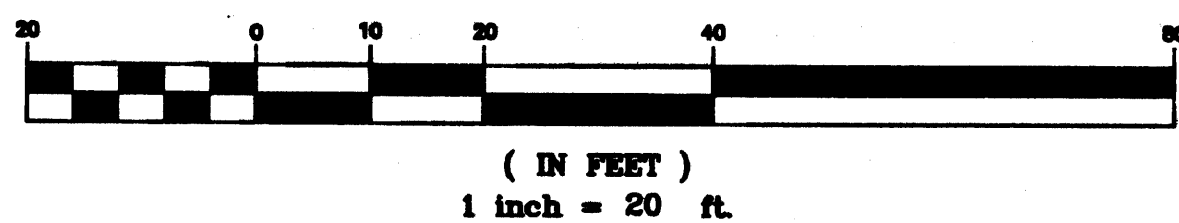LOCATION MAP
SCALE: 1"=1,000'

NOTES:

1. SURVEY NOTES:

-This survey has been prepared pursuant to the Regulation of Connecticut State Agencies Section 20-300b-1 Through 20-300b-20 and the "Standards for Surveys and Maps in the State of Connecticut" as adopted by the Connecticut Association of Land Surveyors, Inc. on September 26, 1996.

-Type Of Survey is PROPERTY SURVEY

-Boundary Determination Category is DEPENDENT RESURVEY OF MAP REF.

-Class of Accuracy is A-2

2. LOT AREA= 6,380 sq. ft.. or 0.1460 acre

3. MAP REFERENCE:

A.)- PROPERTY OF ELIZABETH MURPHY 399 WEST PRESTON STREET TRACT, HARTFORD, CONN. DATED: JANUARY 17, 1979. SCALE: 1"=20'. PREPARED BY: PAUL A. HALLISEY.

4. PROPERTY MAY BE BURDENED AND/OR BENEFITED BY RECORDED AND/OR UNRECORDED EASEMENTS.

TO MY KNOWLEDGE AND BELIEF, THIS MAP IS SUBSTANTIALLY CORRECT AS NOTED HEREON:

Paul A. Hallisey

PAUL A. HALLISEY LICENSE NO. 7761

9/10/04

DATE

THIS DOCUMENT AND COPIES THEREOF ARE VALID ONLY IF THEY BEAR THE SIGNATURE AND EMBOSSED SEAL OF THE DESIGNATED LICENSED PROFESSIONAL. UNAUTHORIZED ALTERATIONS TO THIS PLAN RENDER THE DECLARATION HEREON NULL AND VOID. VALID ONLY ON MAPS BEARING EMBOSSED SURVEYOR'S SEAL

PROPERTY SURVEY
PREPARED FOR
CLARE T. MURPHY
#399 WEST PRESTON STREET
HARTFORD, CONNECTICUT

HALLISEY, PEARSON & CASSIDY

CIVIL ENGINEERS & LAND SURVEYORS

35 COLD SPRING ROAD,
SOUTHWAY EXECUTIVE PARK, UNIT #511
ROCKY HILL, CONNECTICUT

SCALE: 1"= 20'

CHECKED BY: P.A.H.


DATE: SEPTEMBER 10, 2004

JOB NO: 1375

ACAD FILE: 1375

SHEET: 1 OF 1

REVISIONS:

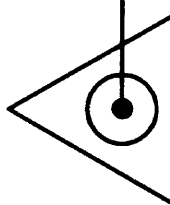

#2834