

2840-70

REVISIONS:

CONSULTANTS:

SURVEYOR
THE BONGIOVANNI GROUP, INC.
170 PANE ROAD - 2ND FLOOR
NEWINGTON, CT 06111
860.666.0134
860.666.3830 (FAX)




[Signature]

ARCHITECTURAL SURVEY:
THE CONDOMINIUMS AT 960 MAIN
AS DECLARED BY HARTFORD DOWNTOWN REVIVAL LLC
DECLARATION SCHEDULE A-4
in the City of
HARTFORD, CONNECTICUT

JCJ ARCHITECTURE
JCJ Architecture, Inc.
38 Prospect Street
Hartford, CT 06103

©2008 JCJ Architecture, Inc.

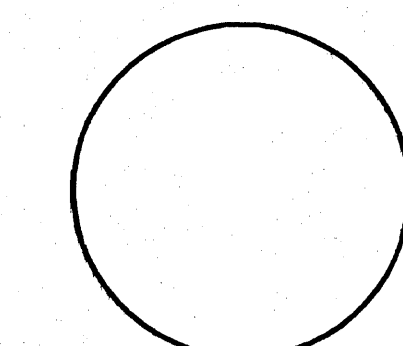


P.C. _____
P.M. _____
D.P. _____
J.C. _____

ISSUE 06.07.06
JOB 974600
DRAWN M.N.
SCALE 1/16" = 1'-0"

10/13


2840-10

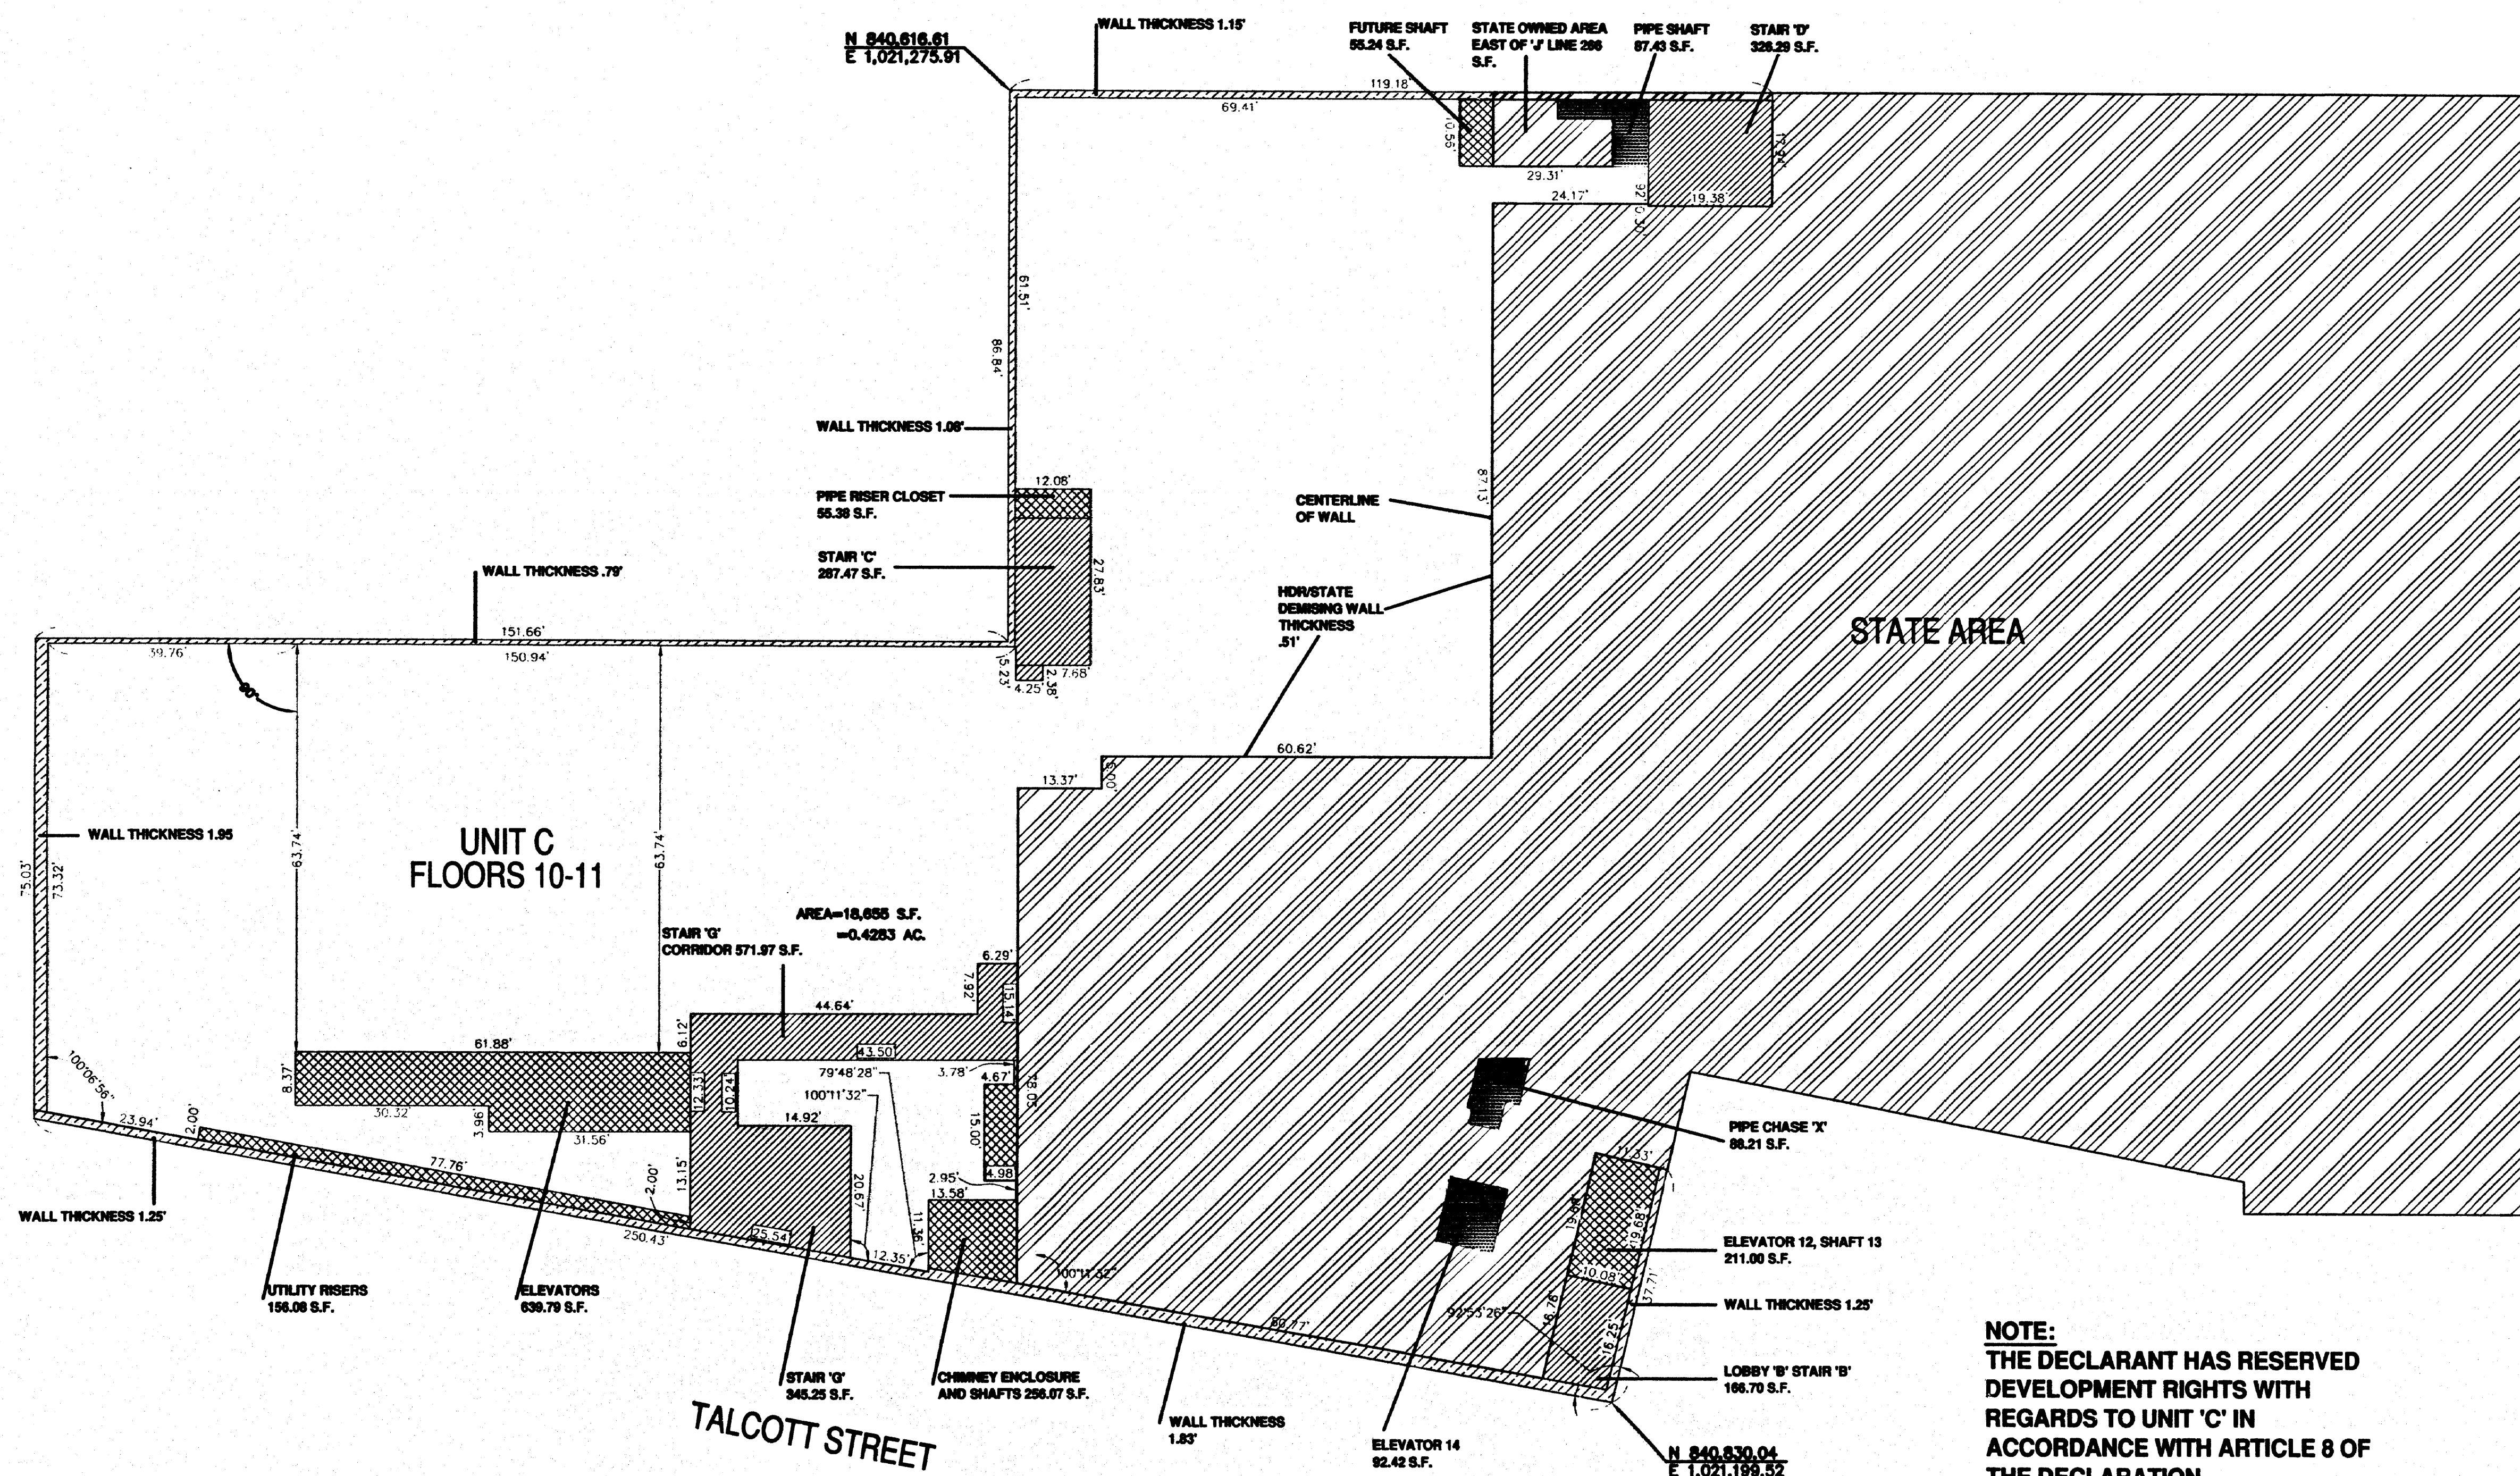

- NOTES
- COORDINATES ARE BASED ON STATE PLANE COORDINATE SYSTEM (NAD 1983).
 - BUILDING ELEVATIONS ARE BASED ON MDC DATUM.
 - IN AREAS DESIGNATED "DEVELOPMENT RIGHTS RESERVED IN THIS AREA", DEVELOPMENT RIGHTS TO ADD UNITS AND LIMITED COMMON ELEMENTS ARE RESERVED IN THESE AREAS. UNIT AND BUILDING LOCATIONS, DIMENSIONS AND SHAPES ARE APPROXIMATE AND MAY VARY IN ACCORDANCE WITH DECLARANT OR SITE REQUIREMENT (OR AT DECLARANT'S OPTION). SEE ARTICLE 10 OF THE DECLARATION FOR RESERVATIONS AND LIMITATIONS ON DEVELOPMENT RIGHTS. AREAS SHOWN AS ROADWAYS ARE NOT DEDICATED TO PUBLIC USE.
 - ALL ANGLES ARE RIGHT ANGLES UNLESS NOTED OTHERWISE.

THIS MAP PRODUCED BY
ORIGINAL INK DRAWING ON
POLY FILM OR LINEN
BONGIOVANNI GROUP, INC.
170 PANE ROAD 2ND FL.
NEWINGTON, CT 06111

BUILDING SECTION KEY

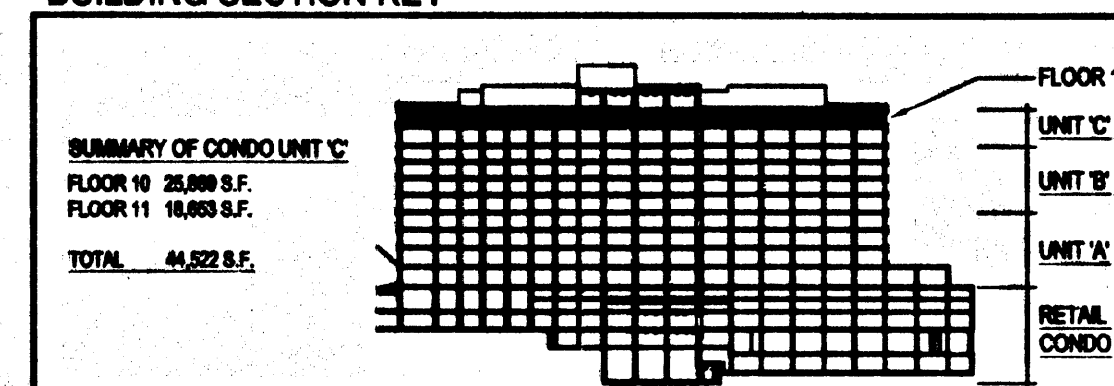

NOTE:
THE DECLARANT HAS RESERVED
DEVELOPMENT RIGHTS WITH
REGARDS TO UNIT 'C' IN