SURVEY NOTES

1) THIS SURVEY AND MAP HAS BEEN PREPARED IN ACCORDANCE WITH SECTIONS 20-300B-1 THRU 20-300B-20 OF THE REGULATIONS OF CONNECTICUT STATE AGENCIES - "MINIMUM STANDARDS FOR SURVEYS AND MAPS IN THE STATE OF CONNECTICUT" AS ENDORSED BY THE CONNECTICUT ASSOCIATION OF LAND SURVEYORS, INC. ON SEPT. 26, 1996. IT IS DATA ACCUMULATION PLAN AND IS BASED UPON LIMITED FIELD DATA AND REFERENCE MAPS CONFORMING TO HORIZONTAL ACCURACY CLASS TYPE D AND IS INTENDED TO BE USED TO DEPICT A PROPOSED

2) PCB LEVELS DETERMINED BY TRC.



A. Rafael Martinez, LLS

Martinez-Couch & Associates, LLC 98 South Tumpike Road Wallingford, CT 06419

> RE: Level D Survey for Surface Cap: South Meadow Station and Mid-Connecticut Facility Gate 20 - Reserve Road and 300 Maxim Road - Hartford, CT TRC Project No. 31378

Dear Mr. Martinez:

This letter is in regards to the Level D survey performed by your company at the South Meadows Facility in Hartford, Connecticut. The survey delineated the extent of a surface cap constructed by TRC in the area TRC designated as EA3B. The survey information provided by your company conforms to the requirements established by statute in the State of Connecticut. However, additional information is required to conform to applicable federal regulations.


Specifically, the approval letter from EPA Region 1 requires that maps placed on the land record conform with the requirements of \$761.61(a)(8)(A)(3) and that the applicable cleanup levels left at the site, inside the fence, and/or under the cap be indicated. TRC has modified drawings provided by your company so that this information can be included in the information to be filed on the land records for the South Meadows Facility.

TRC acknowledges that Martinez-Couch & Associates were only involved in the survey of the surface features associated with the surface cap and was not involved in any of the data collection associated with determination of PCB concentrations. The information on PCB concentrations was generated solely by TRC as was the map showing the concentrations remaining at the site.

Sincerely,

Malcolm a. Buler Project Engineer

LEGEND

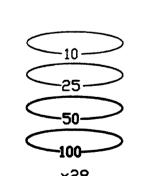

SOIL PCB CONCENTRATION ≥1 & (10 (mg/kg) SOIL PCB CONCENTRATION ≥10 & (25

(mg/kg) SDIL PCB CONCENTRATION ≥25 & <50 (mg/kg)

SOIL PCB CONCENTRATION ≥50 & (100 (mg/kg)

SOIL PCB CONCENTRATION ≥100 (mg/kg)

SUIL PCB SPUT CUNCENTRATION (mg/kg)

This map is produced by original ink drawing on Poly Film or Linen
MARTINEZ COUCH & ASSOCIATES, LLC


Martinez Couch

98 South Turnpike Road Wallingford, Connecticut 06492

Tel (203) 265-1002 Fax (203) 265-4449 email @martinezcouch.com

Associates


Land Surveyors - Engineers - Environmental Consultants

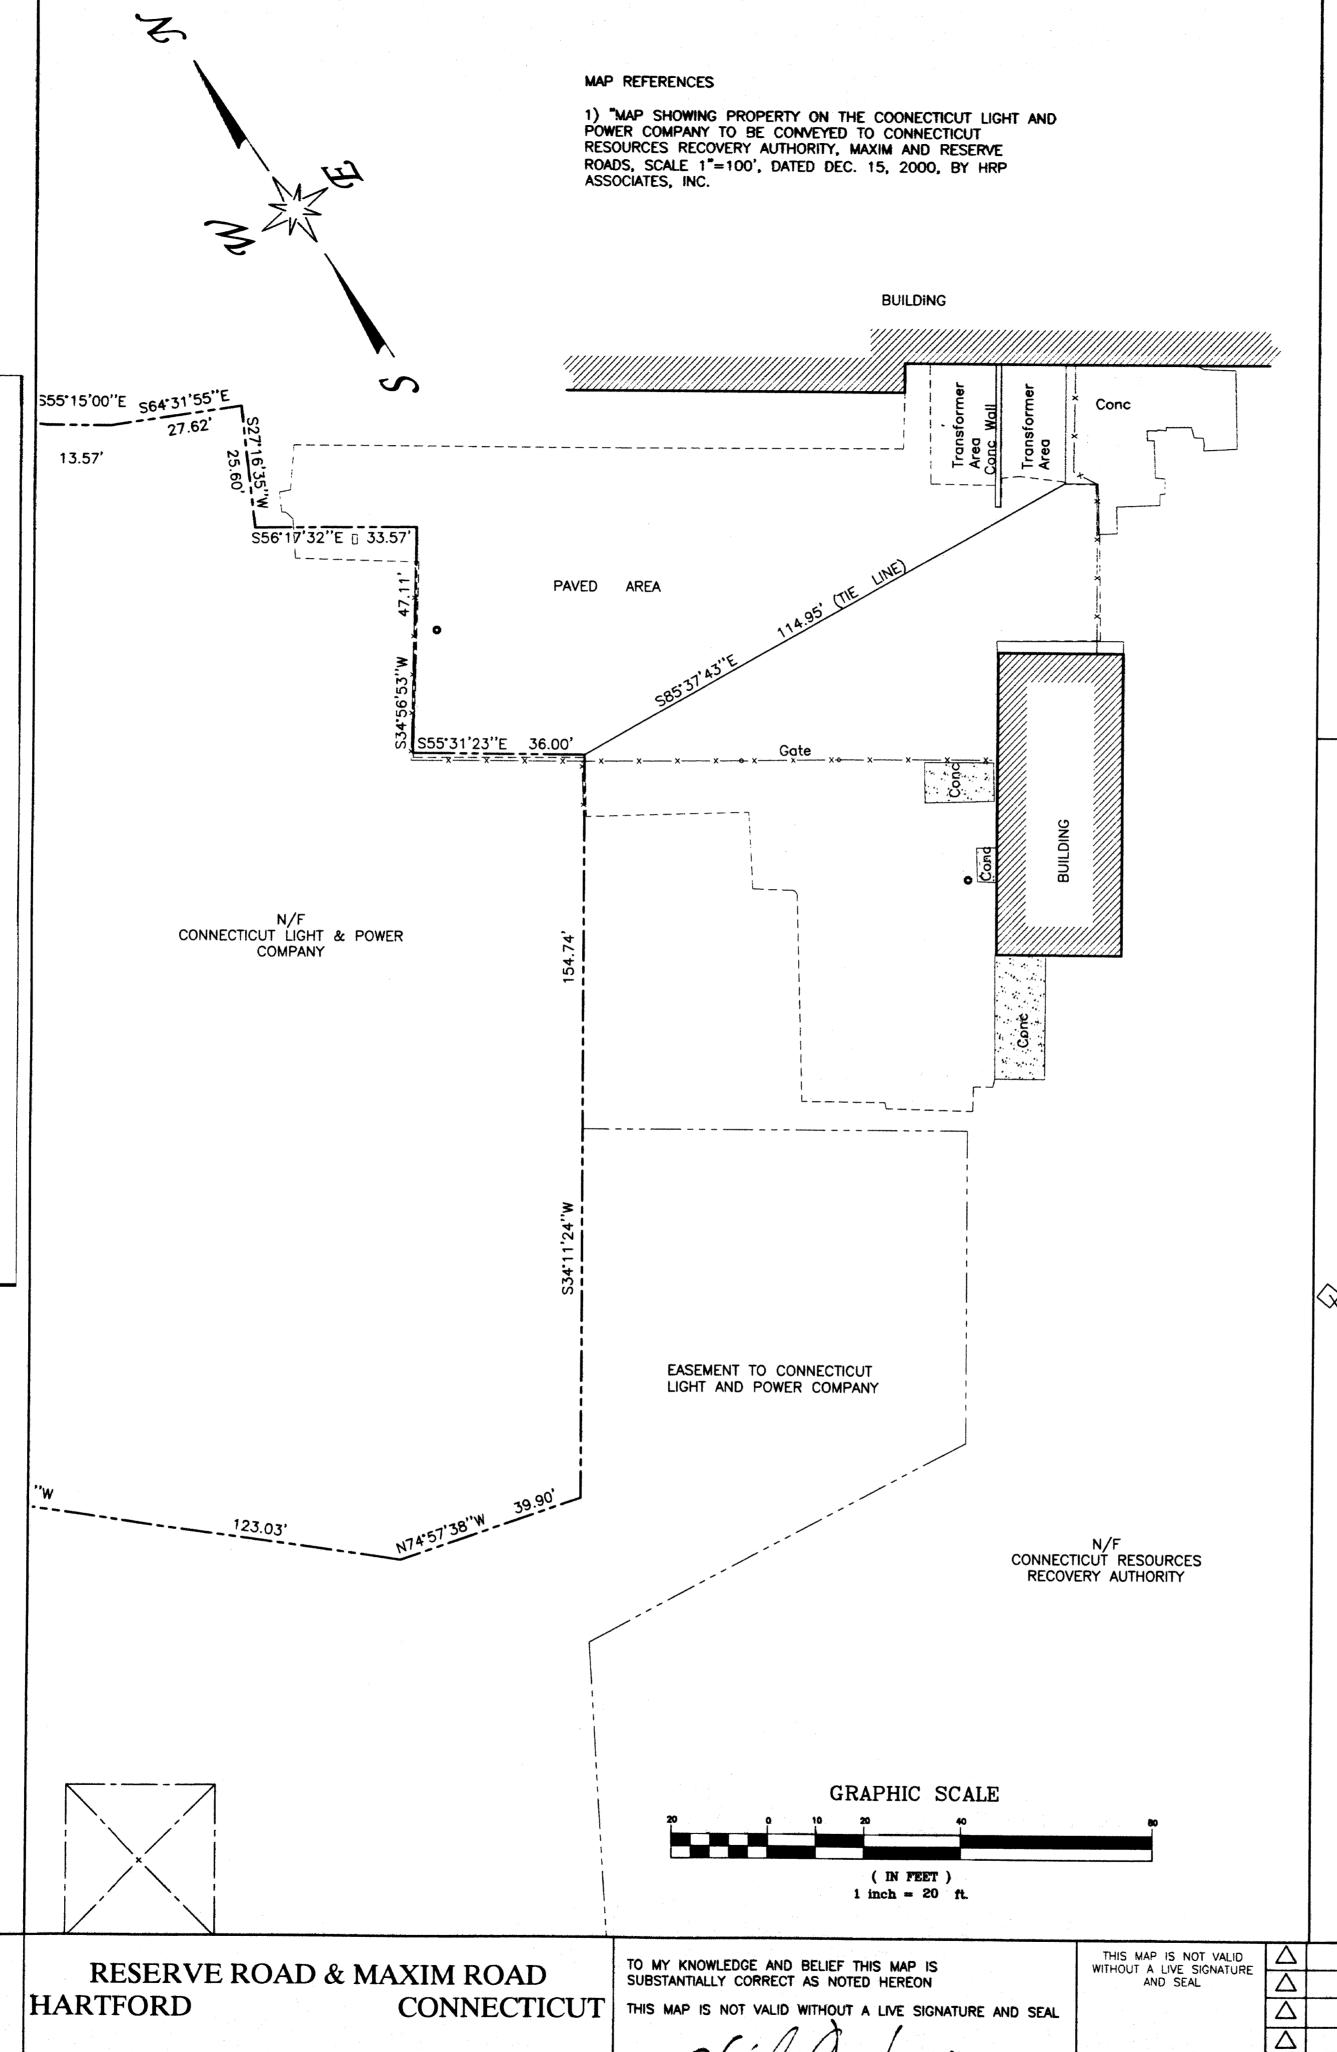

A. RAFAEL MARTINEZ LLS #18833

A. RAFAEL MARTINEZ LLS

PROPERTY OF CONNECTICUT RESOURCES RECOVERY **AUTHORITY**

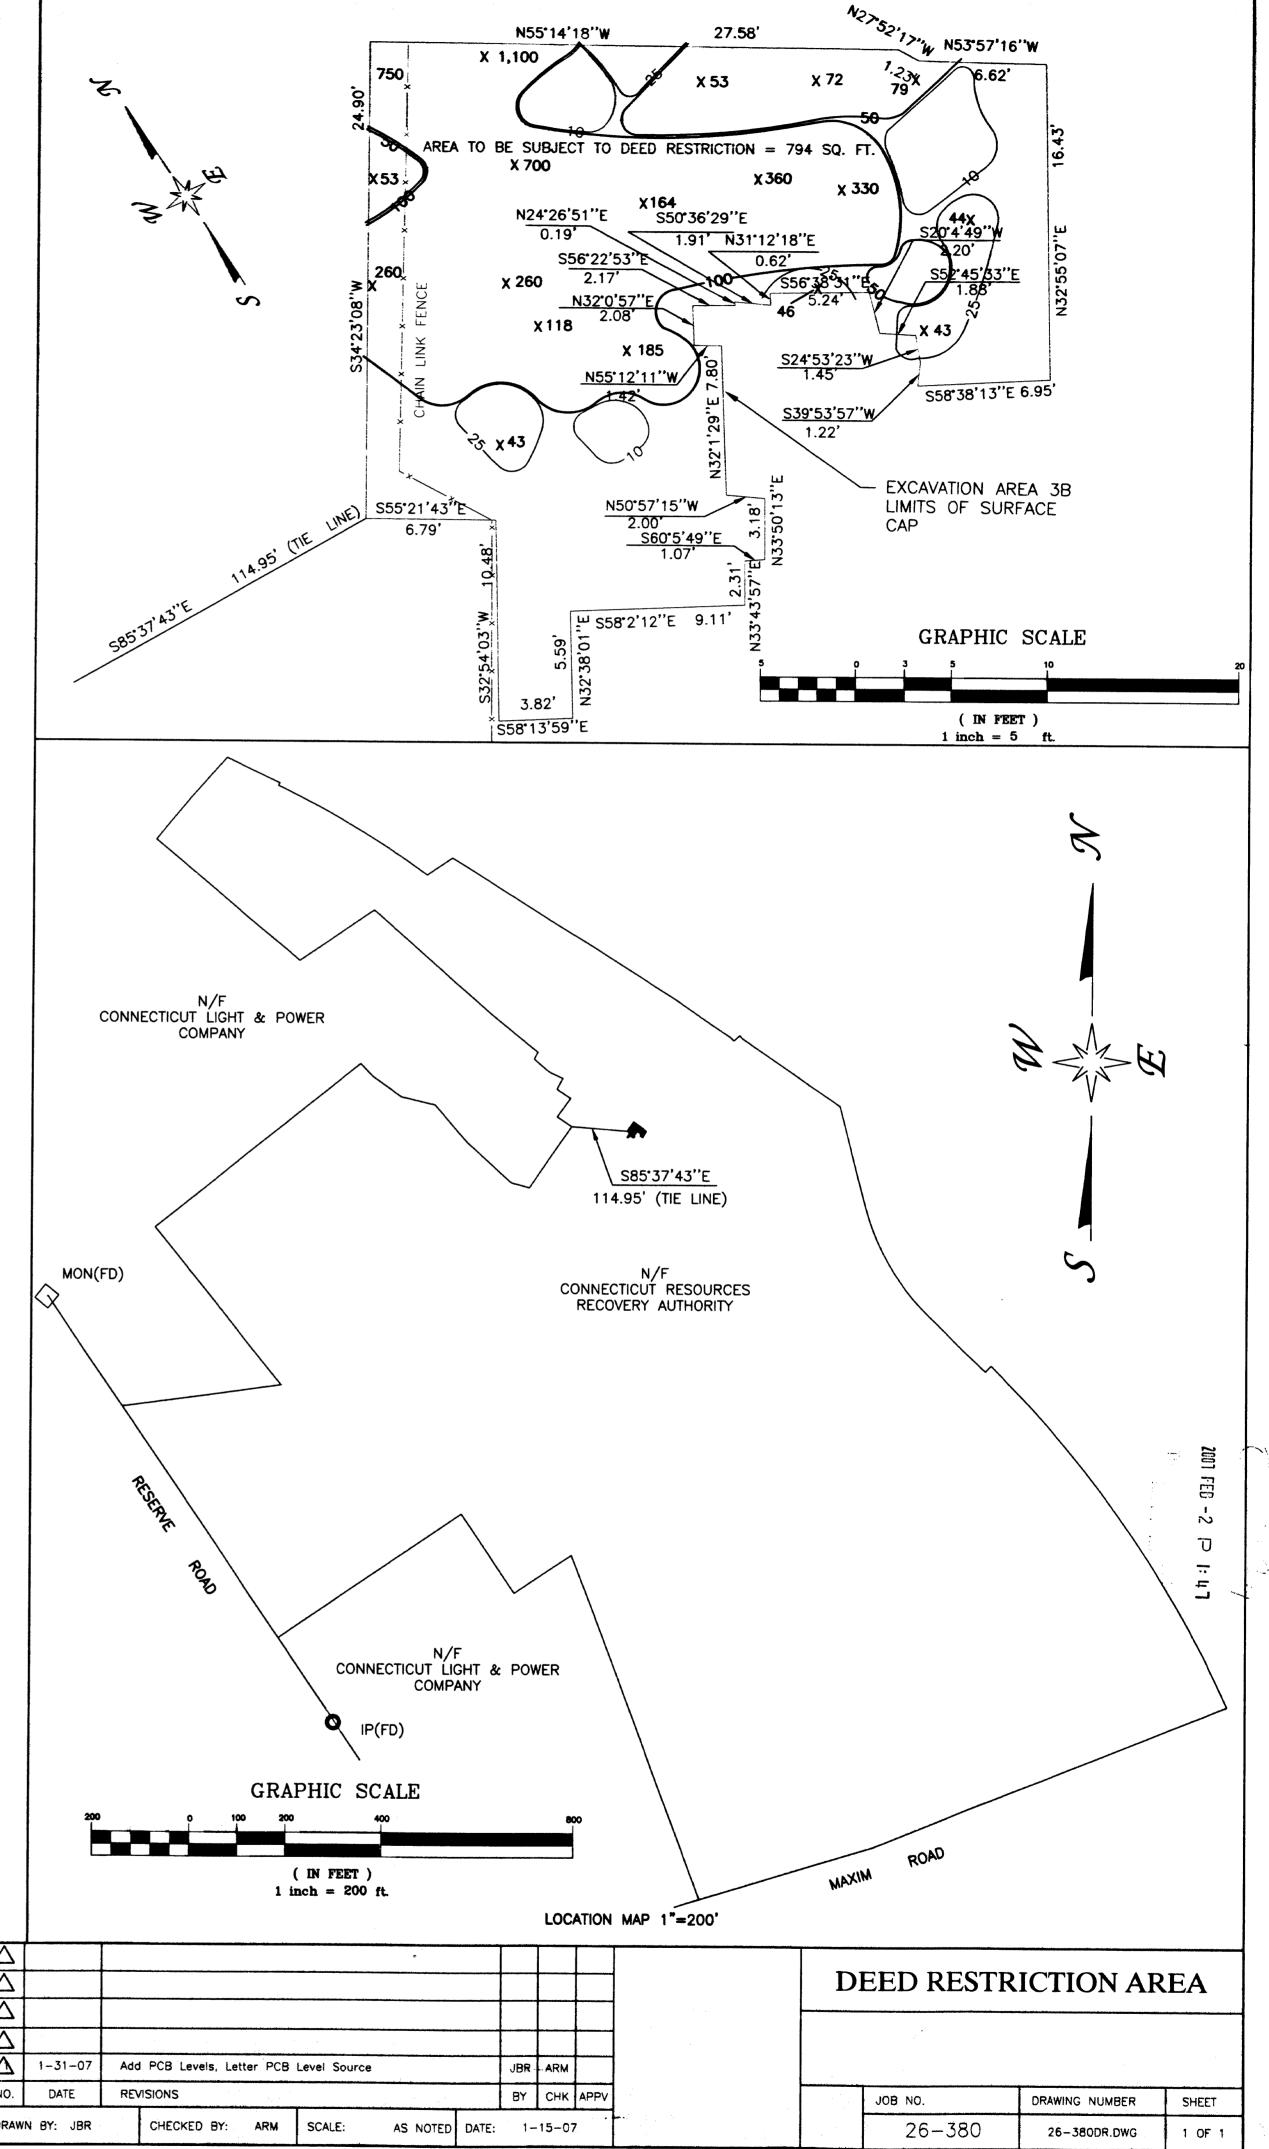

#2878