



Zone: B-4 & R-3
Area = 64 057 s.f. (1.47 ac.)

PROPOSED PARKING

Required Parking = 75
Provided Parking = 78
Standard Parking = 53
Compact Parking = 21
HC Parking = 4


Legend:
B = Bollard
D = Door
Dp = Dumpster
LP = Proposed Light Pole
NP = No Parking
WC = Wheel Check
--- = Proposed Bituminous Curb
--- = Proposed Concrete Curb
HC = HC Parking

#349-341
E.A. RODRIGUEZ n/f
Vol.4659, P.54
3 St. Brick

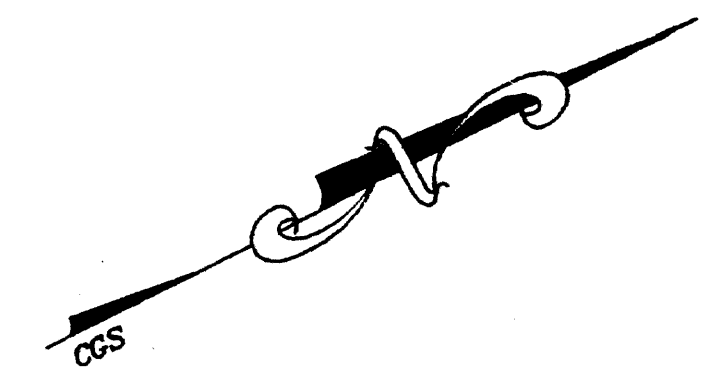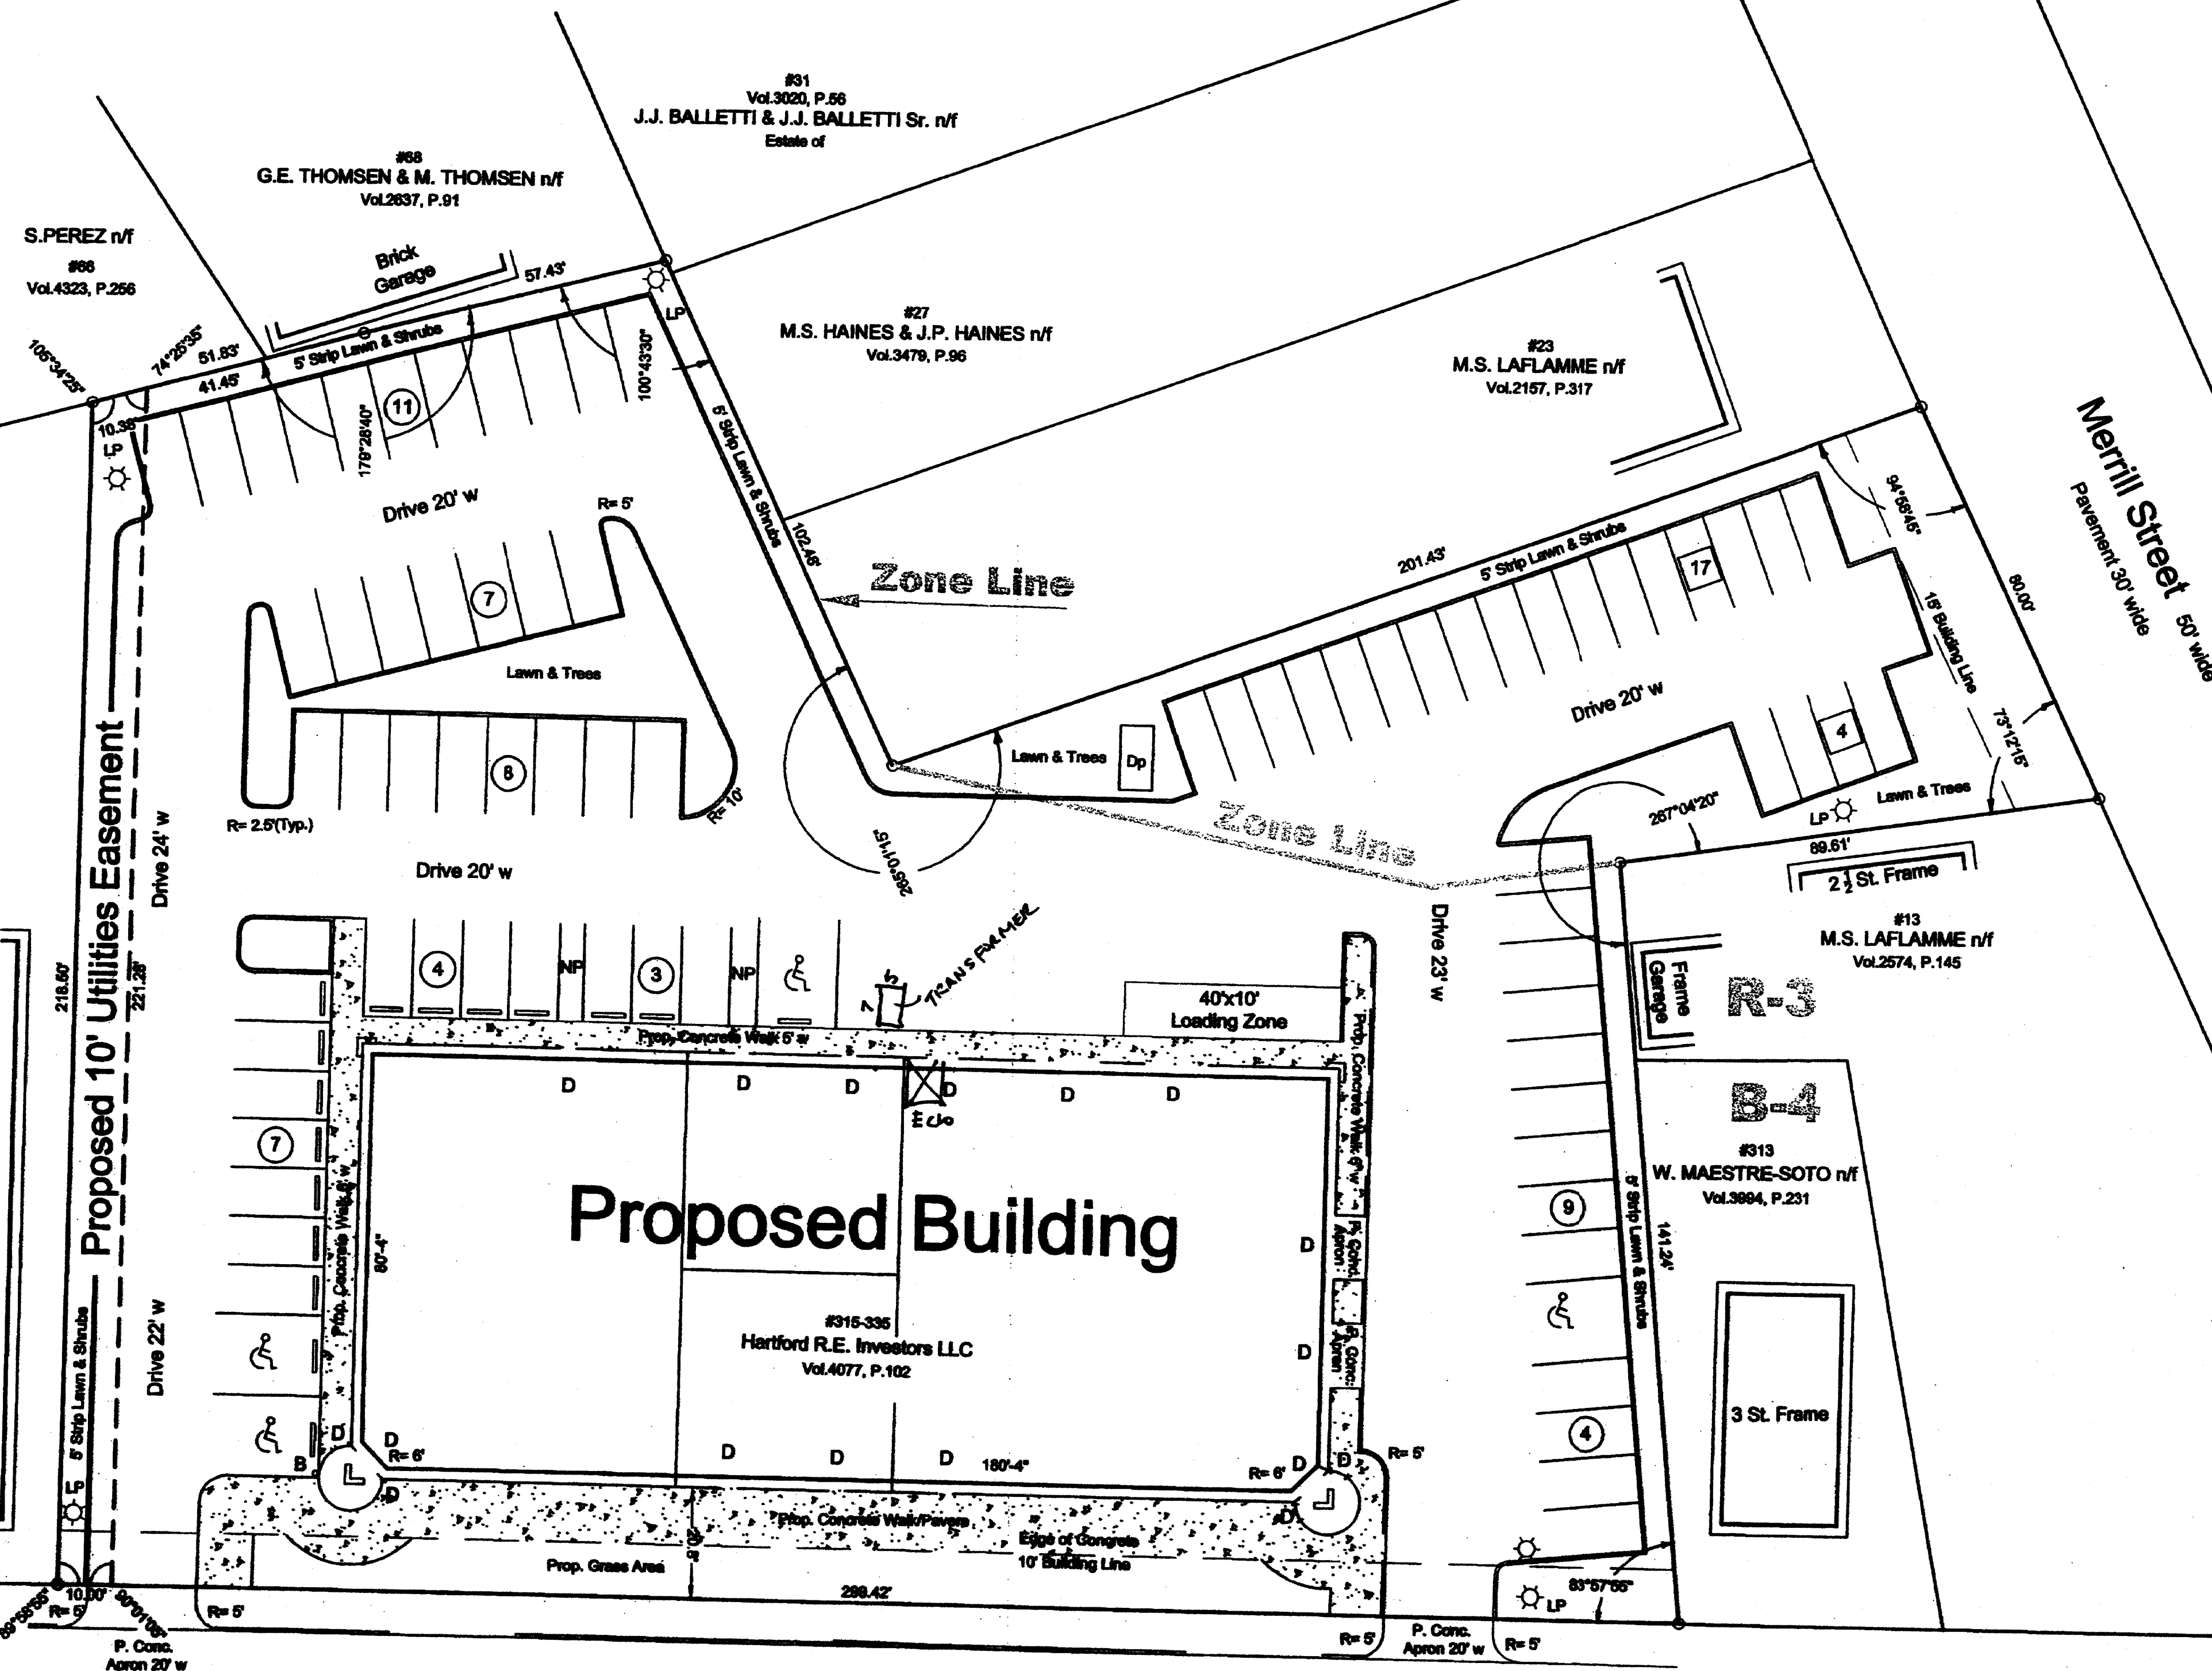

2000 MAY 13 A 11:35
TOM
[Signature]


Map Reference:
1. Property Survey of Premises owned by Haultain, Inc., 330
New Park Avenue Hartford, Connecticut Scale: 1"=50 feet
November, 1996 Prepared by Peterson & Hoffman, L.S.

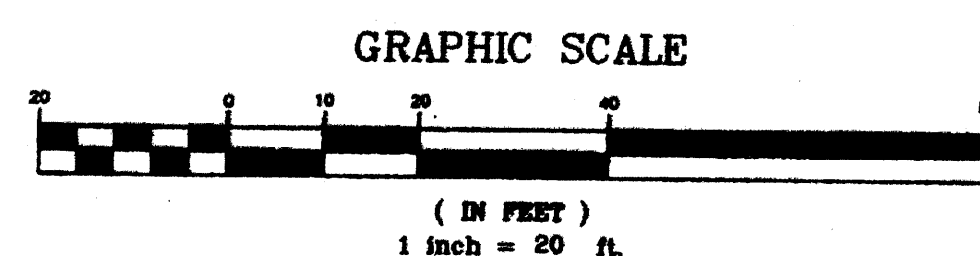

ORIGINAL INK DRAWING
ON MYLAR
PRODUCED BY
THE PRINTHOUSE LLC

New Park Avenue 70' wide
Pavement 54' wide

This survey has been prepared pursuant to the Regulations
of Connecticut State Agencies Sections 20-300 b-1 through
20-300 b-20 and the "Standards for Survey and Maps in
the State of Connecticut" as adopted by the Connecticut
Association of Land Surveyors, Inc. on September 26, 1996.

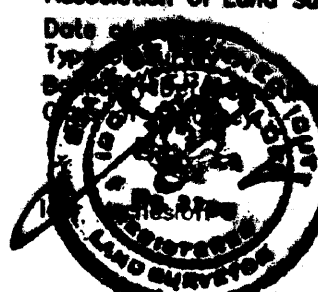

Category: Resurvey
A-2

CT Reg. No. 3756

Revision Table

NO.	DATE	DESCRIPTION
3	06-11-07	Proposed Easement
2	04-09-07	Misc.
1	03-26-07	Misc.

IGOR VECHESLOFF PROFESSIONAL ENGINEER & LAND SURVEYOR 51 LORRAINE STREET HARTFORD, CONNECTICUT	
SCALE: 1" = 20'	DATE: 03-10-07
2570	Drawing E-1

