


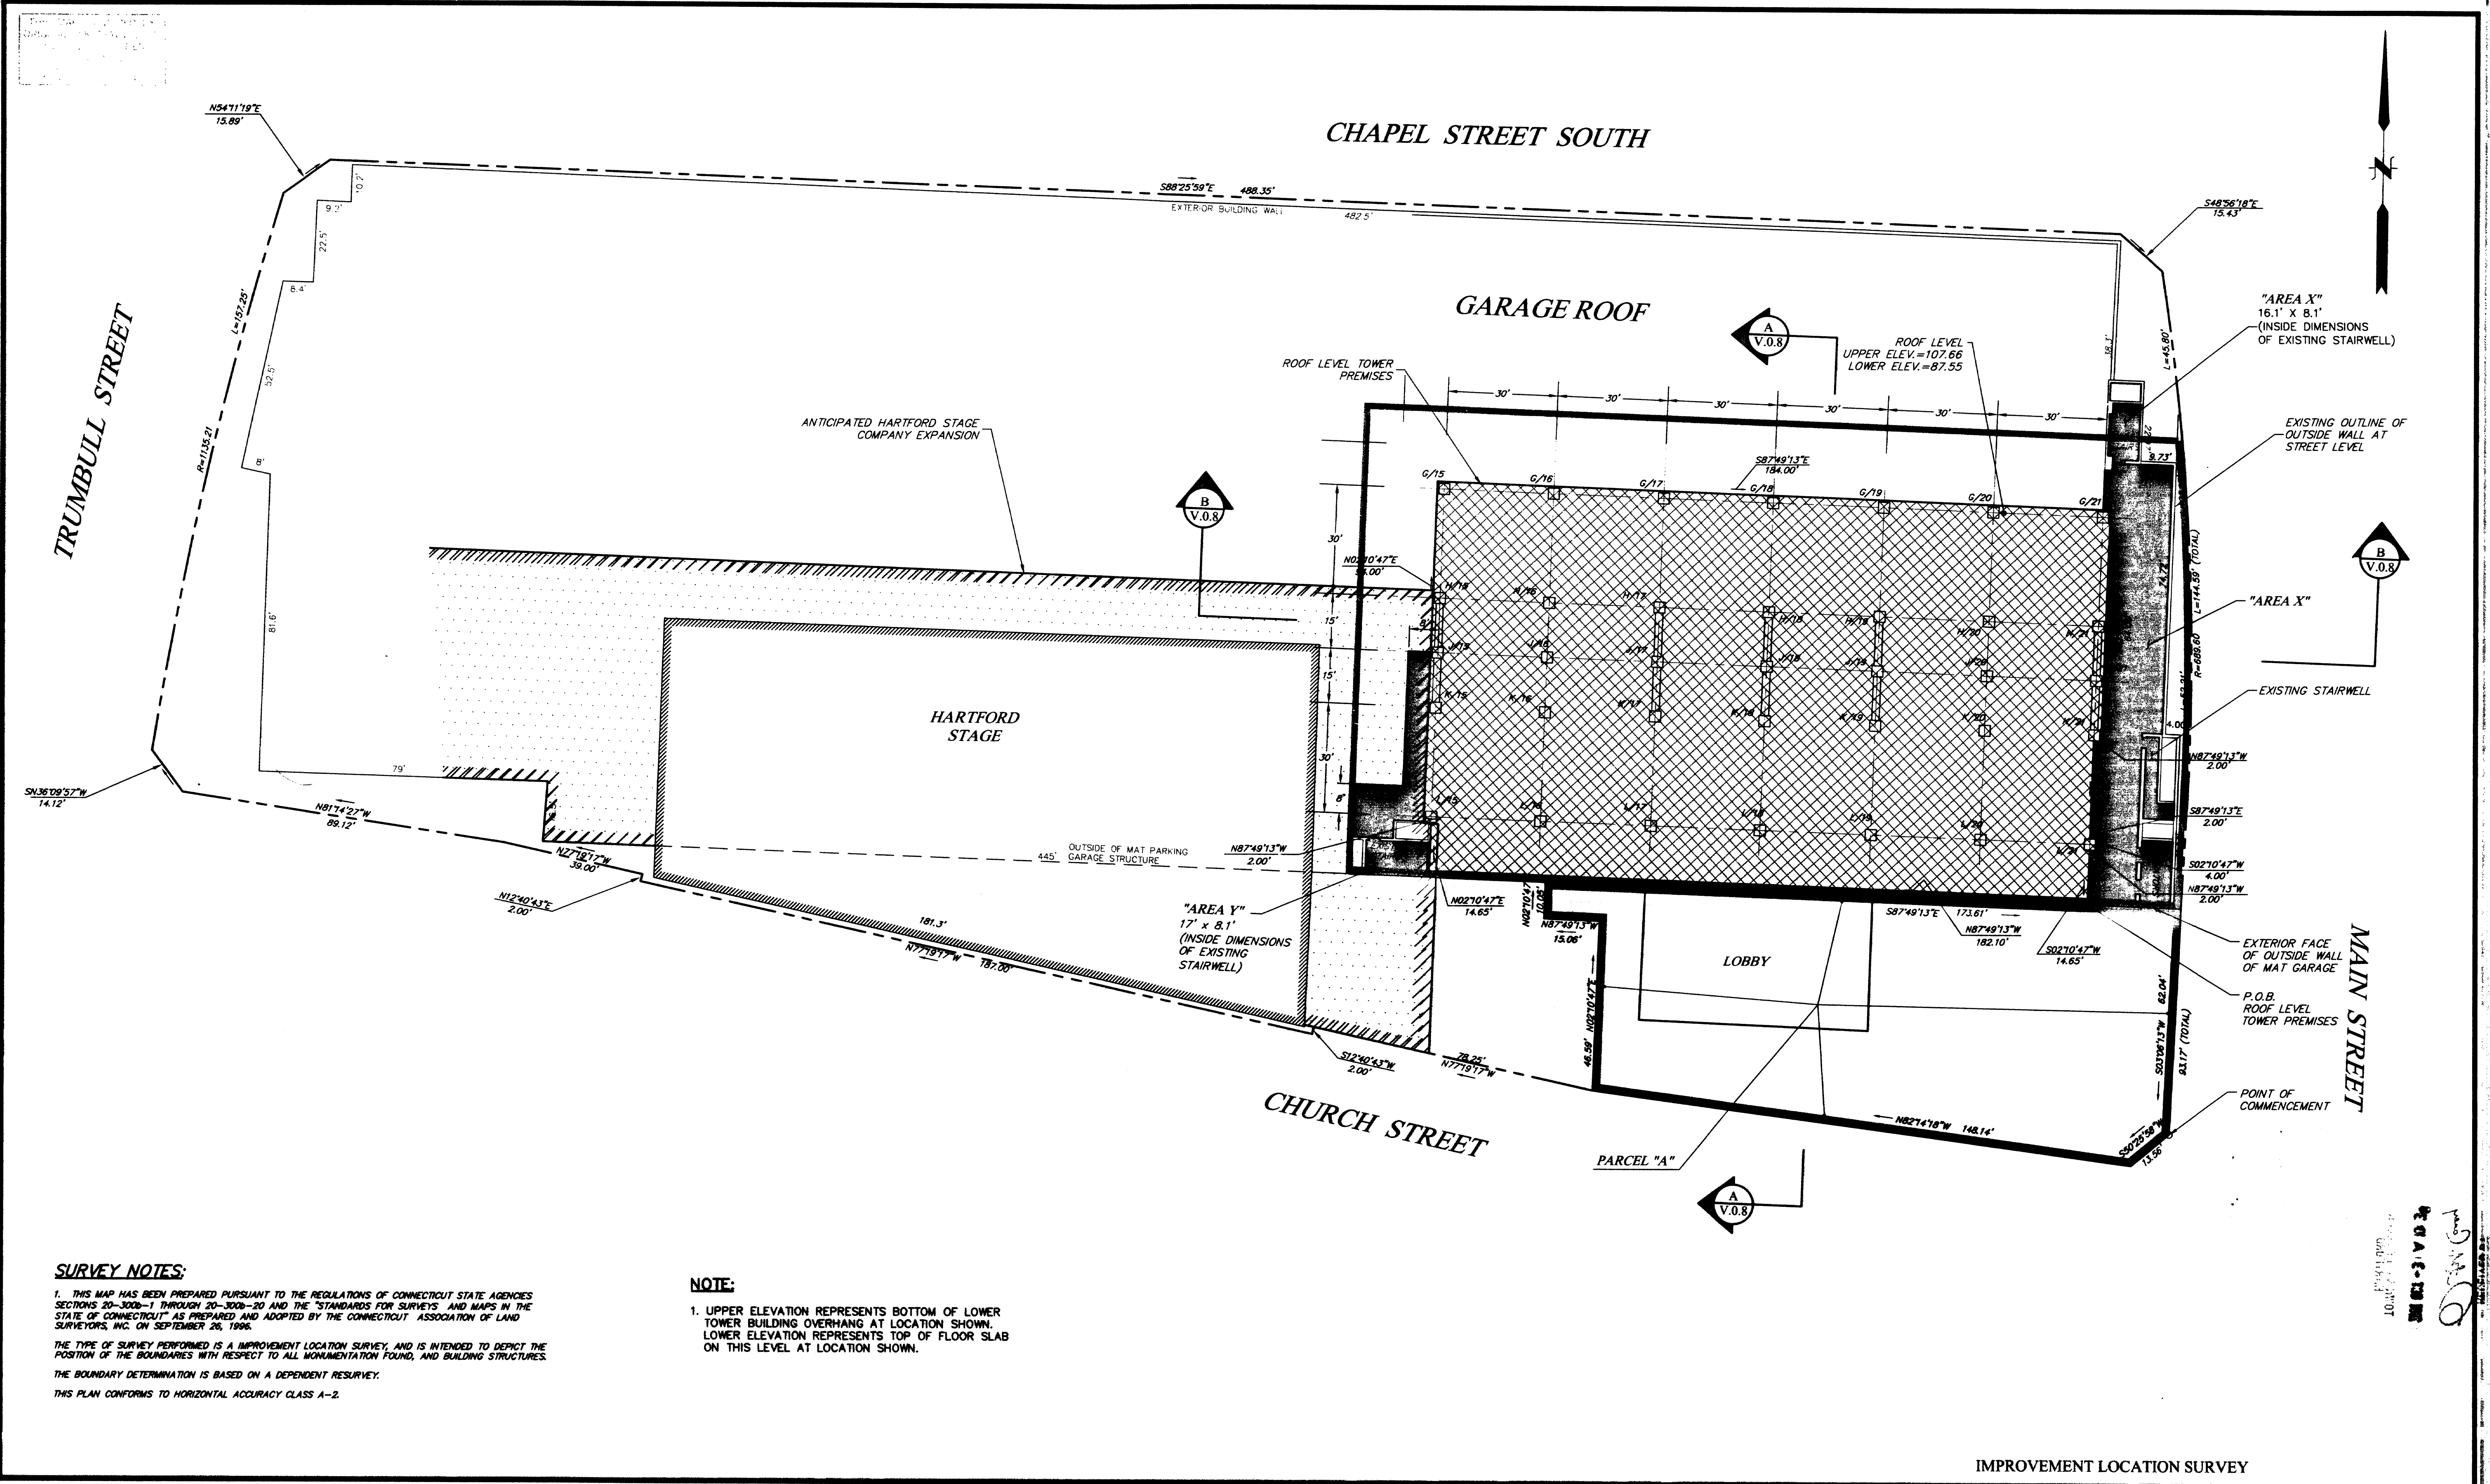

PROJ. MANAGER: CHIEF DESIGNER: REVIEWED BY:		SEAL SEAL TO MY KNOWLEDGE AND BELIEF, THESE MAPS ARE SUBSTANTIALLY CORRECT AS NOTED HEREON. DAVID A. CARICCHIO 70036 LICENSE No.		SCALE: HORZ.: 1" = 20' VERT.: DATUM: HORZ.: VERT.: GRAPHIC SCALE		WWW.FAND0.COM FUSS & O'NEILL Discipline: Deliver 146 HARTFORD RD MANCHESTER, CT 06040 860.646.2469		20 CHURCH STREET ROOF PLAN PREPARED FOR THE CITY OF HARTFORD MAIN ST., CHURCH ST. & CHAPEL ST. SOUTH HARTFORD, CT		PROJ. No.: 1987279 C80 DATE: AUG. 29, 2008 V.0.2	
---	--	---	--	--	--	--	--	--	--	---	--