


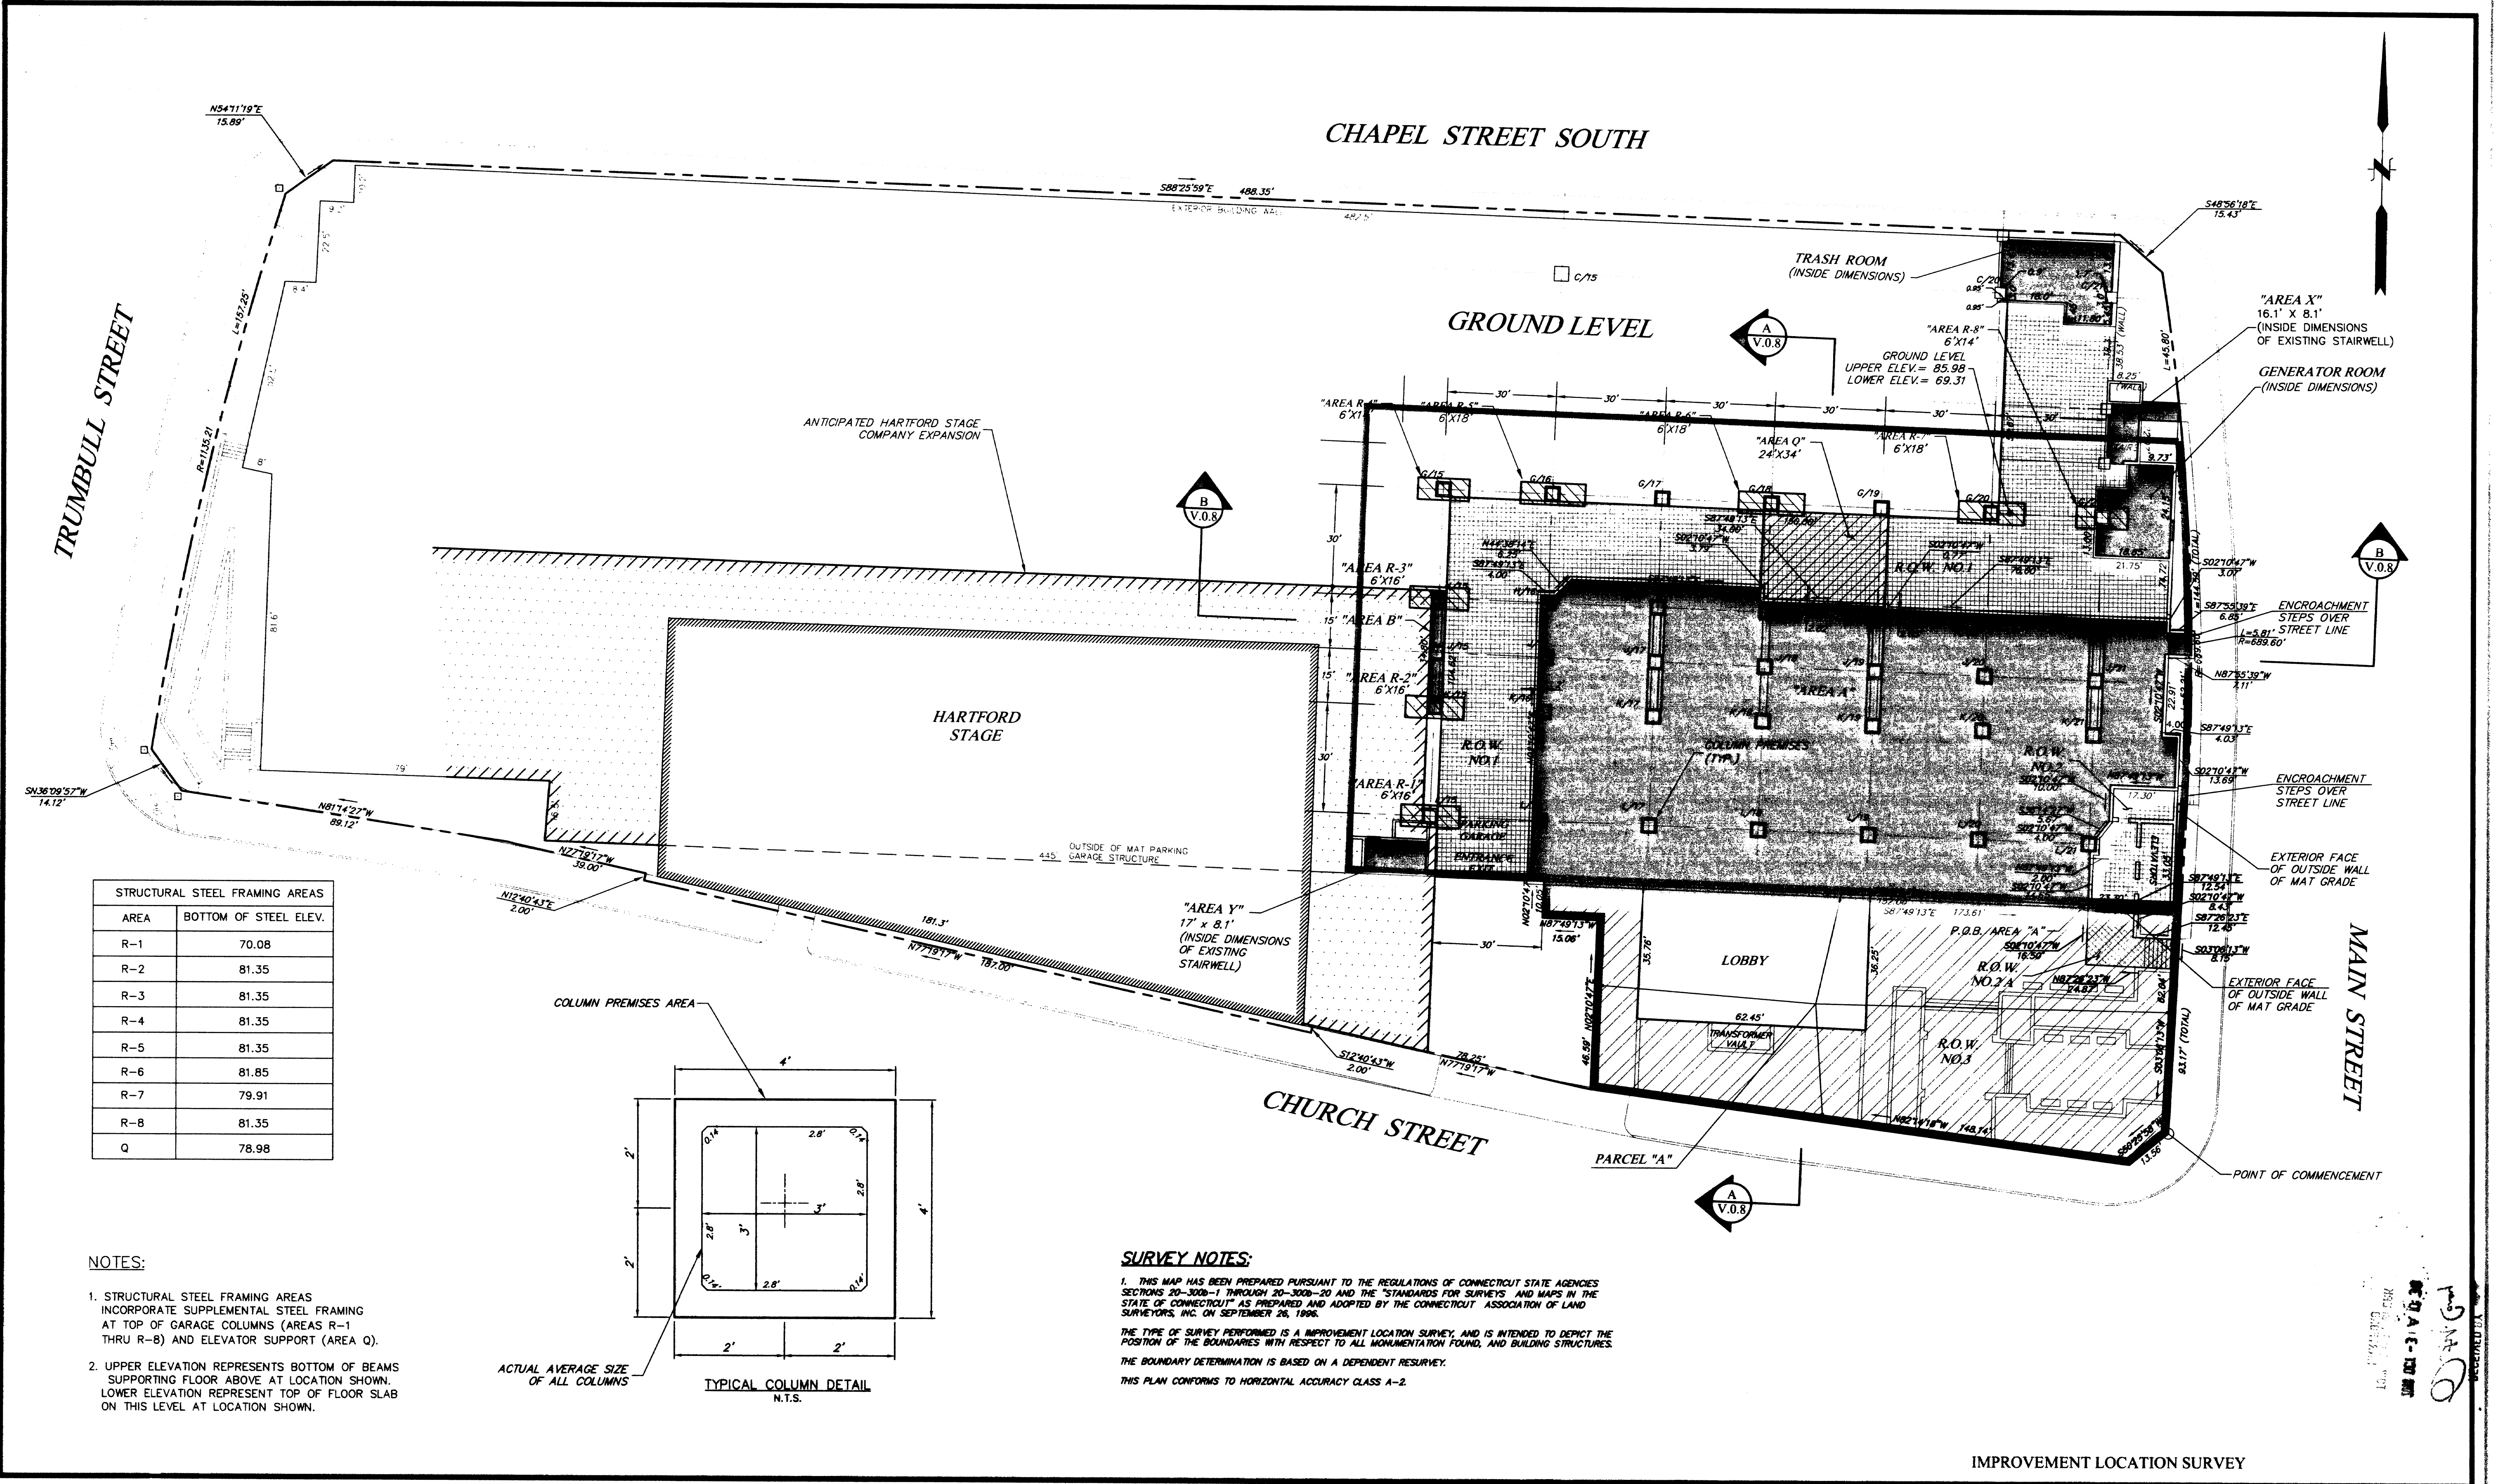

PROJ. MANAGER:		SEAL		TO MY KNOWLEDGE AND BELIEF, THESE MAPS ARE SUBSTANTIALLY CORRECT AS NOTED HEREON.		SCALE:		WWW.FondO.COM		20 CHURCH STREET		PROJ. No.: 1997279.C80	
CHIEF DESIGNER:		SEAL		DAVID A. CARICCHIO		HORIZ.: 1" = 20'		FUSS & O'NEILL		GROUND LEVEL PLAN		DATE: AUG. 29, 2008	
REVIEWED BY:		SEAL		40036		VERT.:		Discipline to Deliver		PREPARED FOR		V.0.3	
DATE		DATE		LICENSE No.		DATUM:		146 HARTFORD RD		THE CITY OF HARTFORD			
DESCRIPTION		BY				HORIZ.:		MANCHESTER, CT 06040		MAIN ST., CHURCH ST. & CHAPEL ST. SOUTH			
REVISIONS						VERT.:		860.646.2469		HARTFORD, CT			
						GRAPHIC SCALE							