


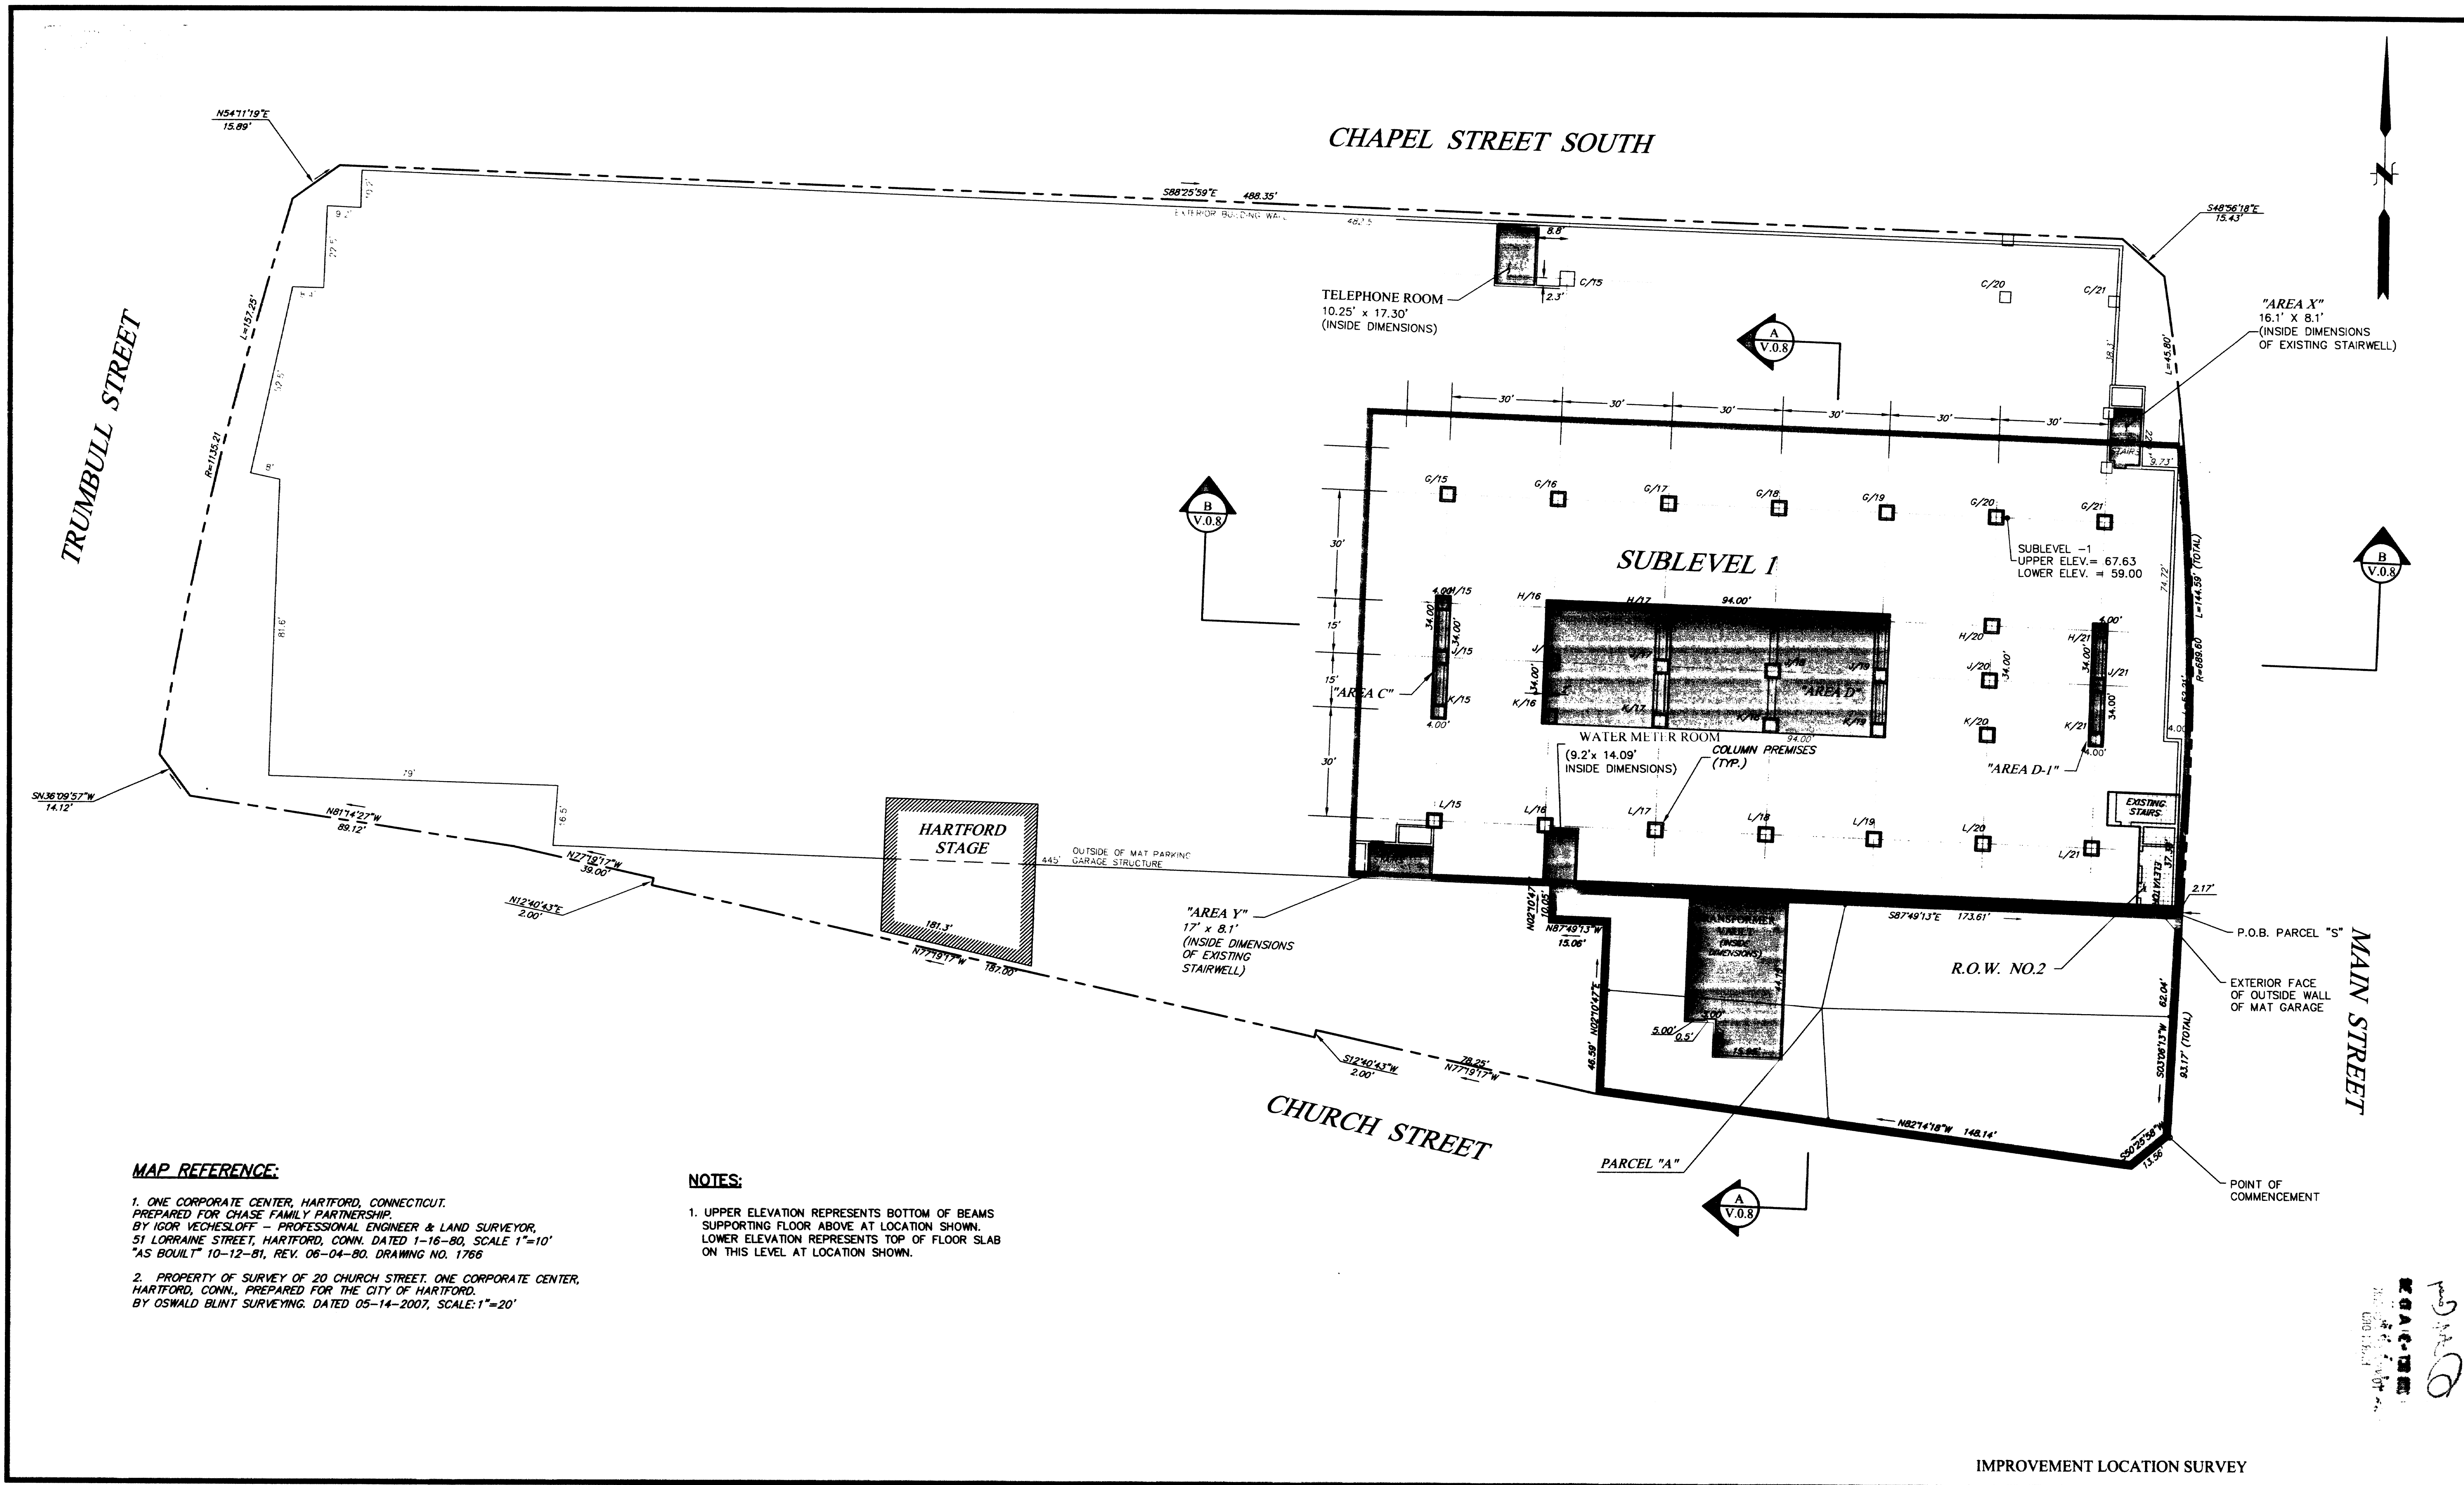

1. DATE		DESCRIPTION		BY	REVISIONS
PROJ. MANAGER: _____ CHIEF DESIGNER: _____ REVIEWED BY: _____ DATE: _____					
SEAL		SEAL		TO MY KNOWLEDGE AND BELIEF, THESE MAPS ARE SUBSTANTIALLY CORRECT AS NOTED HEREON.	
				DAVID A. CARICCHIO 70036 LICENSE No.	
SCALE:		SCALE:		SCALE:	
HORIZ.: 1" = 20'		HORIZ.: 1" = 20'		HORIZ.: 1" = 20'	
VERT.: 1" = 20'		VERT.: 1" = 20'		VERT.: 1" = 20'	
GRAPHIC SCALE		GRAPHIC SCALE		GRAPHIC SCALE	
146 HARTFORD RD MANCHESTER, CT 06040 860.646.2469		146 HARTFORD RD MANCHESTER, CT 06040 860.646.2469		146 HARTFORD RD MANCHESTER, CT 06040 860.646.2469	
20 CHURCH STREET SUBLEVEL-1 PLAN PREPARED FOR THE CITY OF HARTFORD MAIN ST., CHURCH ST. & CHAPEL ST. SOUTH HARTFORD, CT		20 CHURCH STREET SUBLEVEL-1 PLAN PREPARED FOR THE CITY OF HARTFORD MAIN ST., CHURCH ST. & CHAPEL ST. SOUTH HARTFORD, CT		20 CHURCH STREET SUBLEVEL-1 PLAN PREPARED FOR THE CITY OF HARTFORD MAIN ST., CHURCH ST. & CHAPEL ST. SOUTH HARTFORD, CT	
PROJ. No.: 1997279.C80 DATE: AUG. 29, 2008		PROJ. No.: 1997279.C80 DATE: AUG. 29, 2008		PROJ. No.: 1997279.C80 DATE: AUG. 29, 2008	
V.0.4		V.0.4		V.0.4	