
RECEIVED BY

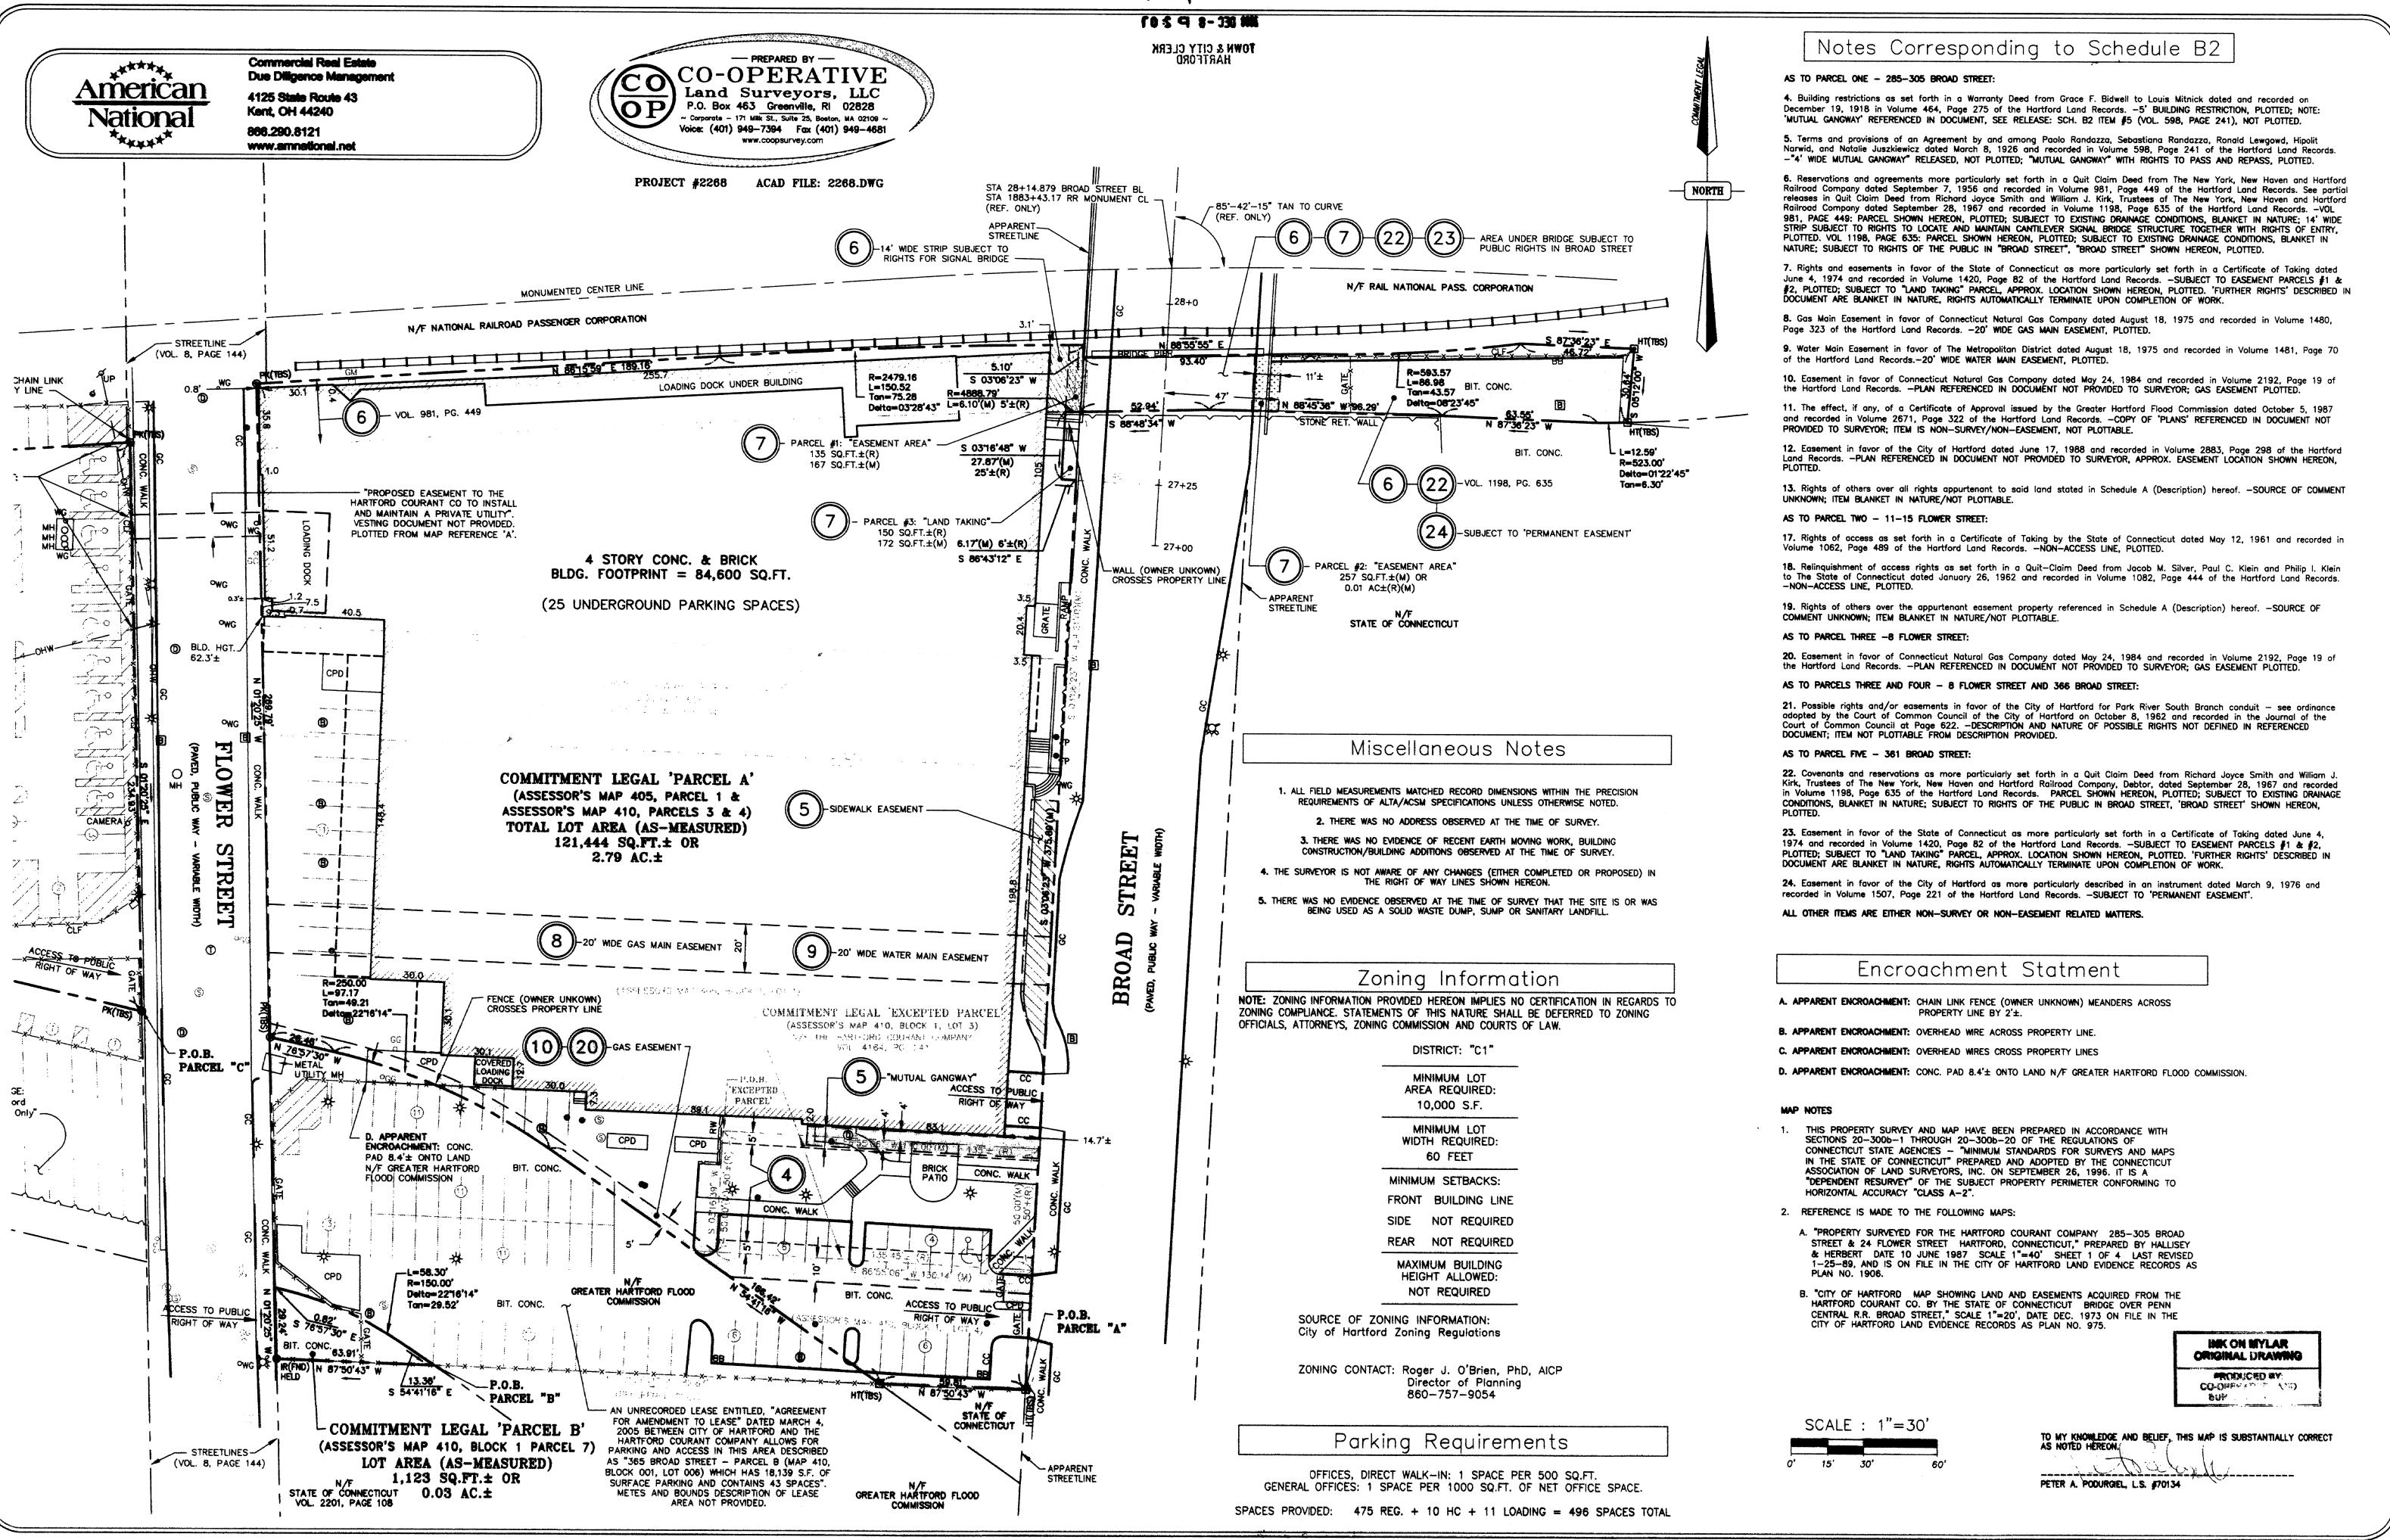

Sheet 2 of 2