

Office of the
TOWN & CITY CLERK
HARTFORD

COLUMBUS BOULEVARD

GROVE STREET

INTERSTATE 91 S.B.

RAMP TO HIGHWAY


- LEGEND
(SYMBOLS NOT TO SCALE)
- CATCH BASIN
 - STEAM MANHOLE
 - SANITARY MANHOLE
 - DRAINAGE MANHOLE
 - WATER MANHOLE
 - TELEPHONE MANHOLE
 - ELECTRIC MANHOLE
 - UNKNOWN MANHOLE
 - YARD DRAIN
 - CABLE MANHOLE
 - FLARED END SECTION
 - FIRE HYDRANT
 - WATER GATE VALVE
 - GAS GATE VALVE
 - MISC. GATE VALVE
 - VENT PIPE
 - FILL CAP
 - WELL
 - MAIL BOX
 - HAND HOLE
 - CONTROLLER CABINET
 - ELECTRIC TRANSFORMER
 - UTILITY POLE
 - GUY WIRE
 - CROSSWALK POLE
 - LIGHT POLE
 - POST
 - TRAFFIC LIGHT SUPPORT POLE
 - STREET SIGN
 - TREE (TYP.)
 - MONITOR WELL
 - BORING
 - ELECTRIC METER
 - GAS METER
 - WATER METER
 - TELEPHONE
 - AC UNIT
 - TREE LINE
 - STONE WALL
 - GUIDE RAIL
 - DIRECTION OF FLOW
 - 1/4" PROPERTY CORNER
 - MONUMENT
 - DRILL HOLE
 - SURVEY CONTROL POINT
 - FENCE LINE
 - WATER LINE
 - GAS LINE
 - ELECTRIC LINE
 - CABLE TELEVISION LINE
 - OVERHEAD WIRES
 - POINT OF BEGINNING
 - NORTHING
 - EASTING
 - HOW OF FORMERLY
 - HARTFORD LAND RECORDS
 - DELTA ANGLE
 - RADIUS
 - TANGENT
 - LENGTH
 - CHORD
 - CHORD BEARING
 - FRONT YARD
 - SIDE YARD
 - REAR YARD
 - CONTROL POINT
 - TREE & TREE GRATE

BY UTILITY EASEMENT IN FAVOR OF THE STATE OF CONNECTICUT FILE NO. 1008 PR. 923
ALL R. VOL. 4006 P. 100 TO BE ASSIGNED TO THE METROPOLITAN DISTRICT

FIN. FLOOR = 28.0'

OUTSIDE EDGE OF FOUNDATION WALL

ENTRY TO UNDER DECK
PARKING GARAGE

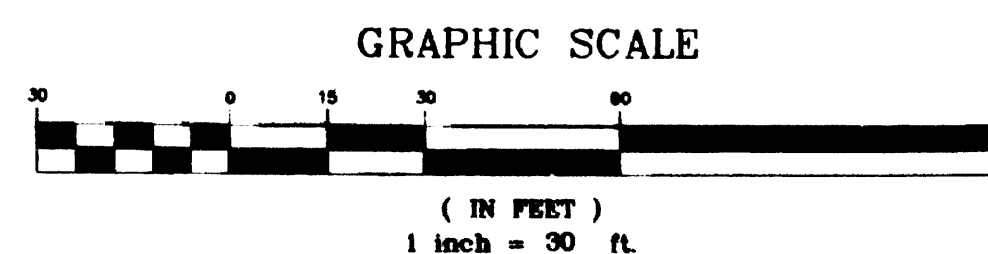

THIS MAP PRODUCED BY
ORIGINAL LINE DRAWING
ON EXISTING RECORD
AND FIELD SURVEY
BY
F. A. HESKETH & ASSOCIATES, INC.
HARTFORD, CT

SEE SHEET 1 FOR NOTES,
MAP REFERENCES AND
CERTIFICATION.

CONDITIONS AS OF MAY 1, 2009
UNDERGROUND UTILITY BELOW 26±


IMPROVEMENT LOCATION PLAN - RECORD
PREPARED FOR
THE WHITING-TURNER
CONTRACTING COMPANY
CONNECTICUT SCIENCE CENTER, INC.

HARTFORD, CONNECTICUT

Date: 05-01-09 Drawn by: CAD Job no.: 05007
Scale: 1" = 30' Checked by: TSH Sheet no. 3 of 3

Connecticut Science Center, Inc.
Hartford, Connecticut

F. A. Hesketh & Associates, Inc.
6 Creamery Brook, East Granby, CT 06026
Civil & Traffic Engineers - Surveyors - Planners - Landscape Architects

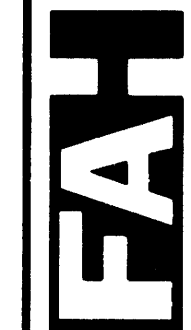

Phone: (860) 653-8000
Fax: (860) 644-8000
e-mail: info@fah.com

3

3033