
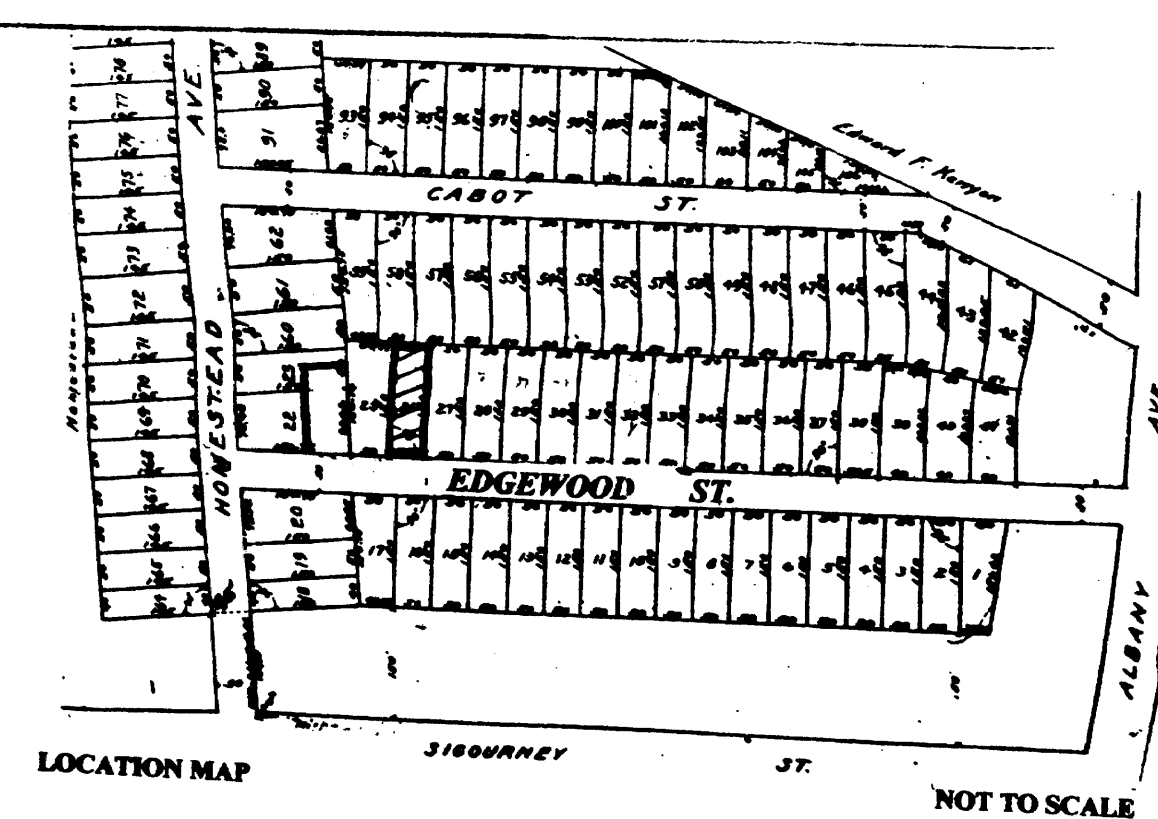


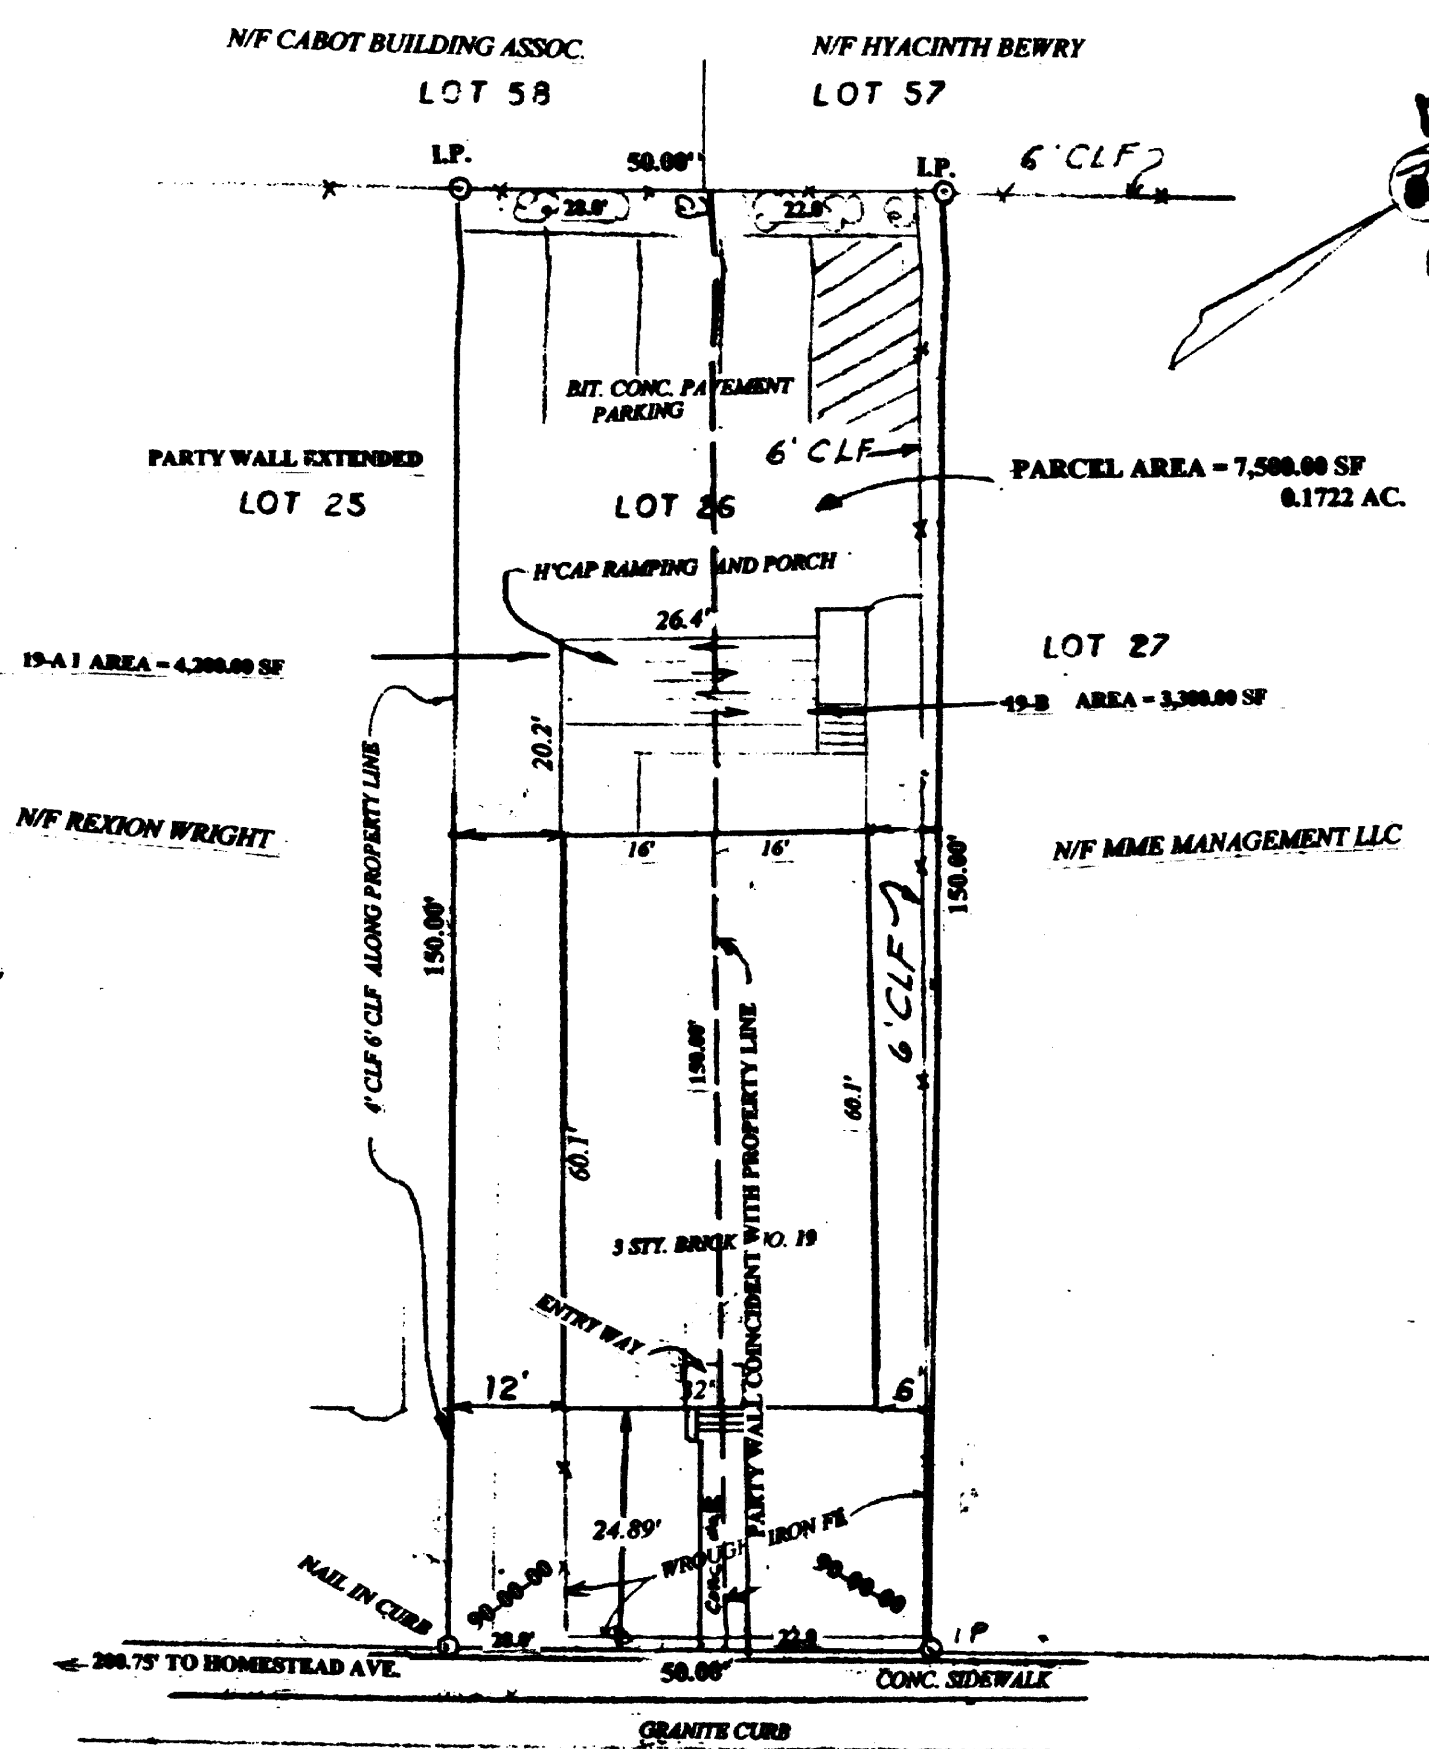

REF. "HOMESTEAD PARK SUBDIVISION HARTFORD, CONN. SCALE 1" = 100' JUNE 1906
SPENCER AND WASHBURN, ENGINEERS"

**PROPERTY SURVEY
PREPARED FOR
CHRISTIAN ACTIVITIES COUNCIL
19 EDGEWOOD ST. & 21 EDGEWOOD ST. HARTFORD CONN.
SCALE 1"= 20'**

APRIL 8, 2009
REV. JULY 17, 2009

JULY 17, 2009
PREPARED BY: DELMASTRO SURVEY
32 SAWMILL ROAD
ROCKY HILL, CONN.

I HEREBY DECLARE THAT THIS MAP IS SUBSTANTIALLY CORRECT. THIS MAP AND SURVEY WERE PREPARED IN ACCORDANCE WITH THE STANDARDS OF A CLASS A-2 SURVEY IN ACCORDANCE WITH SECTIONS 20-300b THROUGH 20-300b20 OF THE REGULATIONS OF THE CONNECTICUT STATE AGENCIES "MINIMUM STANDARDS FOR SURVEYS AND MAPS IN THE STATE OF CONNECTICUT" AS ENDORSED BY THE CONNECTICUT ASSOCIATION OF LAND SURVEYORS INC.

TYPE OF SURVEY: ZONING LOCATION
BOUNDARY DETERMINATION CATAGORY: DEPENDENT RESURVEY OF MAP REFERENCES
EMILIO J. DELMASTRO
LS. 7384

This drawing reproduced in accordance with state filing regulations. Process used: Ink on Mylar
Joseph Morris & Company

3034

