


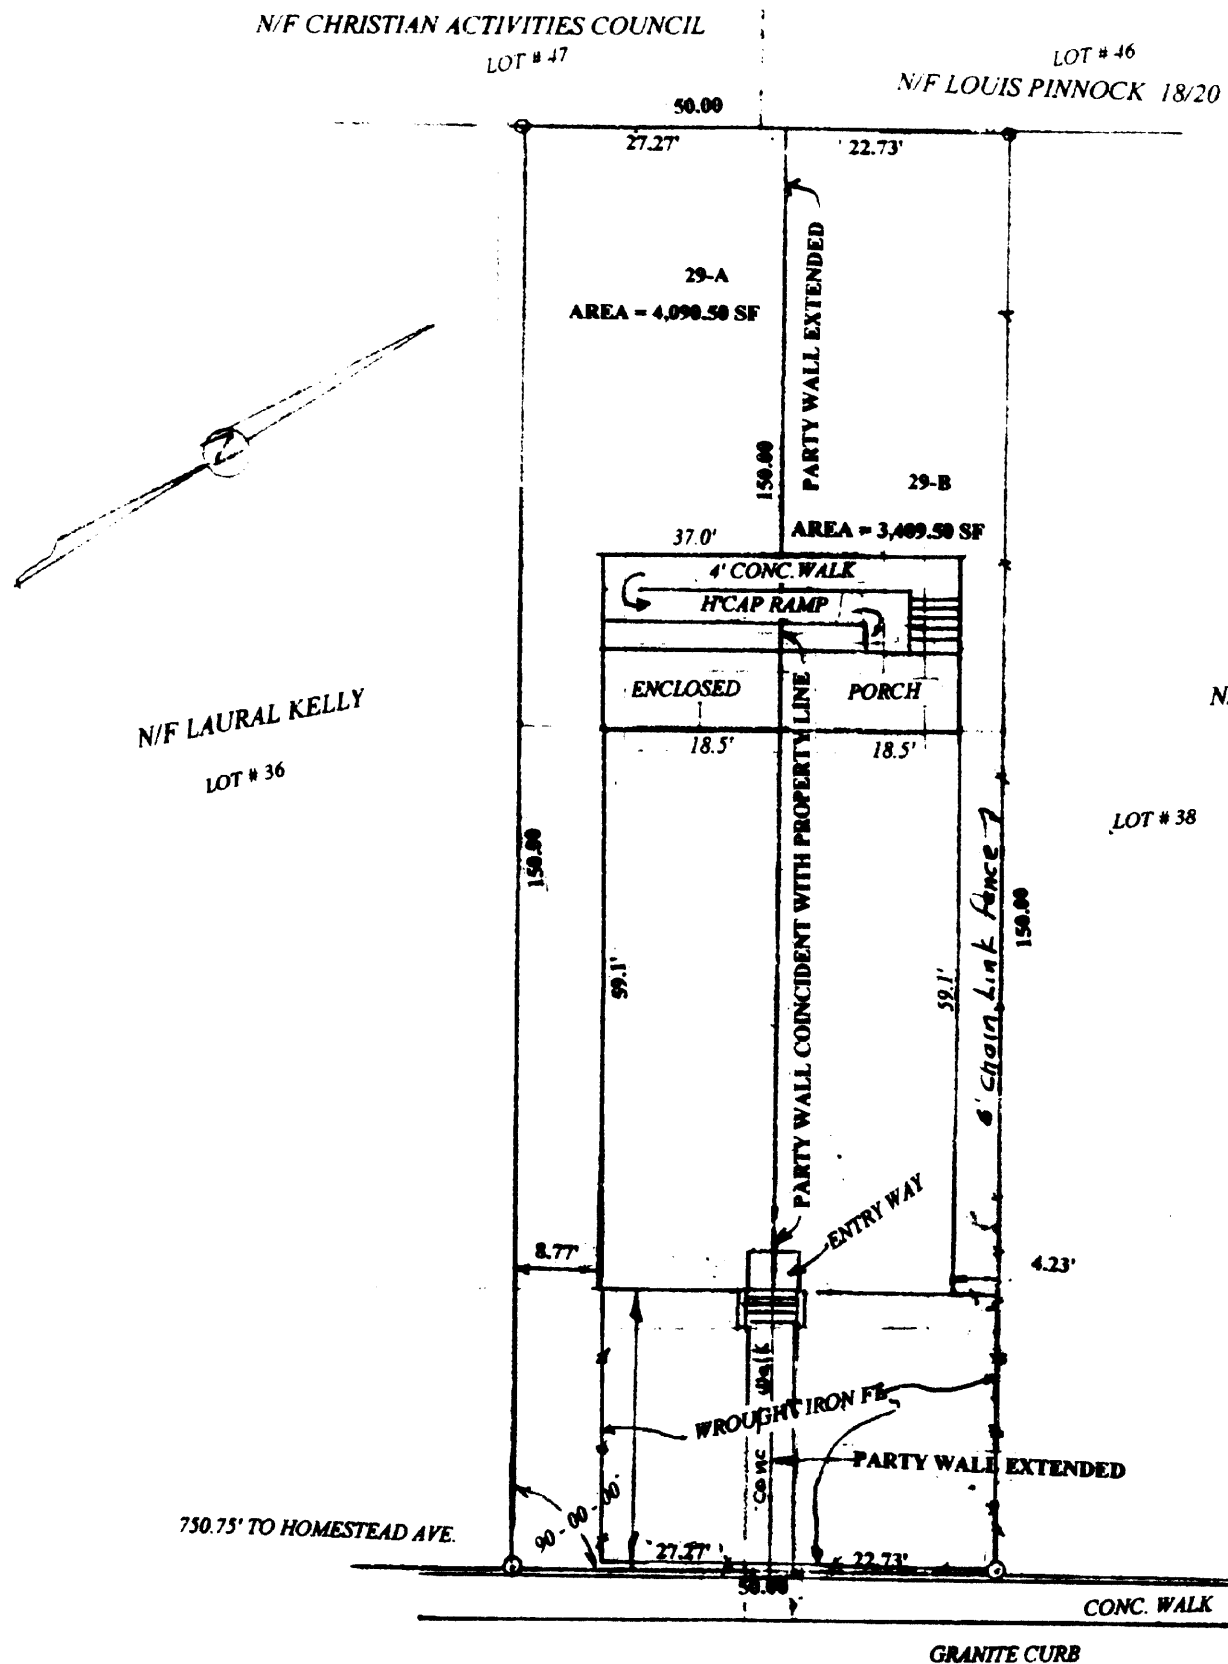

N/F LAURAL KELLY
LOT # 36

LOT # 46
N/F LOUIS PINNOCK 18/20


N/F RAYMOND H. LILBURN

LOT # 38

EDGEWOOD STREET

THIS drawing reproduced by
combining with state filing
regulations. Process used:
ink on Mylar
Joseph Manti & Company

YU 0315034
NORTH
N

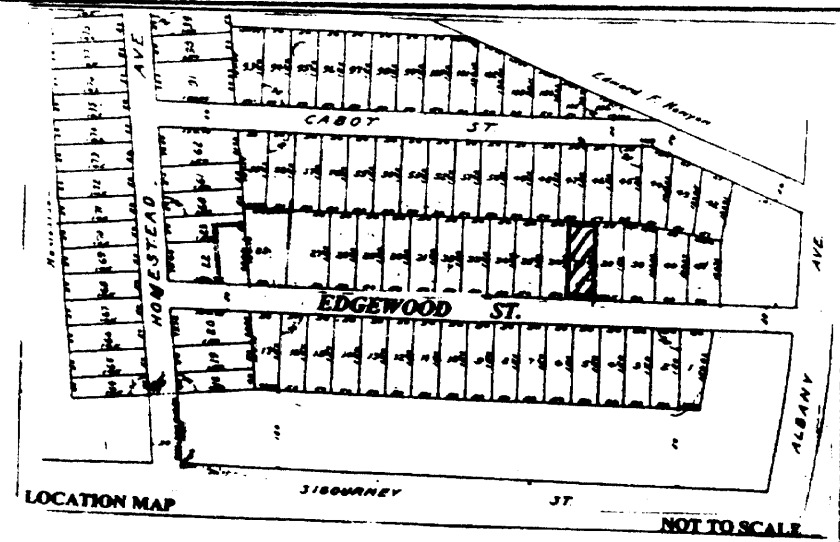

REF: "HOMESTEAD PARK SUBDIVISION HARTFORD, CONN. SCALE 1" = 100' JUNE 1906
SPENCER AND WASHBURN, ENGINEERS"

**PROPERTY SURVEY
PREPARED FOR
CHRISTIAN ACTIVITIES COUNCIL
29-A & 29-B EDGEWOOD ST. HARTFORD CONN.
SCALE 1"= 20'
APRIL 8, 2009**

PREPARED BY: DELMASTRO SURVEY
32 SAWMILL ROAD
ROCKY HILL, CONN.

I HEREBY DECLARE THAT THIS MAP IS SUBSTANTIALLY CORRECT. THIS MAP AND SURVEY WERE PREPARED IN ACCORDANCE WITH THE STANDARDS OF A CLASS A-2 SURVEY IN ACCORDANCE WITH SECTIONS 20-3006 THROUGH 20-300620 OF THE REGULATIONS OF THE CONNECTICUT STATE AGENCIES "MINIMUM STANDARDS FOR SURVEYS AND MAPS IN THE STATE OF CONNECTICUT" AS ENDORSED BY THE CONNECTICUT ASSOCIATION OF LAND SURVEYORS INC.

TYPE OF SURVEY: ZONING LOCATION
BOUNDARY DETERMINATION CATEGORY: DEPENDENT RESURVEY OF MAP REFERENCES
EMILIO J. DELMASTRO LS. 7384

