
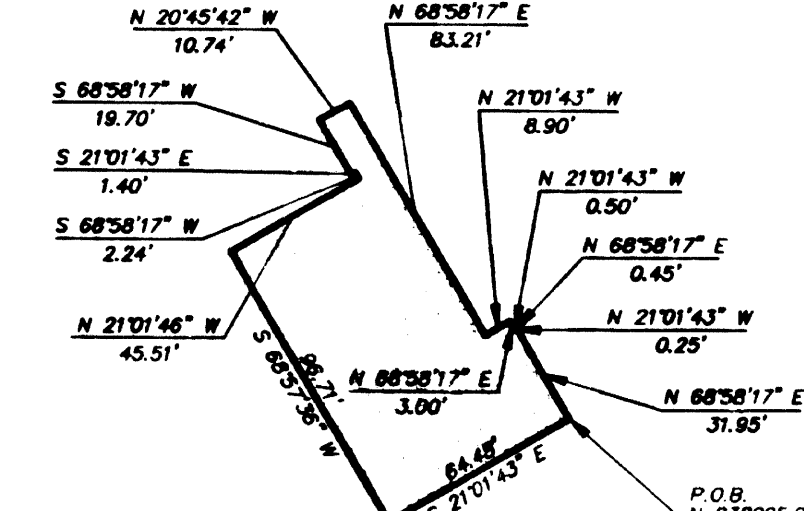
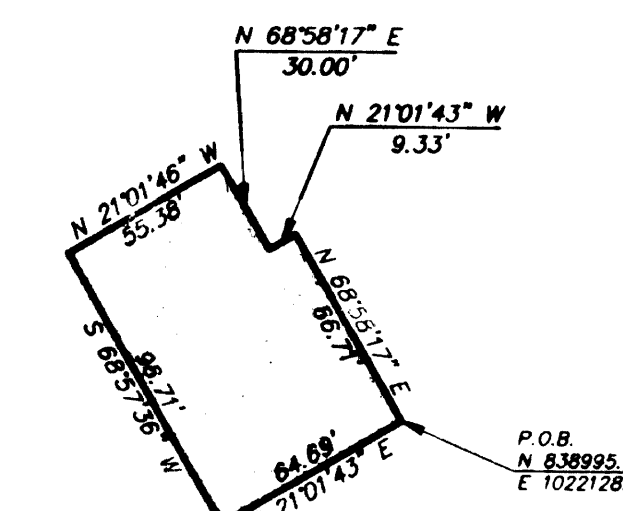
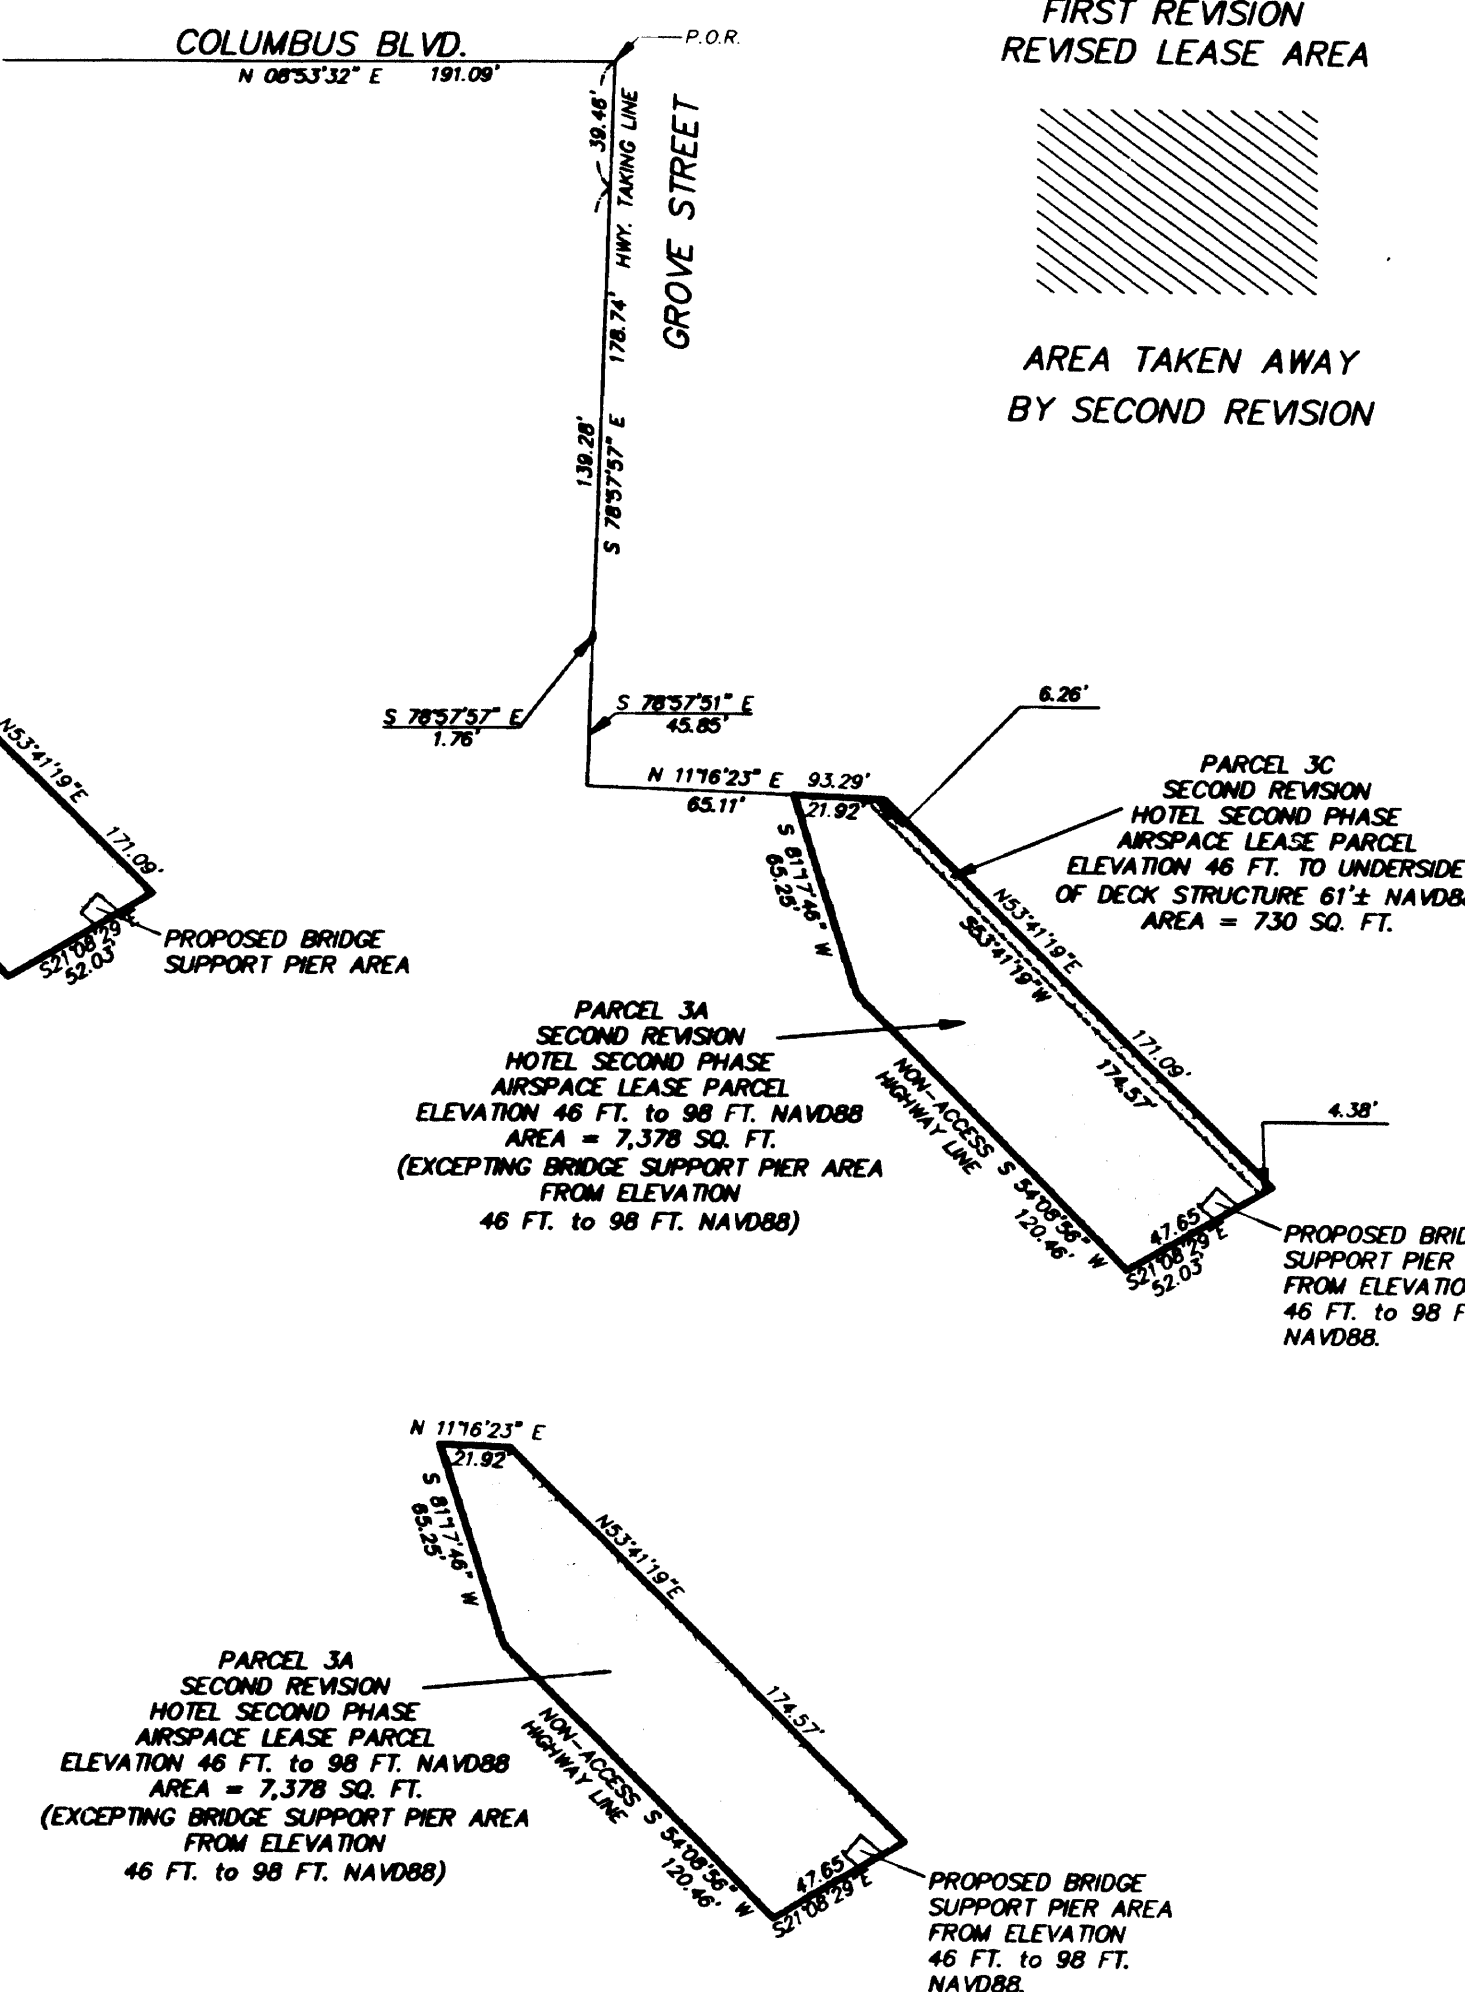
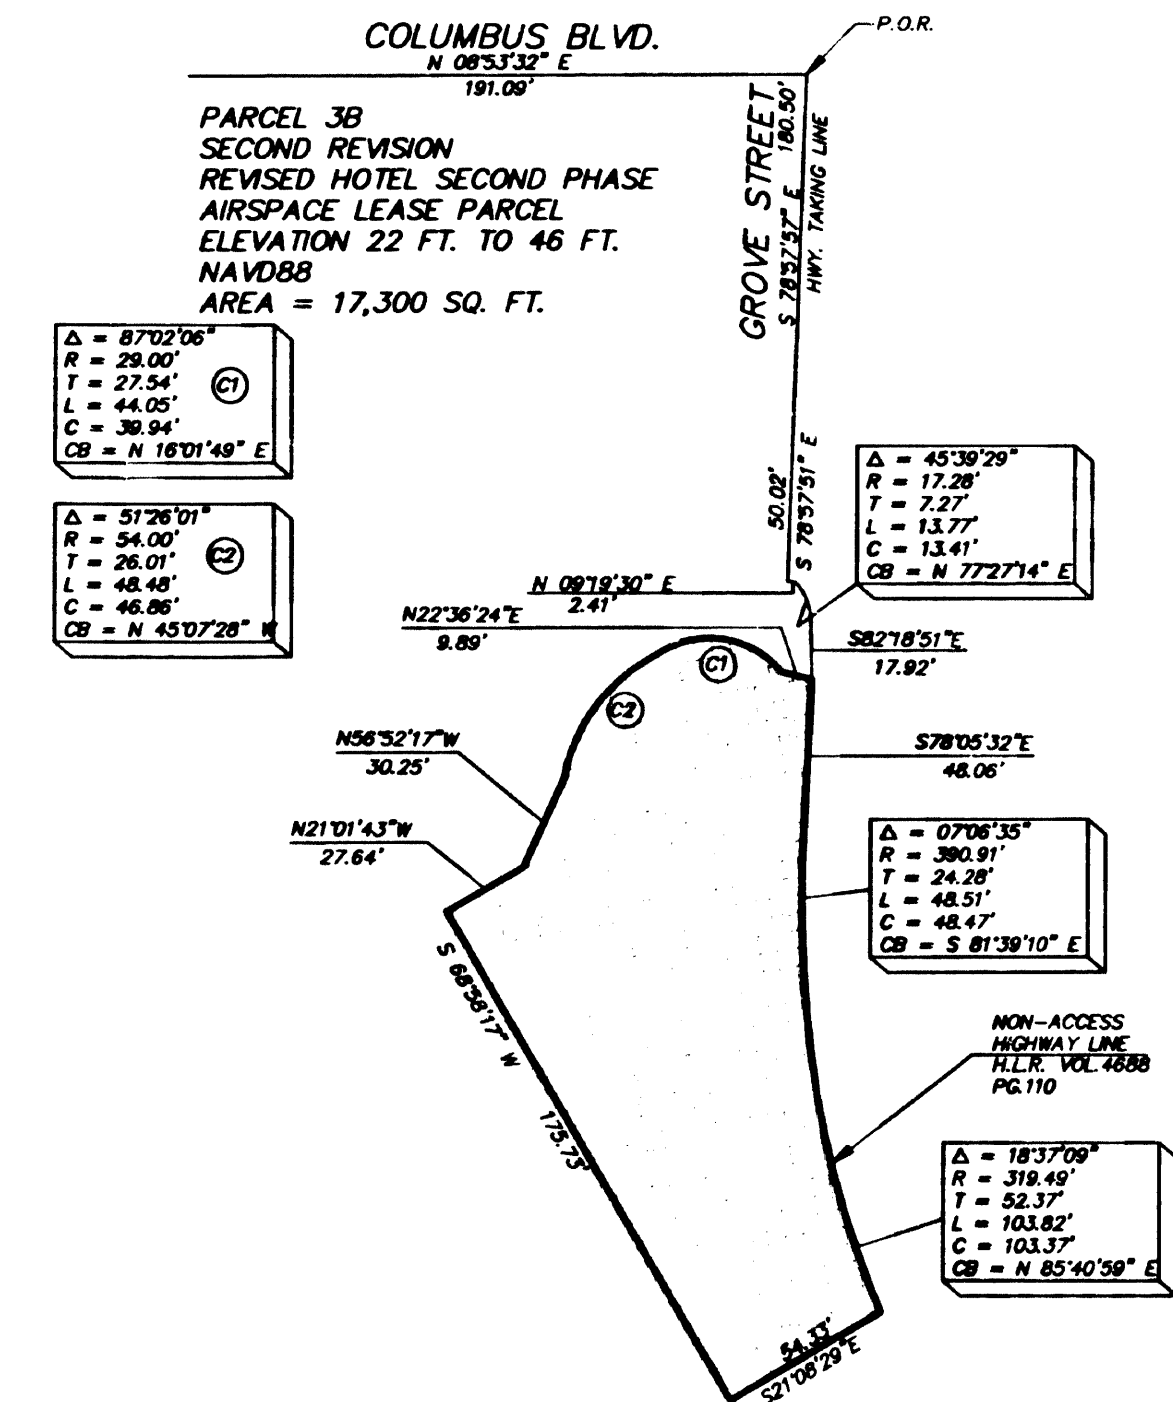
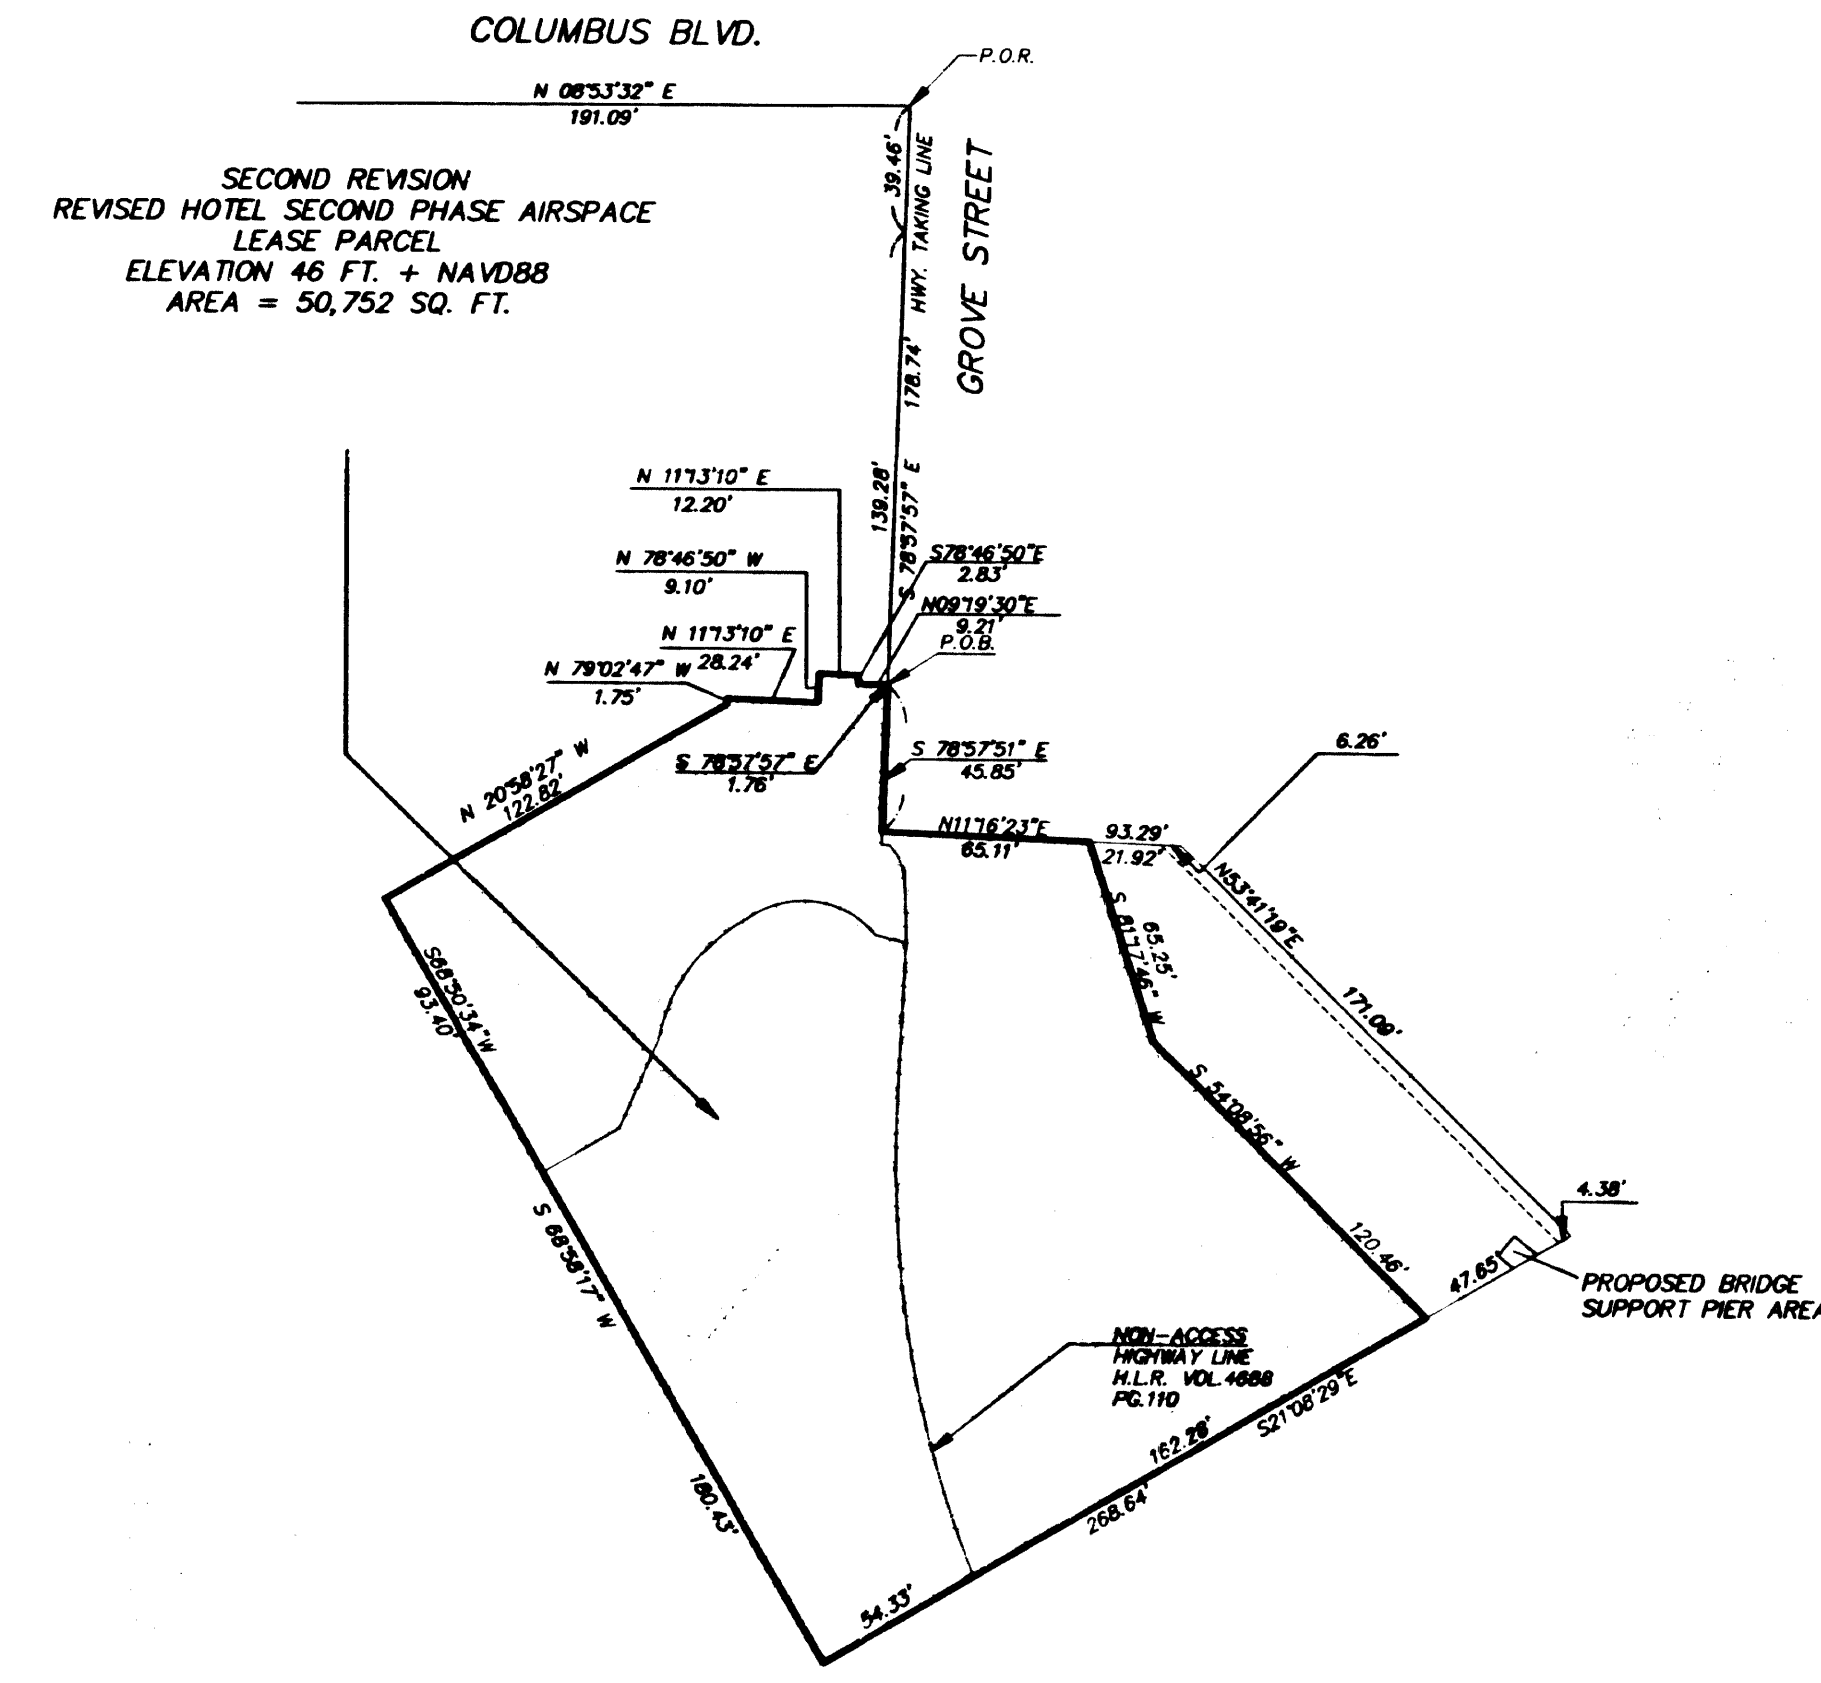
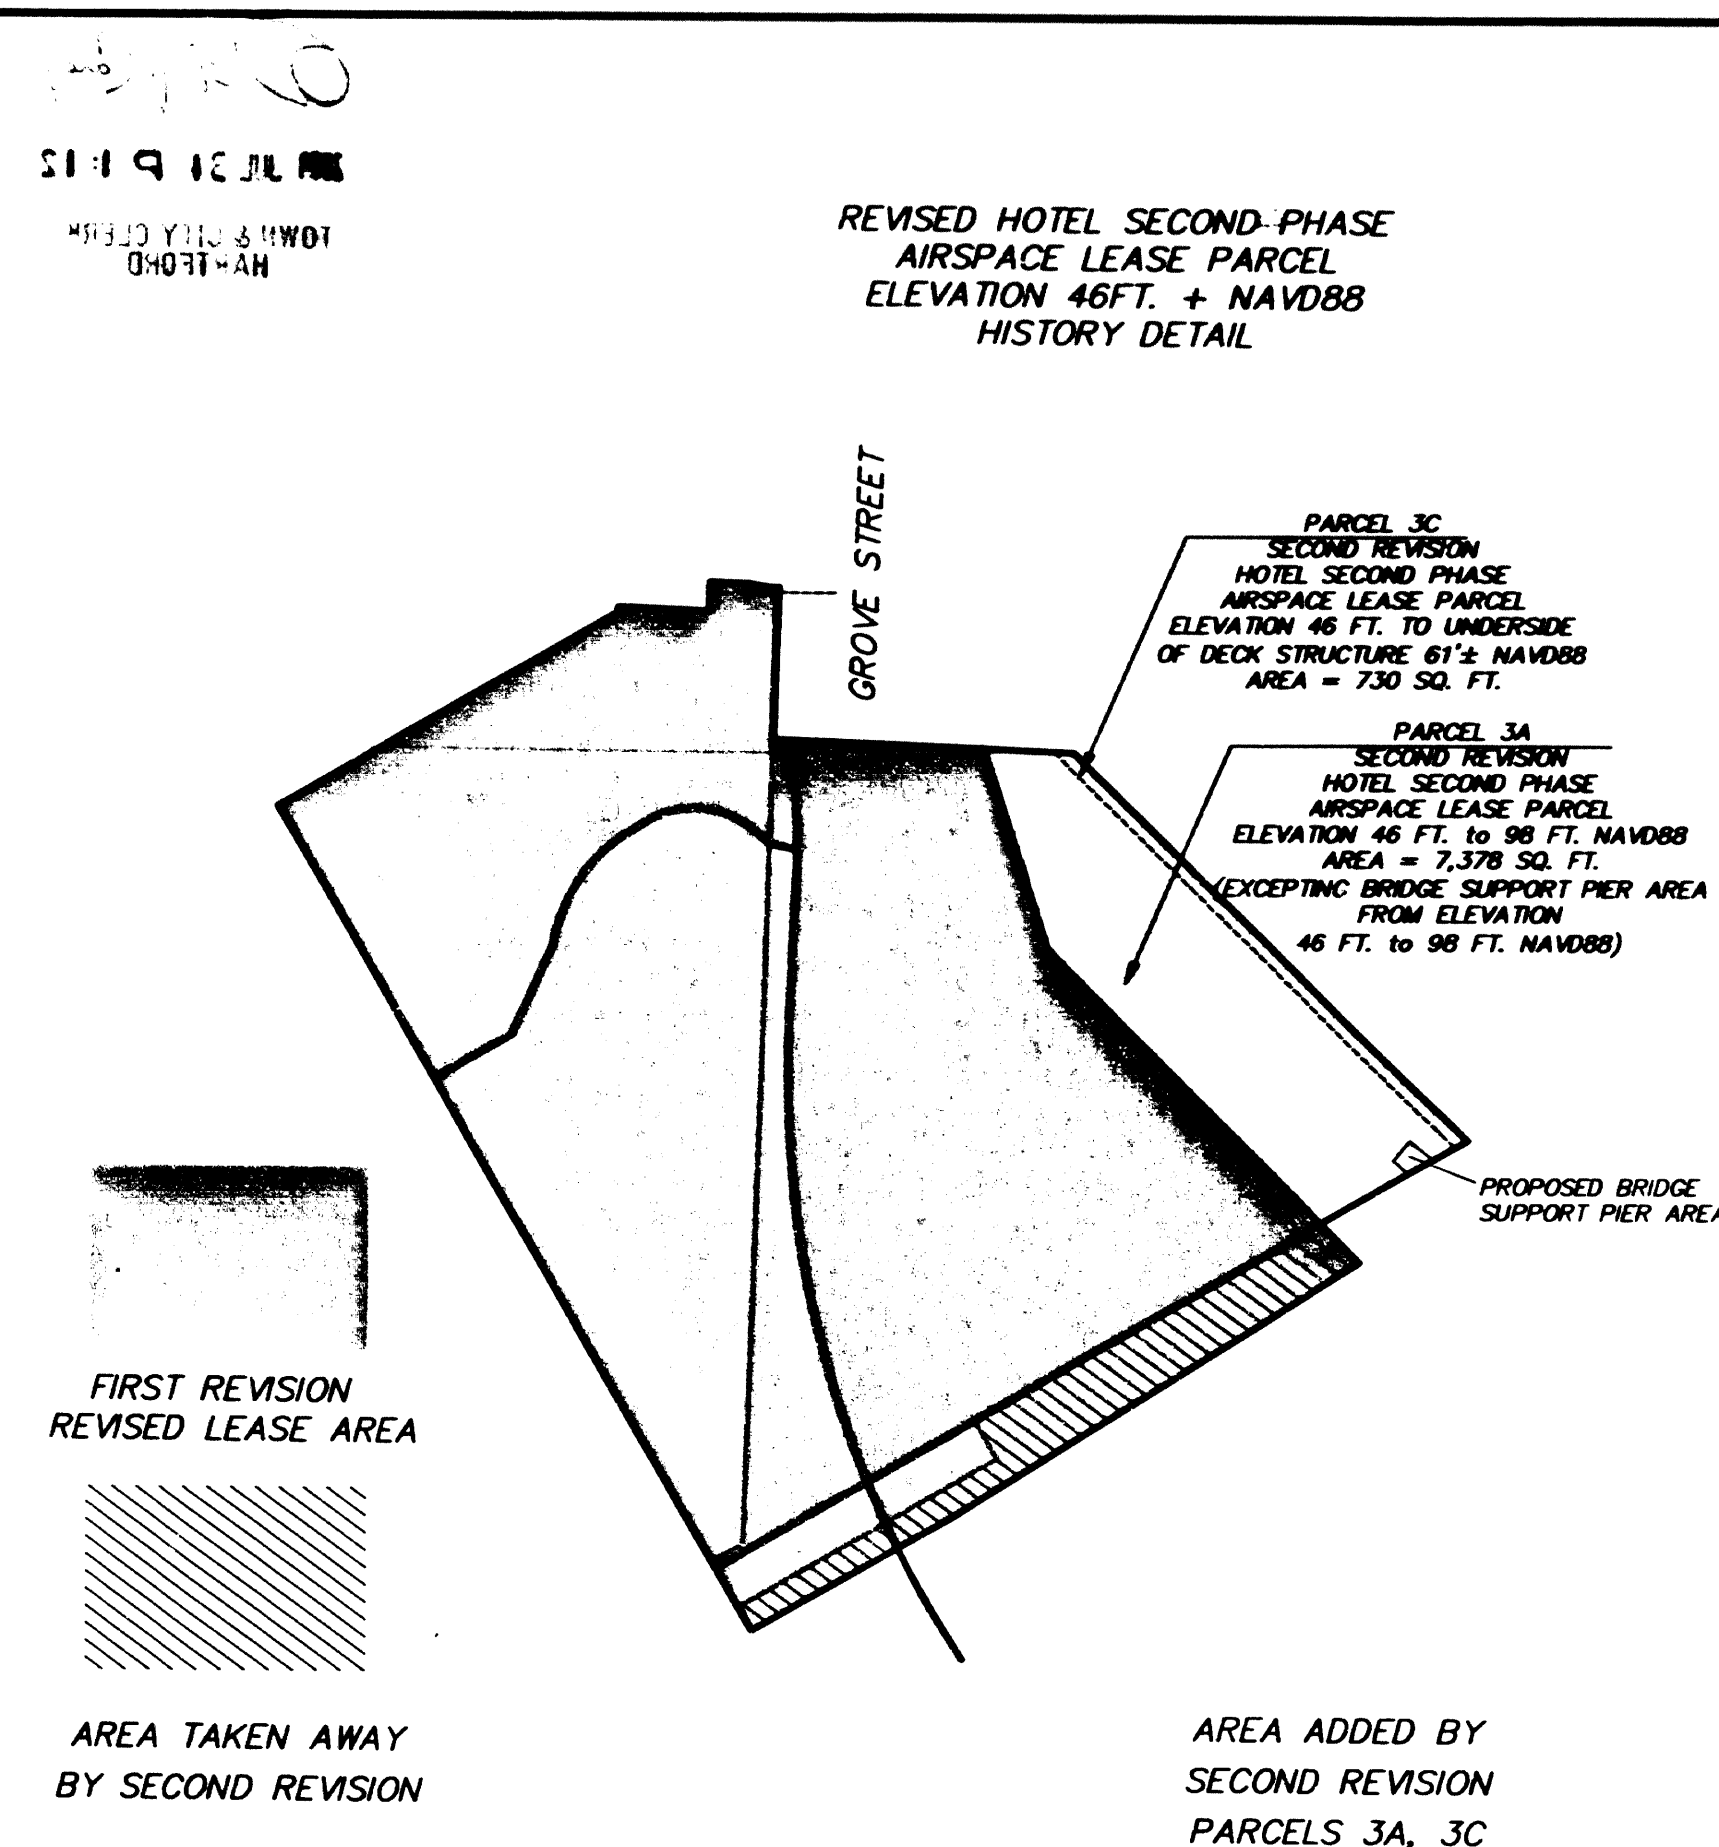
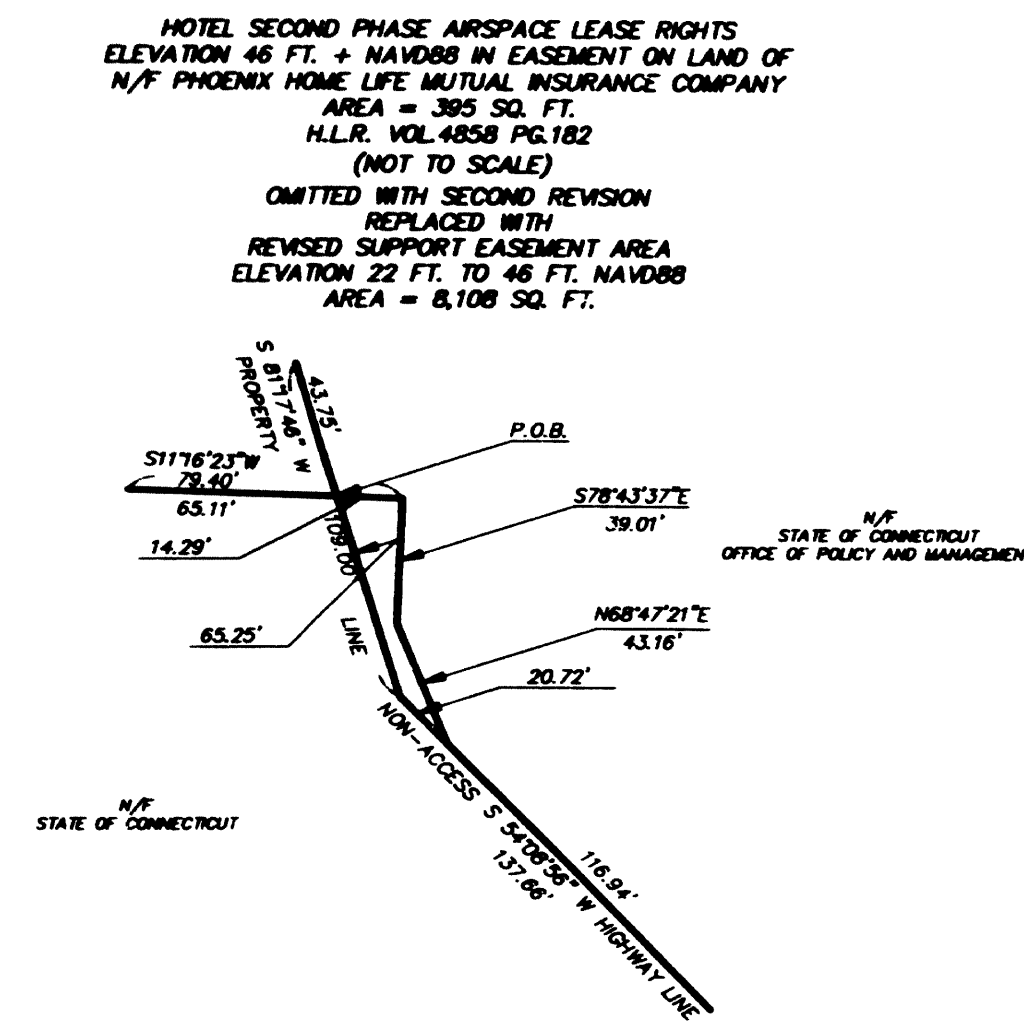
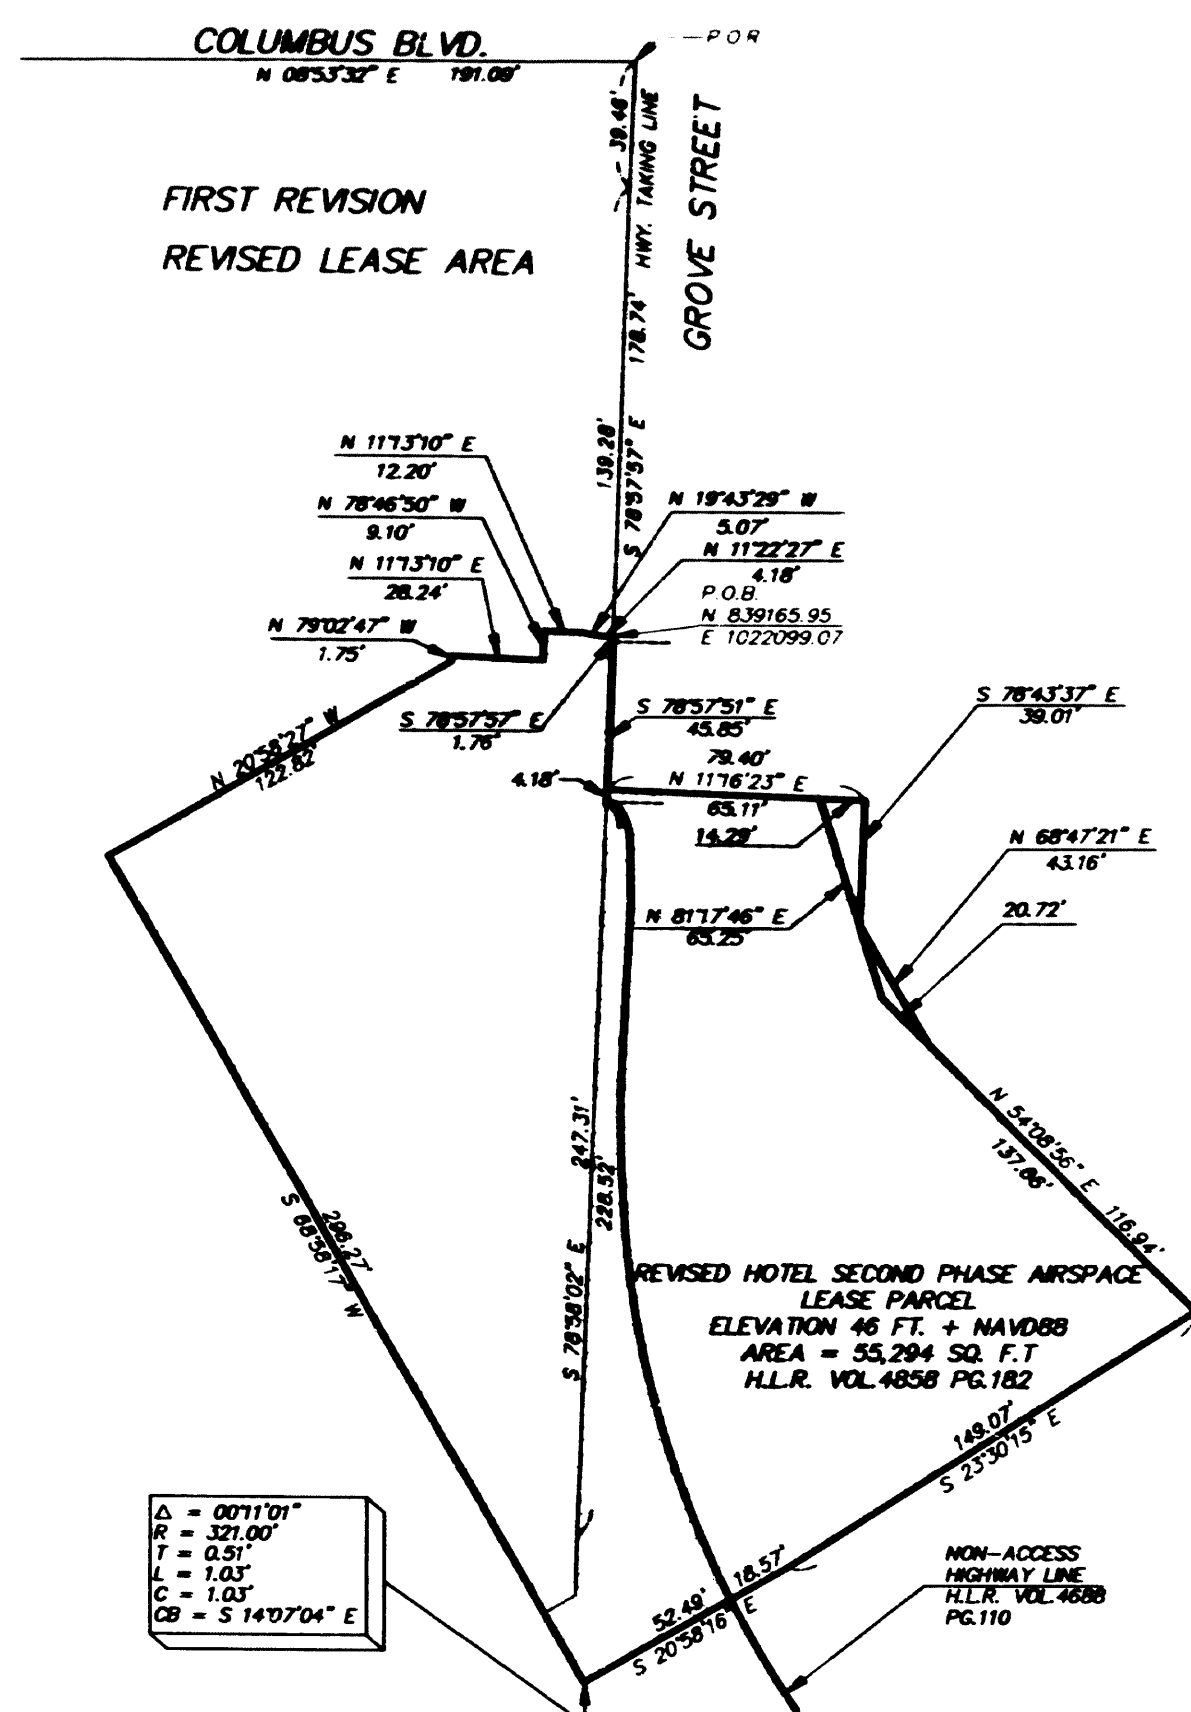


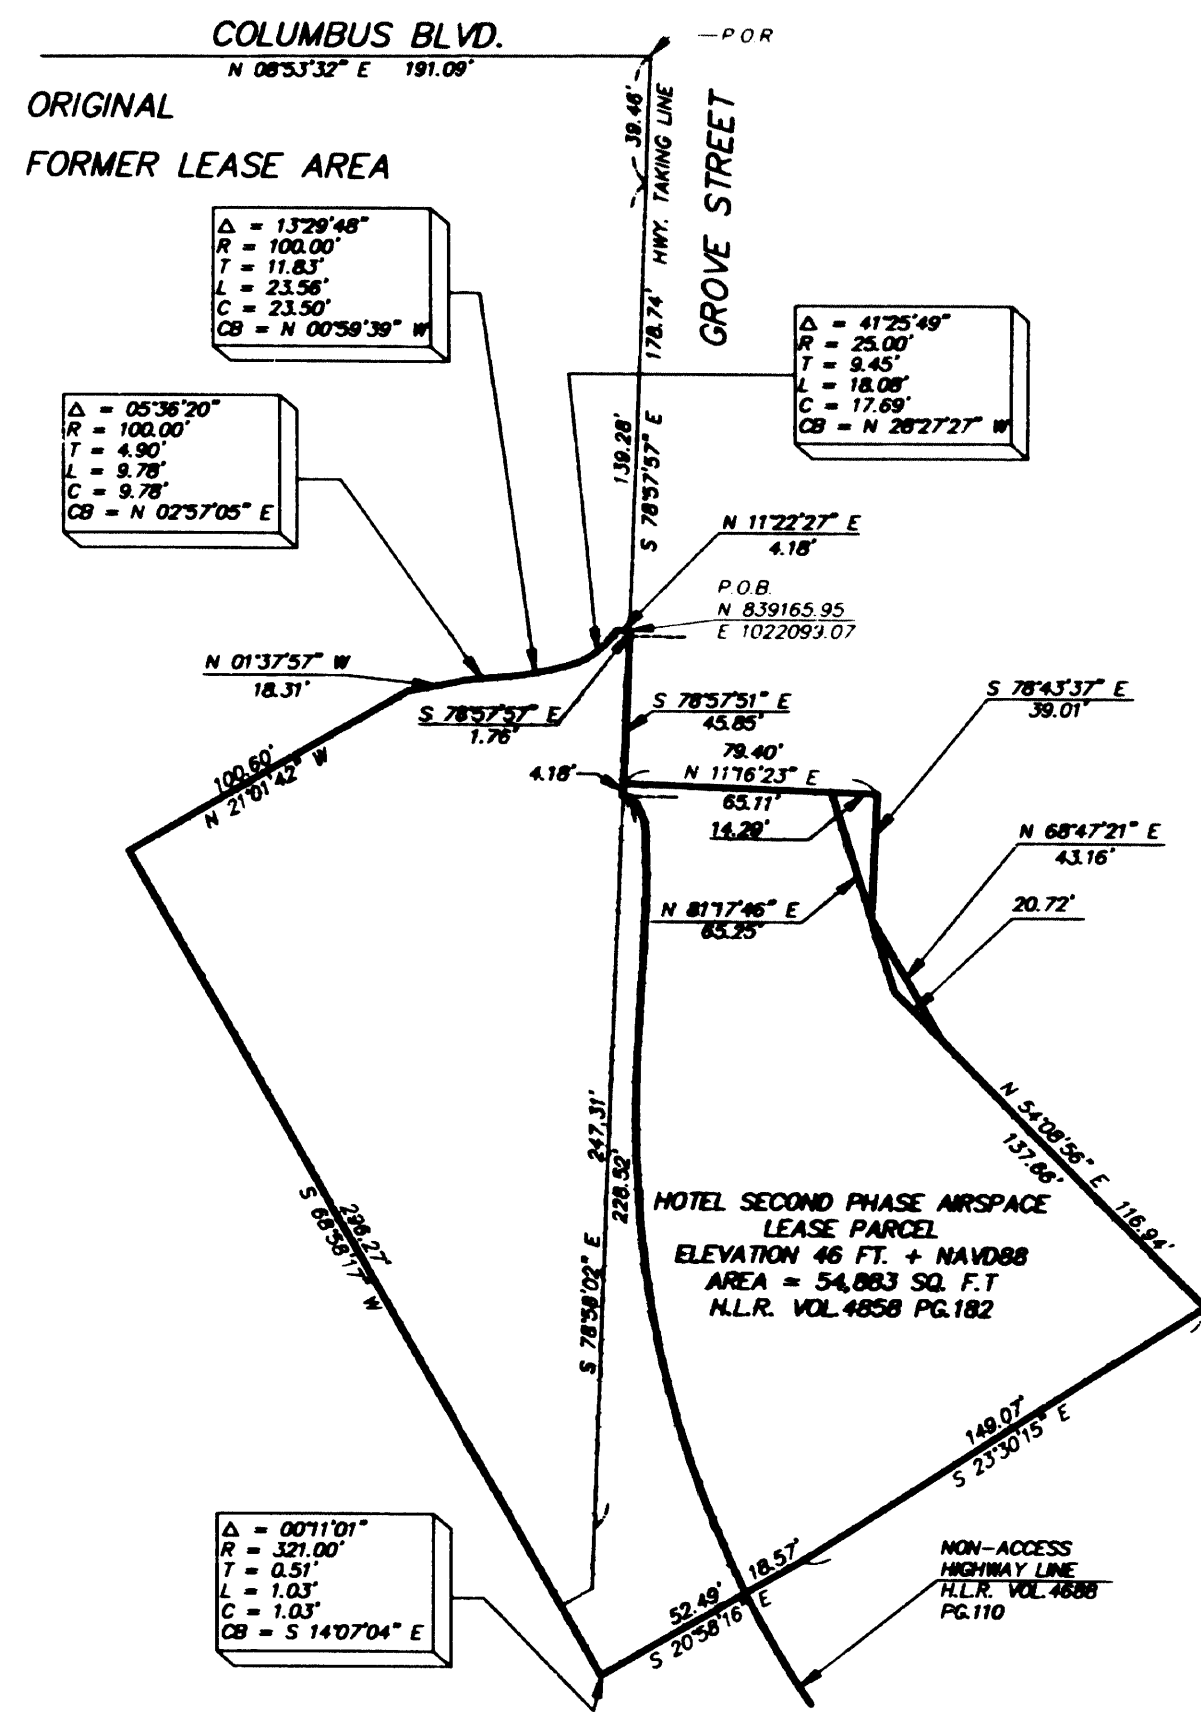

EASEMENT PLAN DETAIL SHEET/
ALTA/ACSM LAND TITLE SURVEY

HOTEL LEASE PLAN
STATE OF CONNECTICUT
ADRIAEN'S LANDING

EAH-2

ADRIAEN'S LANDING
Hartford, Connecticut

F. A. Hesketh & Associates, Inc.
6 Creamery Brook, East Granby, CT 06026
Civil & Traffic Engineers - Surveyors - Planners - Landscape Architects

EAH

NO.	DATE	DESCRIPTION	BY	CHKD.
1	03-07-03	ADRIAEN'S LANDING	F.A.H.	
2	03-07-03	ADRIAEN'S LANDING	F.A.H.	
