


25+25
25+25
25+25

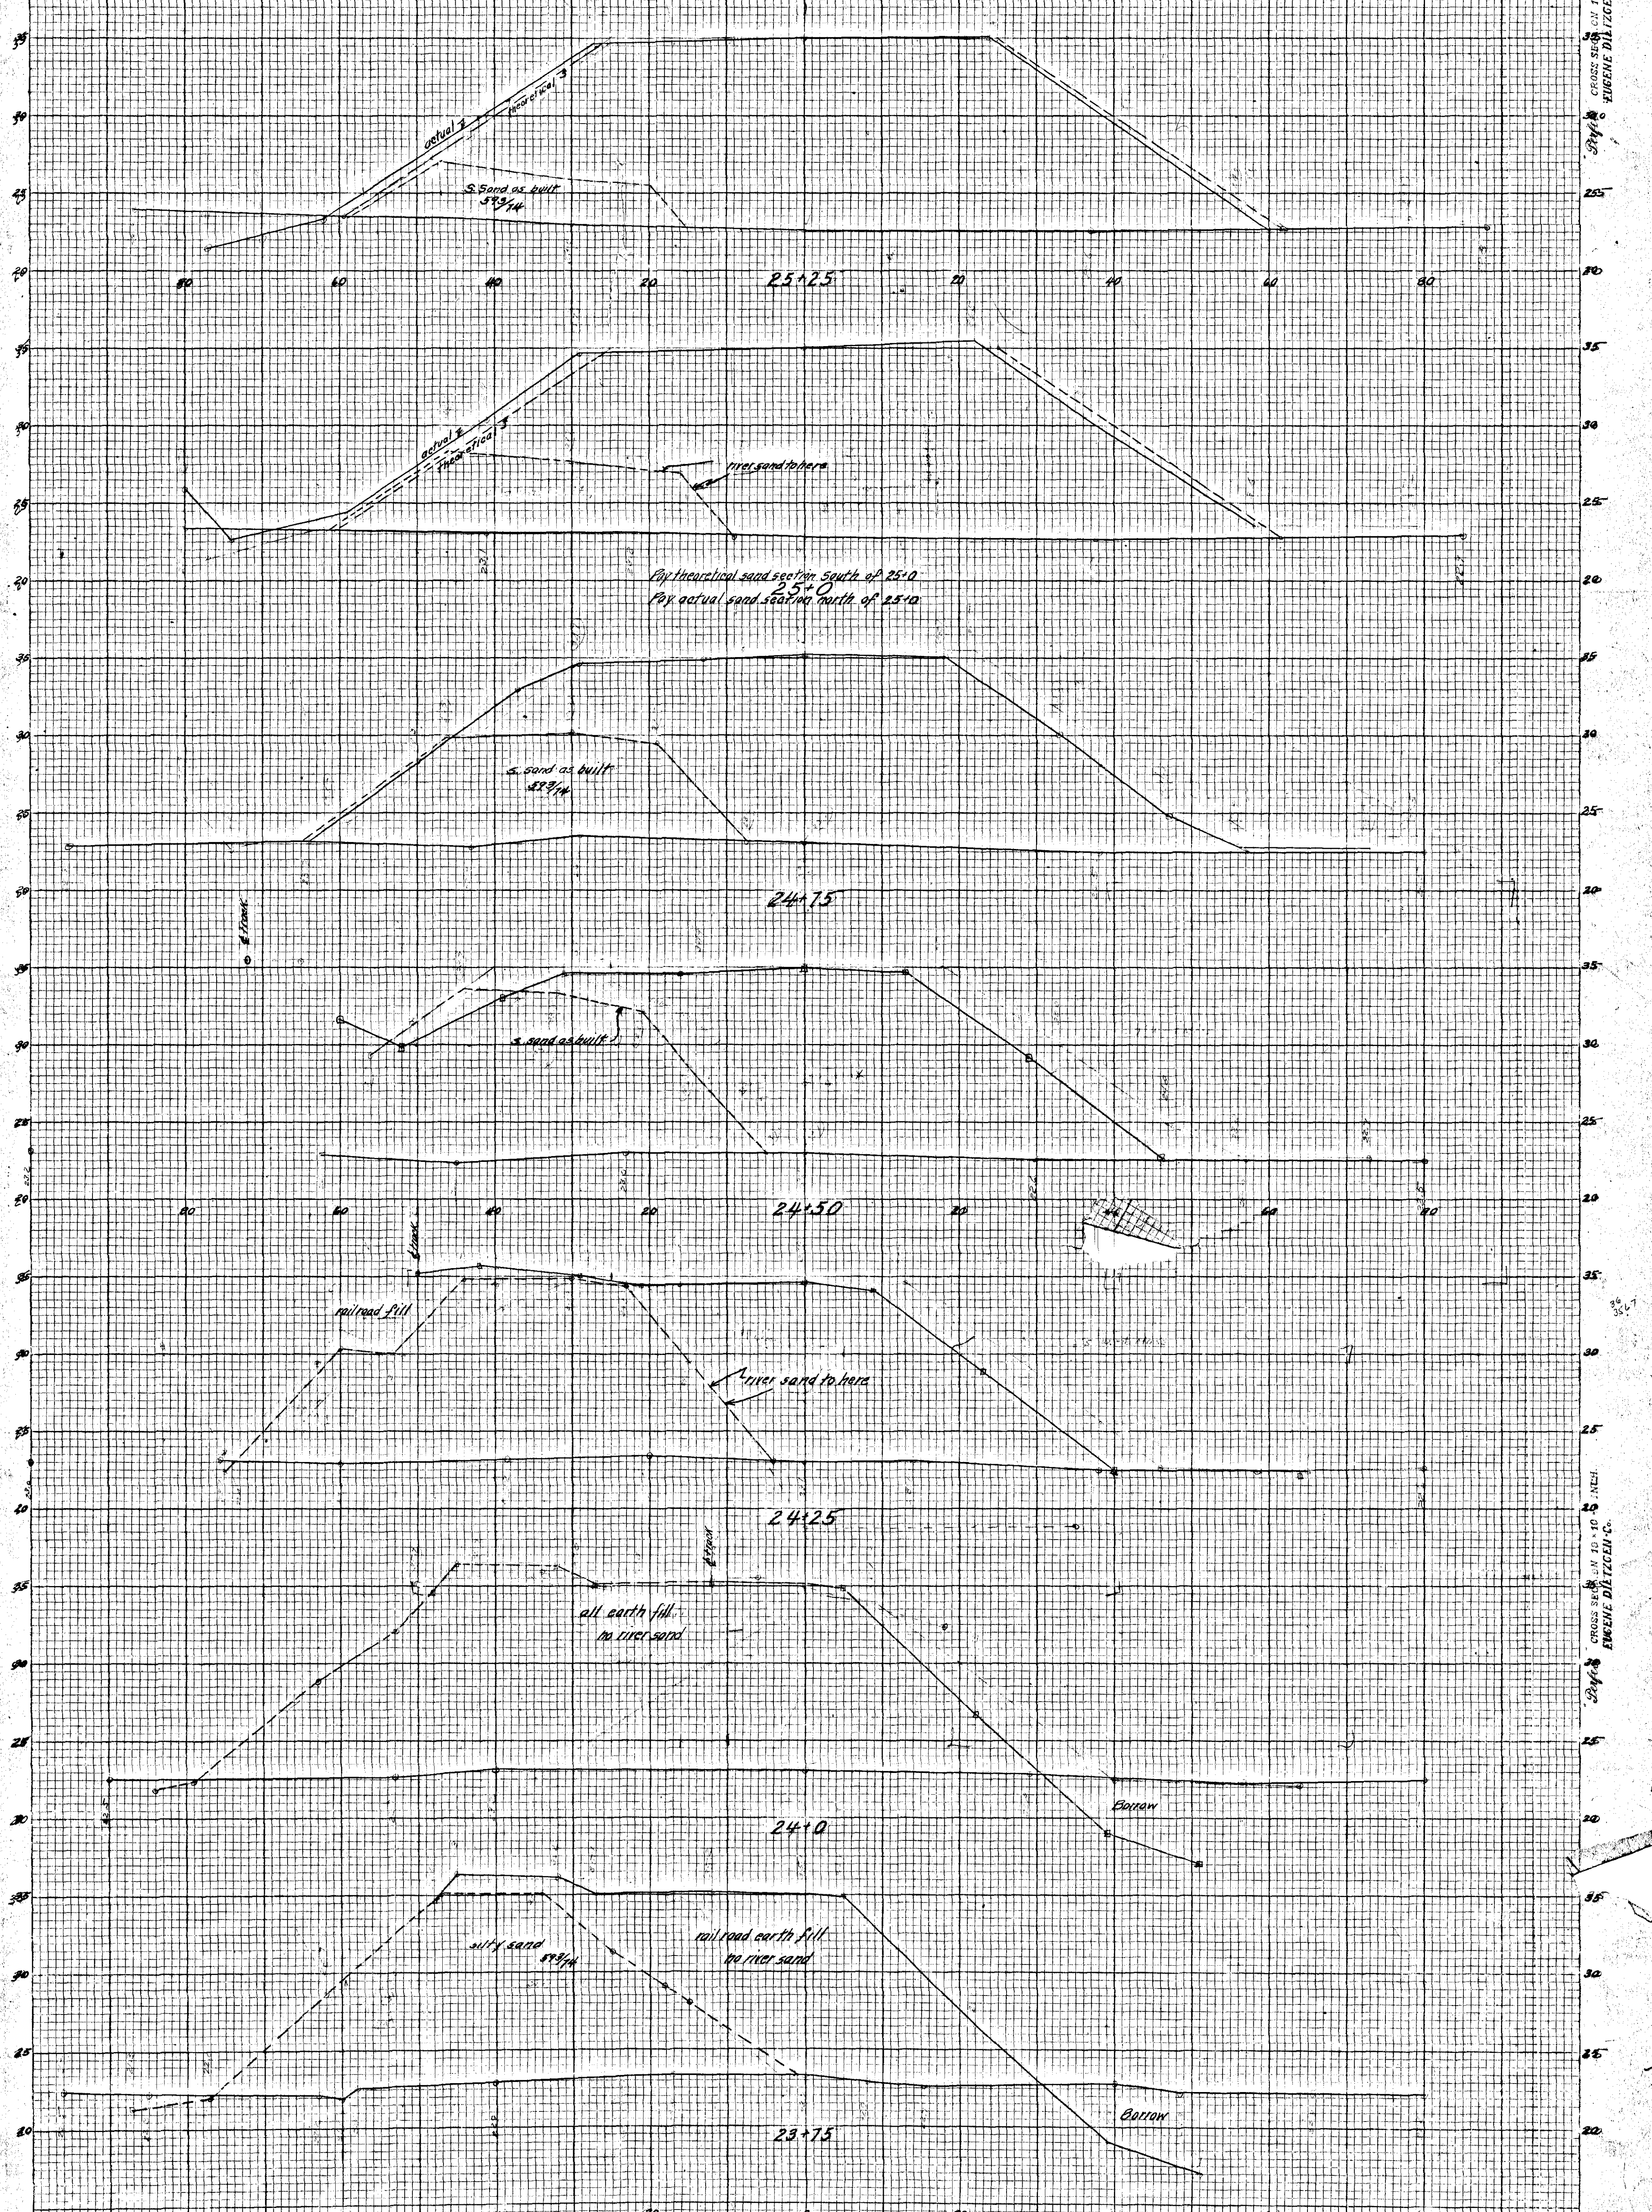

Note: This sheet to be rolled with
405-2-067H1

CITY OF HARTFORD
DEPARTMENT OF ENGINEERING
Scale 1" = 5' Vert
Date Feb. 1932

FEB. 24, 1932

CROSS SECTION 10' x 10' 1 INCH
EUGENE D. LITZEN C.
25+25
24+75
24+50
24+25
24+0
23+75