


MARY DILORETO
VS.
CITY OF HARTFORD

CITY OF HARTFORD
DEPARTMENT OF ENGINEERING
SCALE 1"=2'
MARCH 31, 1933

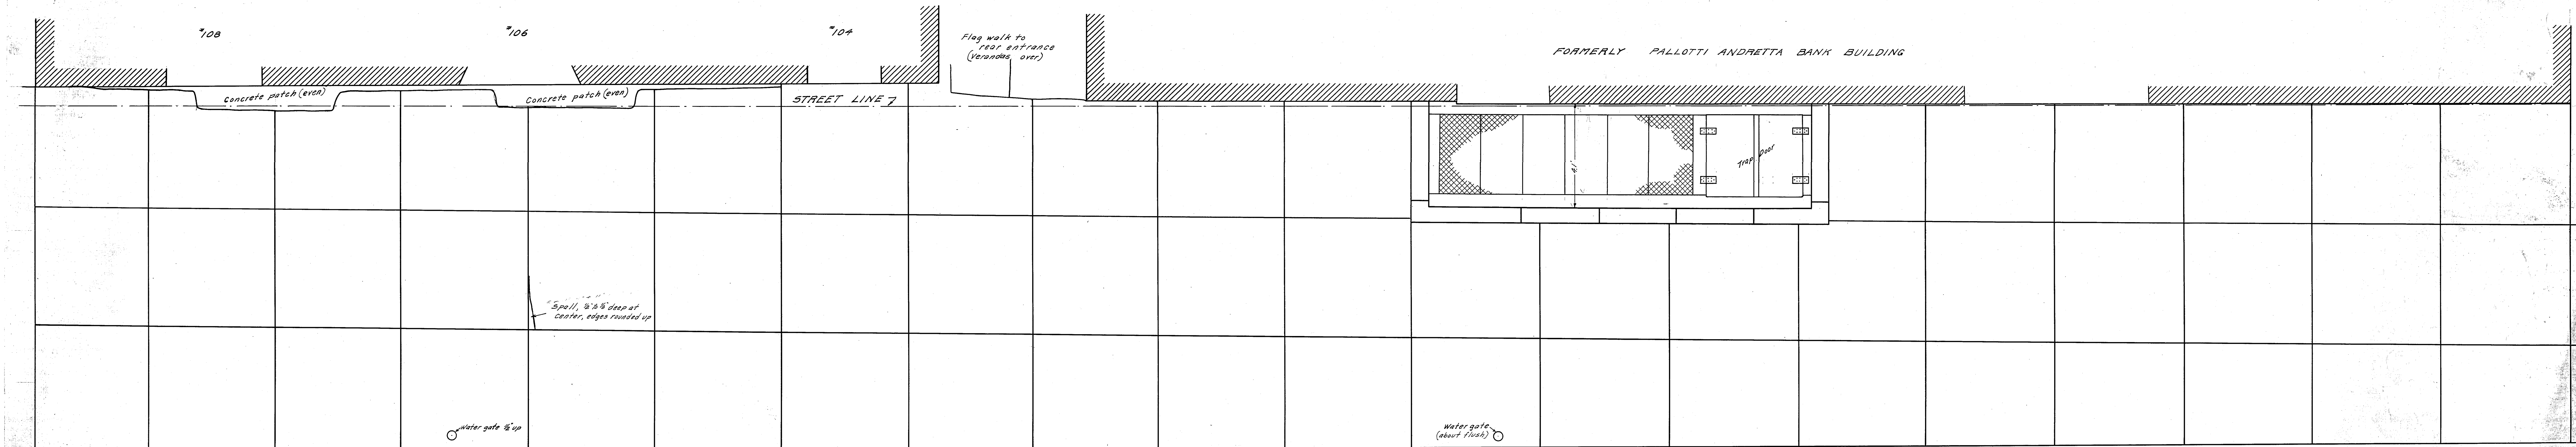

WINDSOR

STREET