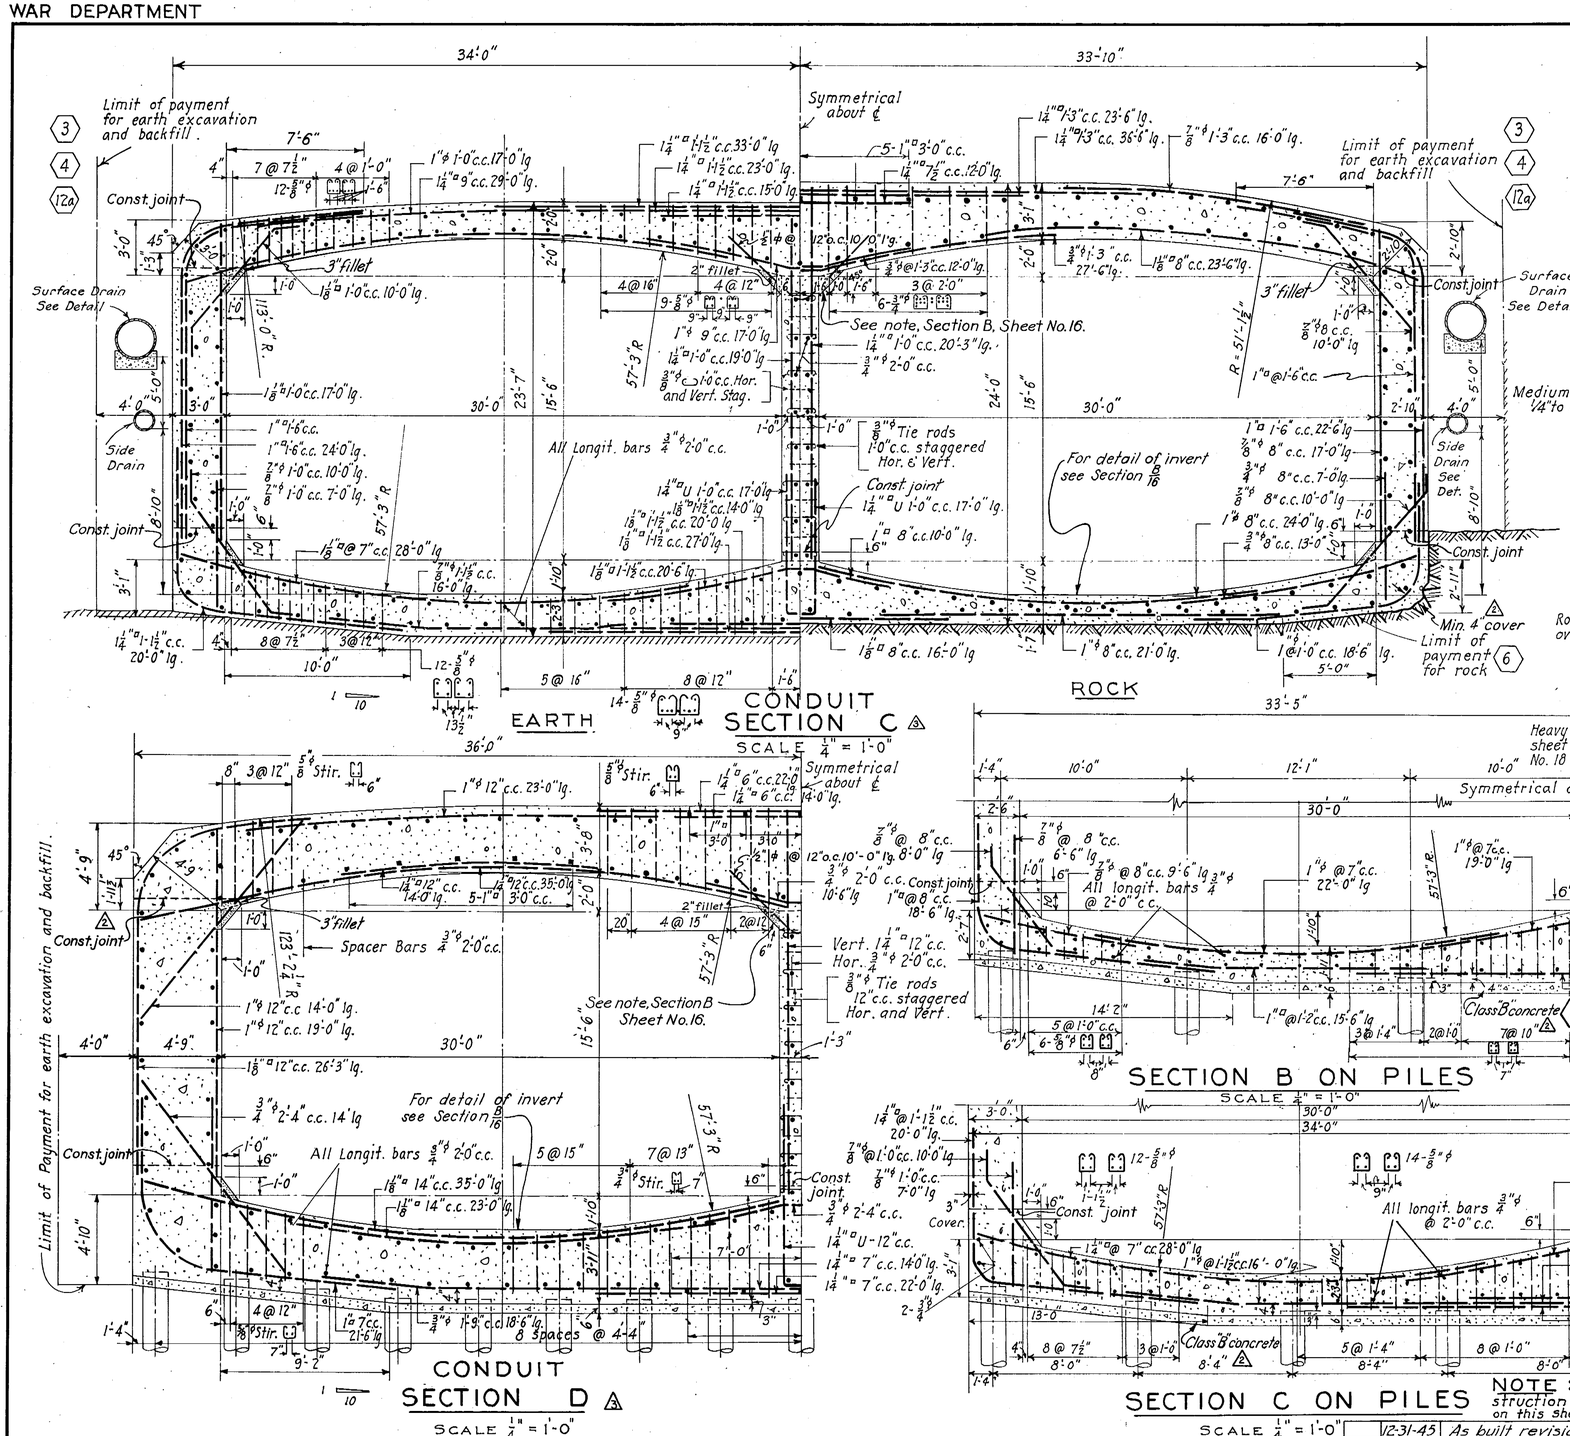

NOTE: For Reinforcement above construction joints, see Section "B" on Earth. Sheet No. 16

NOTE: For Reinforcement above construction joints, see Section "C" on earth, on this sheet.

NOTES

For general notes applying to details shown on this sheet, see Sheet No. 16.

KEY	DATE	REVISION (Indicated by △)	REV. BY	CK. BY	AP. BY
	12-31-45	As built revisions			
△	2-17-41	Top center wall fillet added			
△	11-22-40	Class B conc. and minor changes	K.B.N.		

CONNECTICUT RIVER FLOOD CONTROL

PARK RIVER CONDUIT

HARTFORD, CONN.

CONDUIT SECTIONS NO. 2

CONNECTICUT RIVER — CONNECTICUT

IN 48 SHEETS — SCALE: 1/4 IN. = 1 FT. — SHEET NO. 17

U.S. ENGINEER OFFICE PROVIDENCE, R.I. — MAY 1940

REVIEWED: ENGINEER F.C. DESIGN SECTION

APPROVAL RECOMMENDED: PRINCIPAL ENGINEER CHIEF F.C. ENGINEERING DIV.

APPROVED: LT. COL. CORPS OF ENGINEERS DISTRICT ENGINEER

SUBMITTED: METCALF & EDDY BOSTON, MASS. (PARTNER)

DRAWN BY: G.C.D. TRACED BY: C.W.R. CHECKED BY:

FILE NO. CT-4-2615

METCALF & EDDY ENGINEERS BOSTON, MASS.