



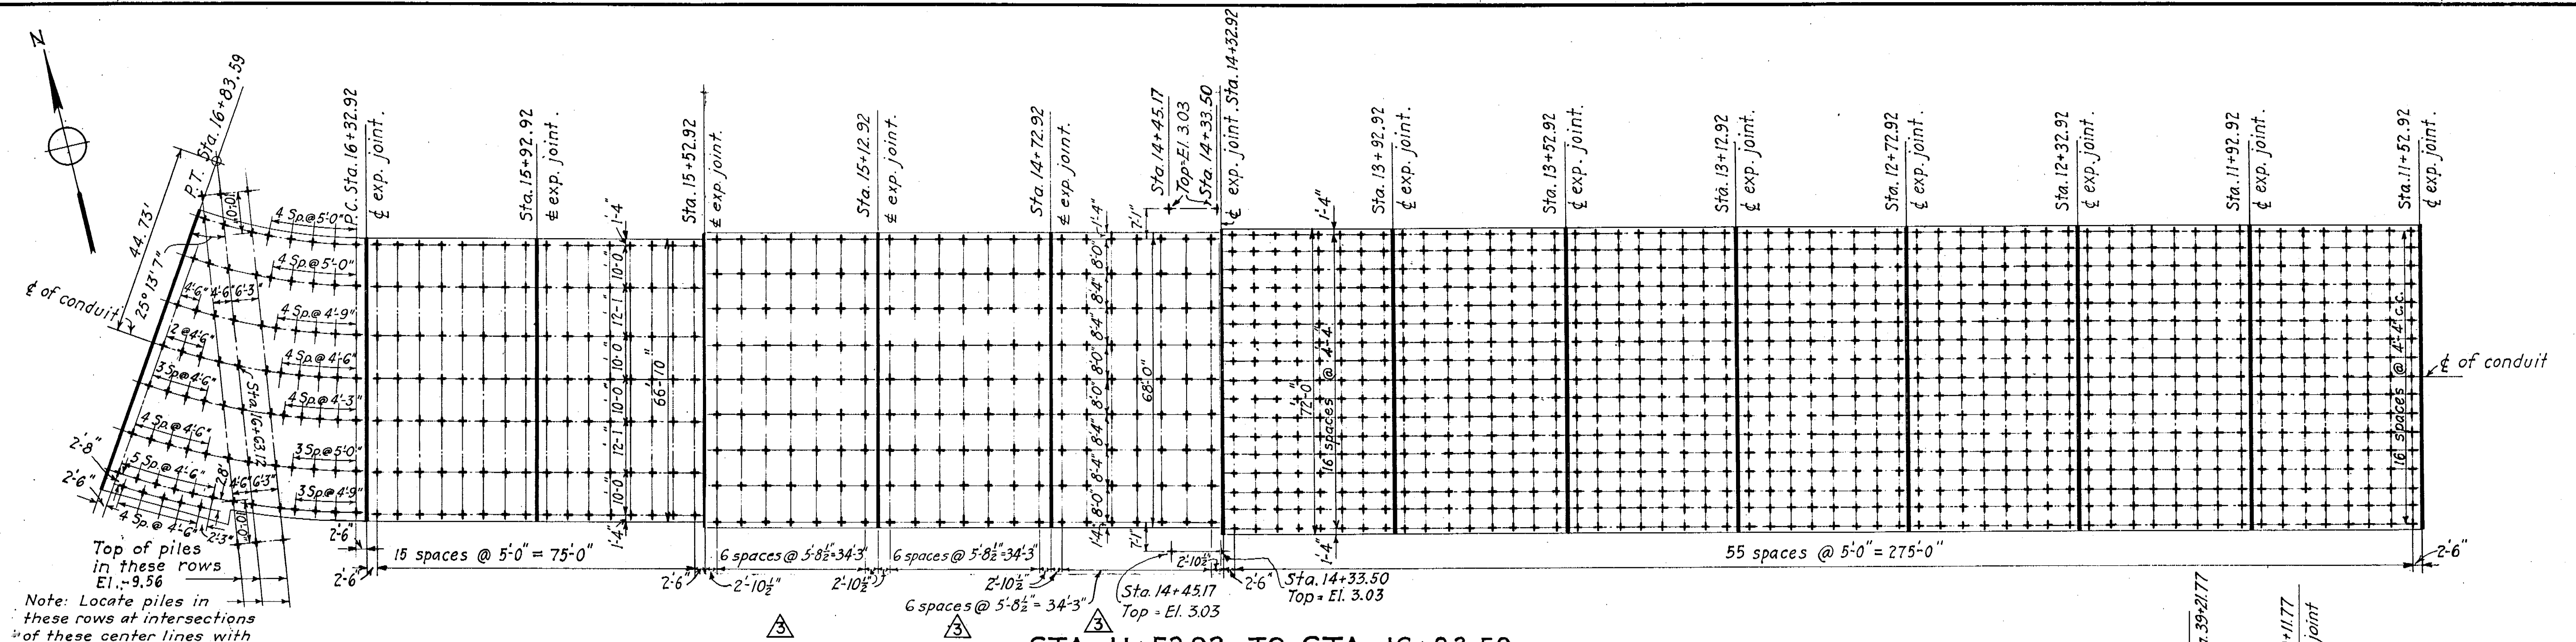


STA. 11+52.92 TO STA. 16+83.59

SCALE: 1" = 20'

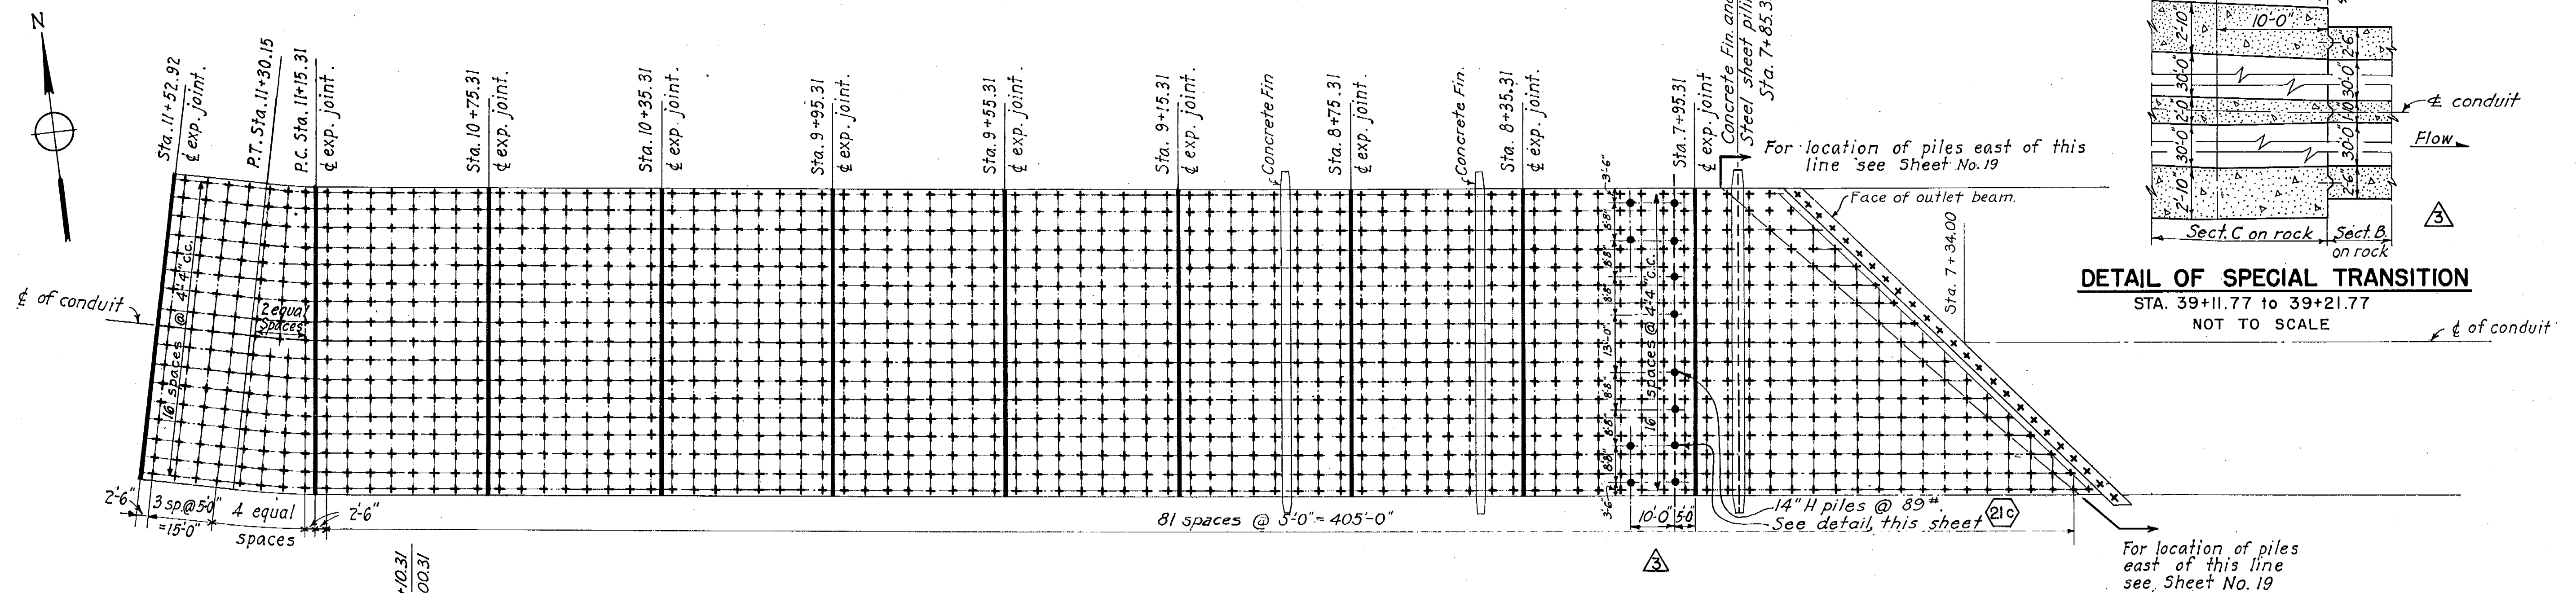


STA. 7+34.00 TO STA. 11+52.92

SCALE: 1" = 20'

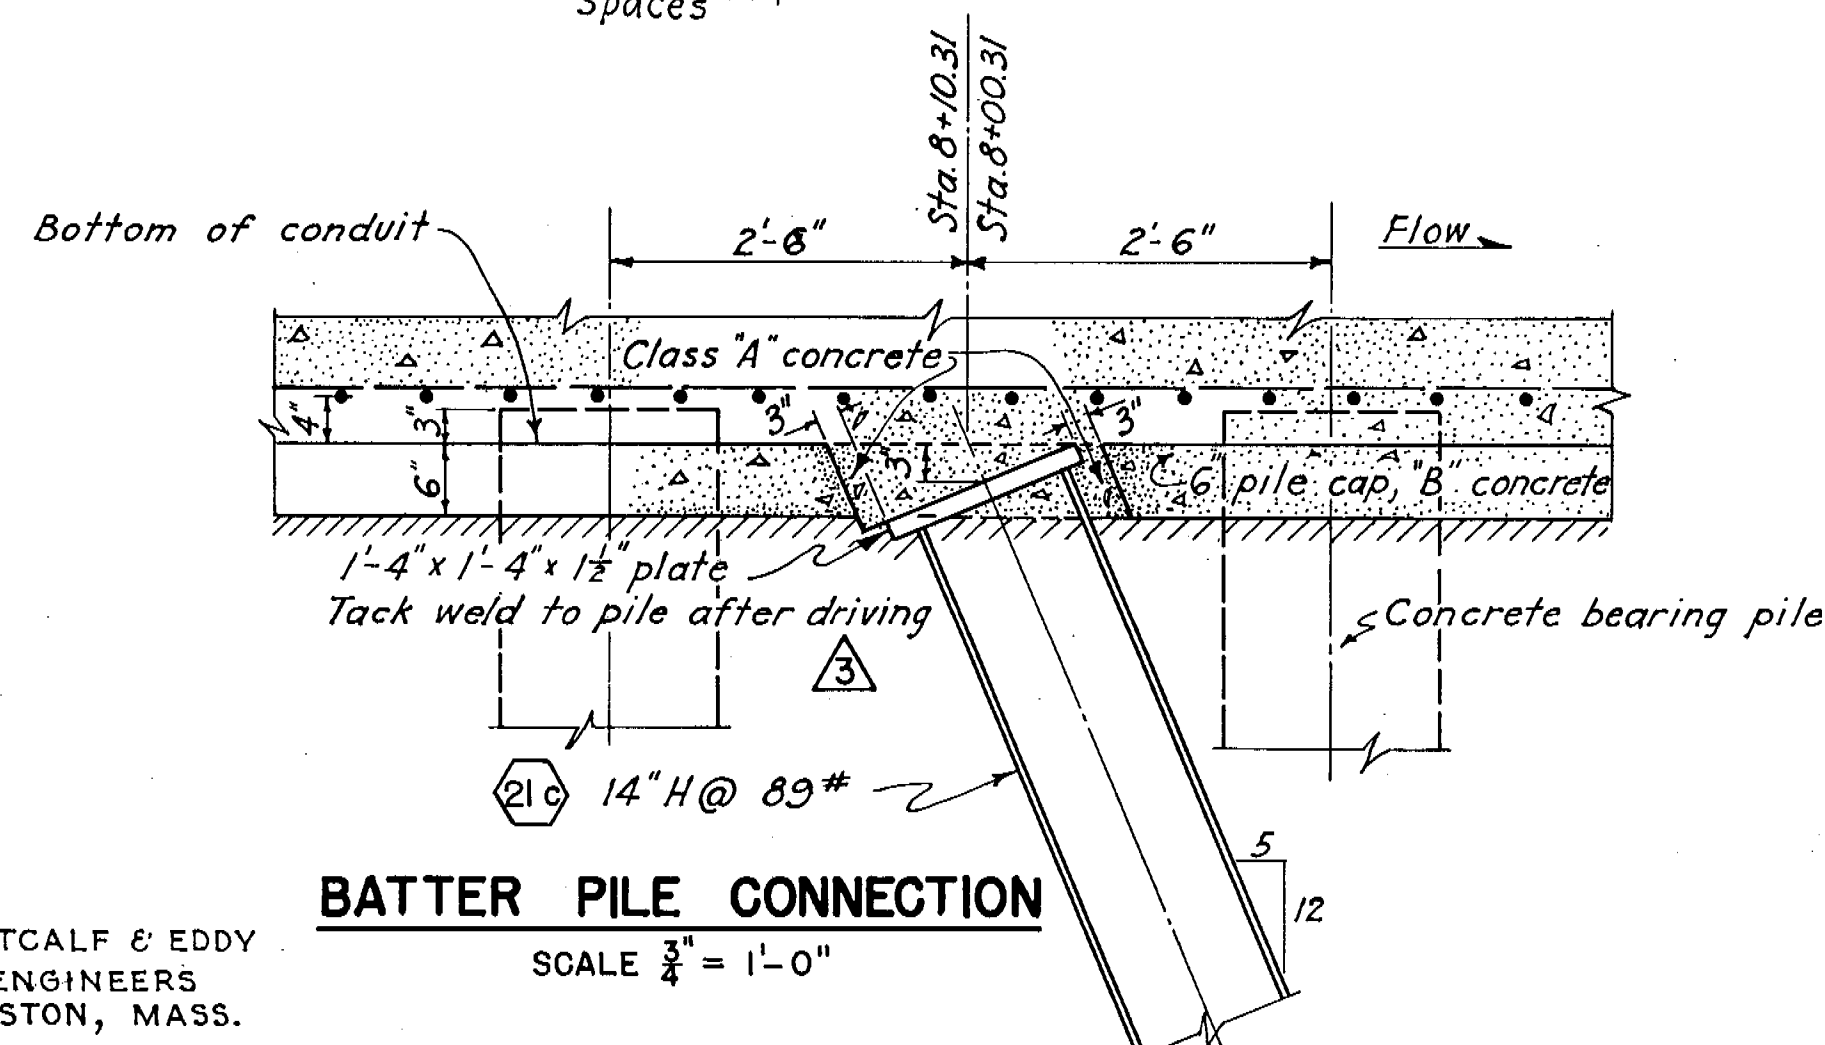

BATTER PILE CONNECTION

SCALE: 3/4" = 1'-0"

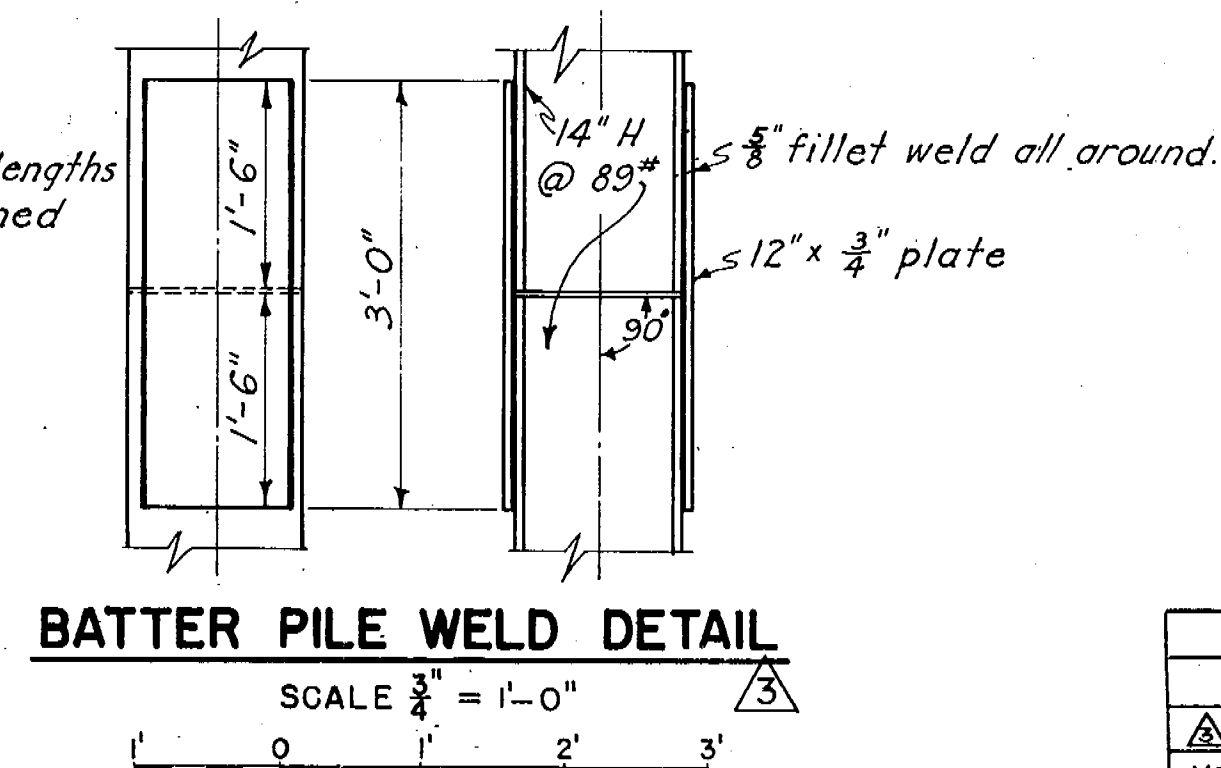

BATTER PILE WELD DETAIL

SCALE: 3/4" = 1'-0"

NOTES:

For elevation of tops of piles except as noted see typical sections on Sheets Nos. 16 and 17
For Legend see Sheet No. 19

DETAIL OF SPECIAL TRANSITION

STA. 39+11.77 TO 39+21.77
NOT TO SCALE

CONNECTICUT RIVER FLOOD CONTROL			
PARK RIVER CONDUIT			
HARTFORD, CONN.			
PILING NO. 1			
CONNECTICUT RIVER		CONNECTICUT	
IN 48 SHEETS		SCALE: 1 IN. = 20 FT.	
U.S. ENGINEER OFFICE, PROVIDENCE, R.I.		MAY 1940	
REVIEWED:	APPROVAL RECOMMENDED:	APPROVED:	
ENGINEER	PRINCIPAL ENGINEER	COL. CORPS OF ENGINEERS	
F.C. DESIGN SECTION	CHIEF F.C. ENGINEERING DIV.	DISTRICT ENGINEER	
SUBMITTED:	DRAWN BY: E.F. METCALF & EDDY (PARTNER)		FILE NO. CT-4-2610
BOSTON, MASS.		CHECKED BY: R.M.	

METCALF & EDDY
ENGINEERS
BOSTON, MASS.