



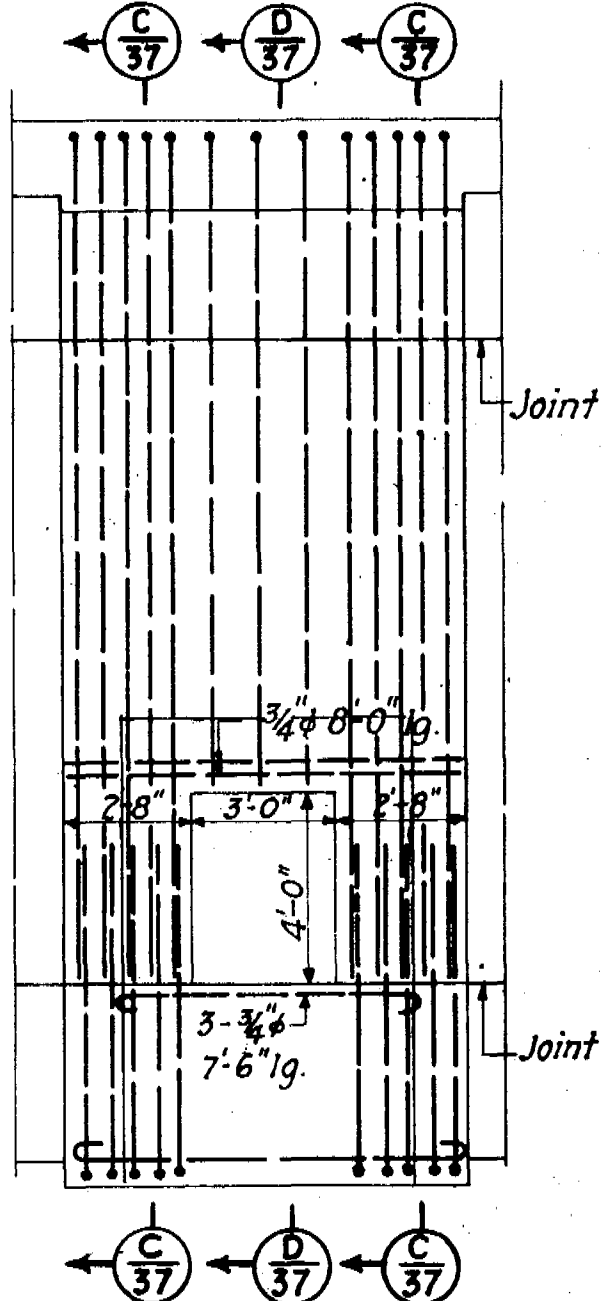

ELEVATION

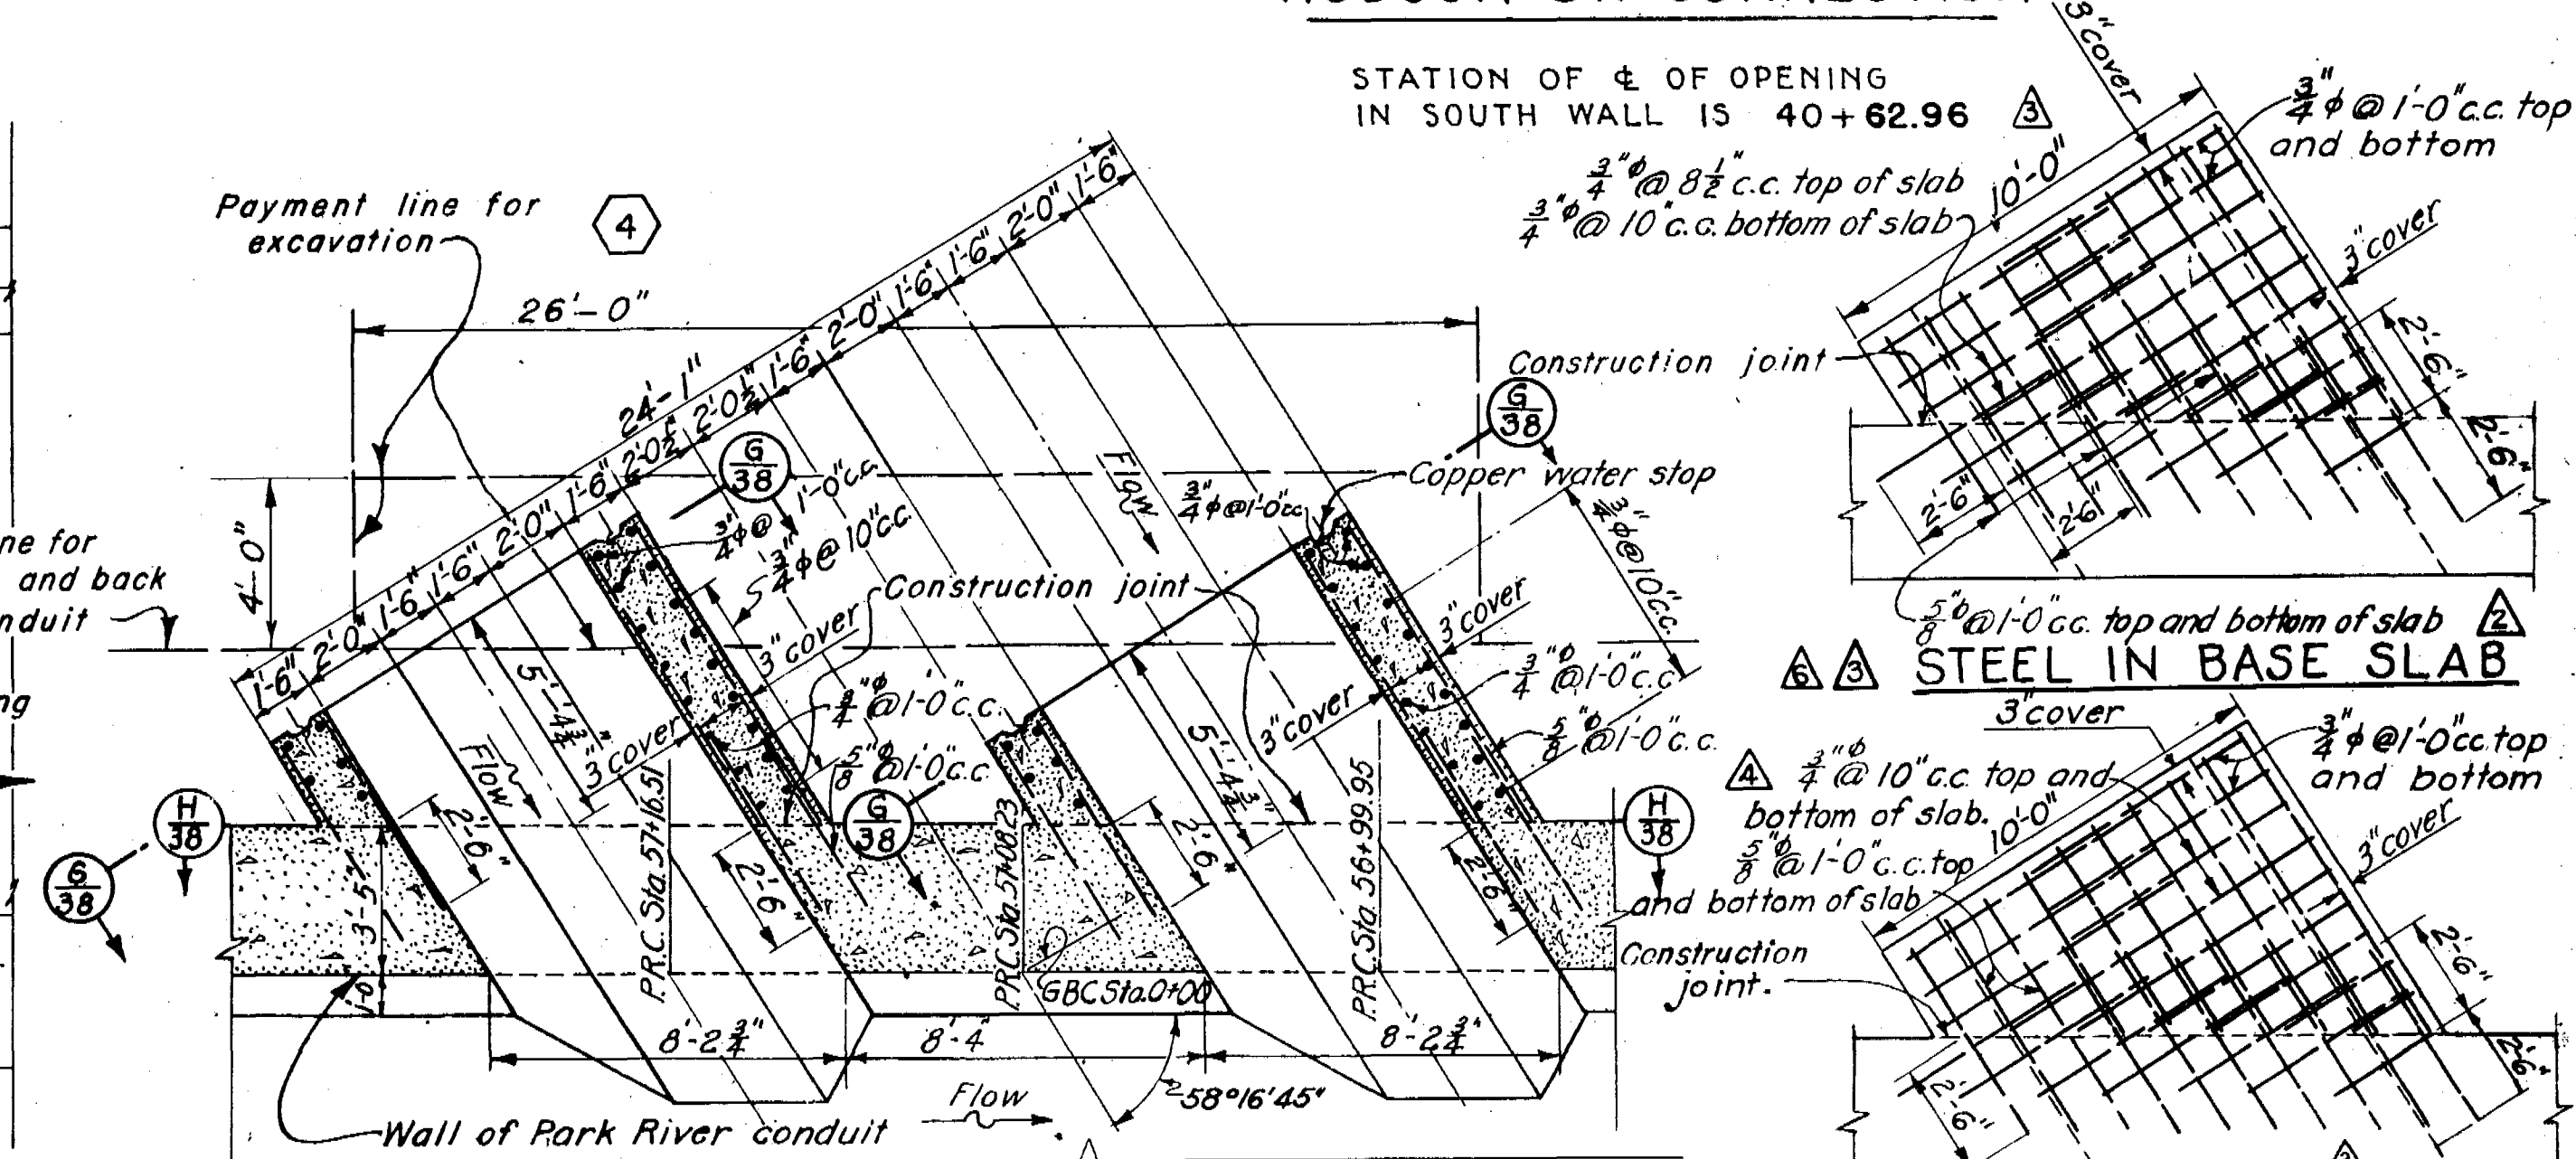

△6 △3 STEEL IN TOP SLAB

SUBMITTED: <i>Arthur L. Eddy</i> METCALF & EDDY BOSTON, MASS.	(PARTNER)	DRAWN BY: SW.O. TRACED BY: E.S.B. CHECKED BY: <i>SW.O.</i>	FILE NO. CT-4-2635
--	-----------	--	--------------------

11-17-43	Main St. sewer connection detail added.	B.S.	CMR	240
2-1-43	Pumping Sta. Force main connection removed.	E.R.C.	145	240
3-30-41	Gully Brook Connection extended 20'	E.M.R.	145	240
3-1-41	Bar spacing changed	J.C.	145	240
2-17-41	Reinforcing steel changed	J.C.	145	240
11-22-40	Gully Brook Connection	P.C.	145	240