


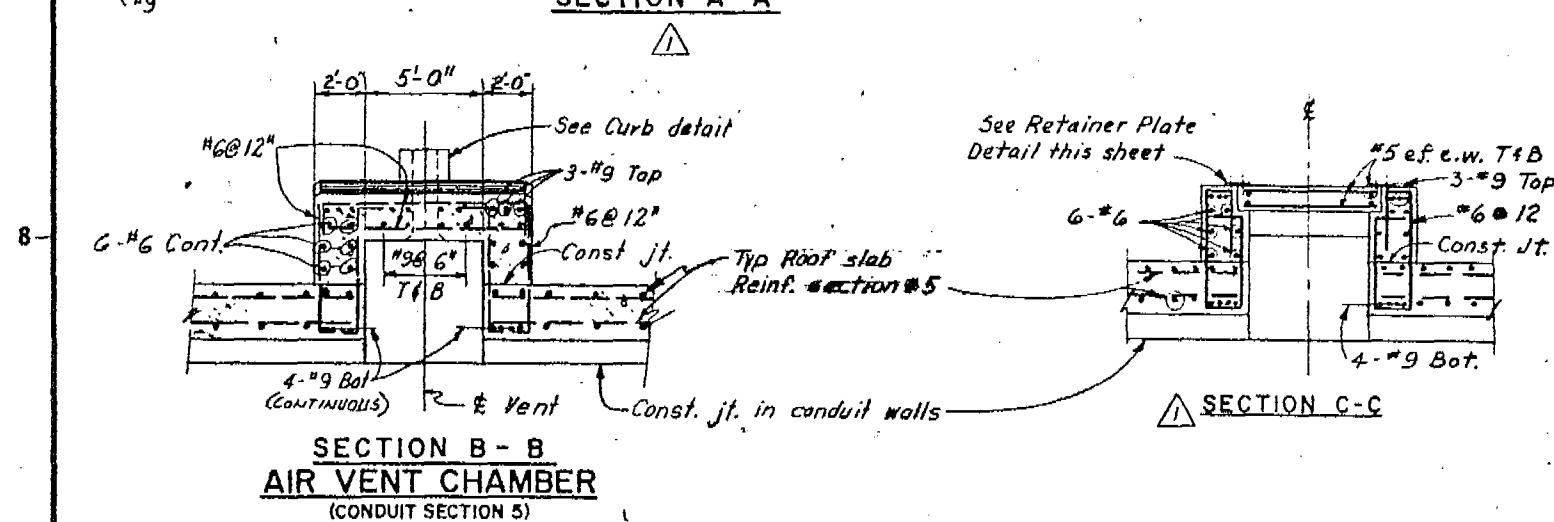
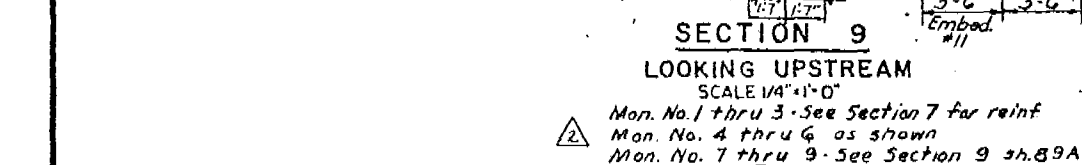
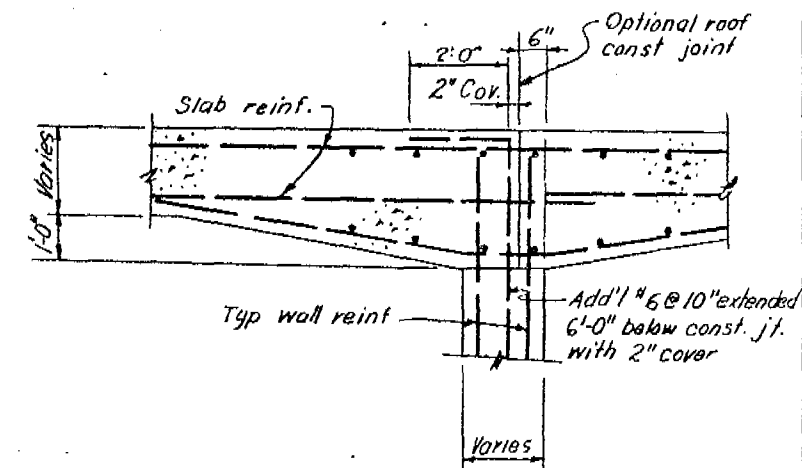
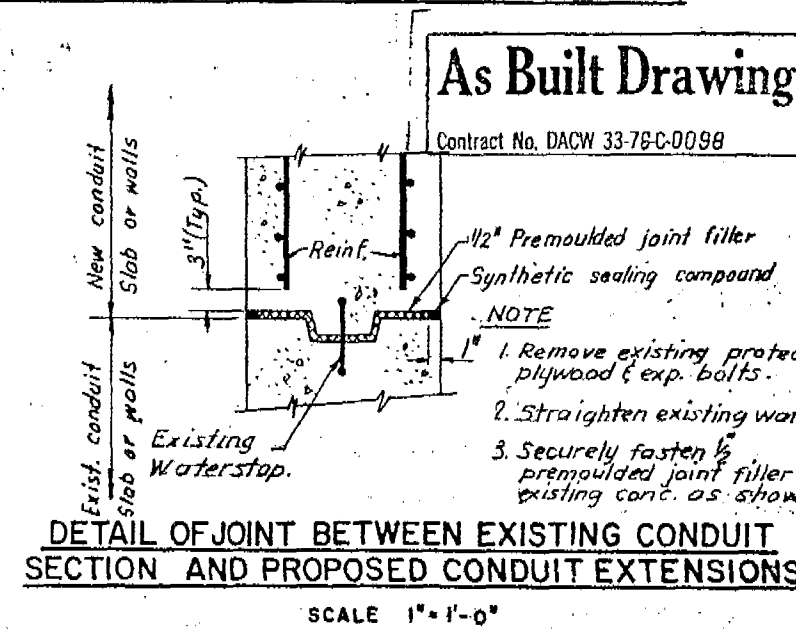


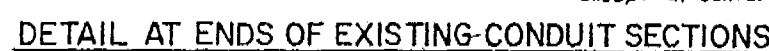


SPECIAL JOINT TREATMENT  
(Exposed wall • monoliths 27 thru 41 conduit  
section 2.)      ^

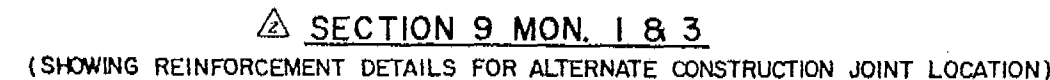


OPTIONAL ROOF CONSTRUCTION JOINT  
AT CENTER WALL  
SCALE: 1/2" = 1'-0"

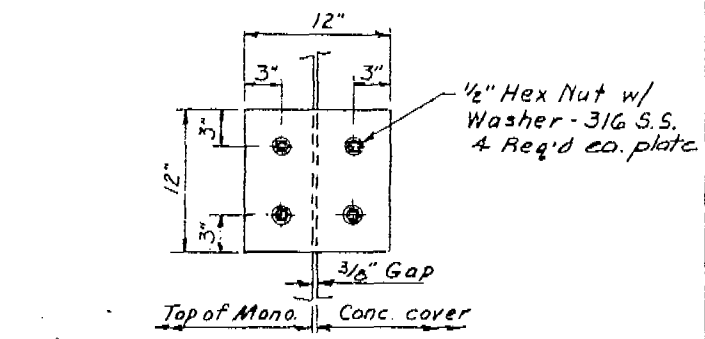


△ TOP VIEW-RETAINER PLATE

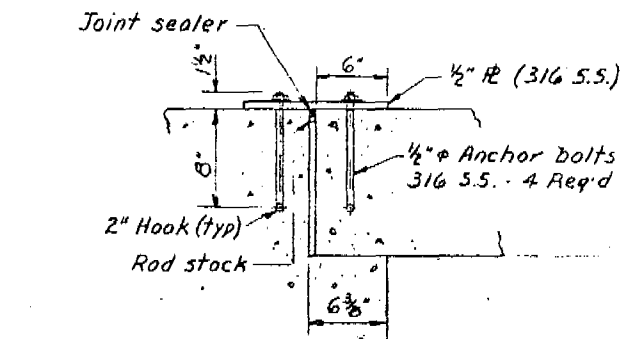


RETAINER PLATE DETAIL

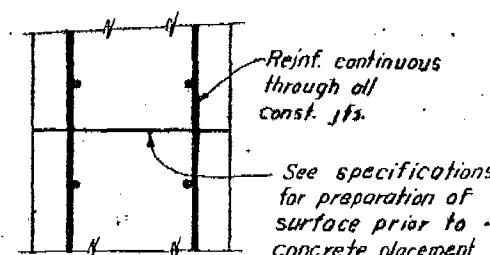

### TYPICAL CONSTRUCTION JOINT IN CONDUIT WALLS

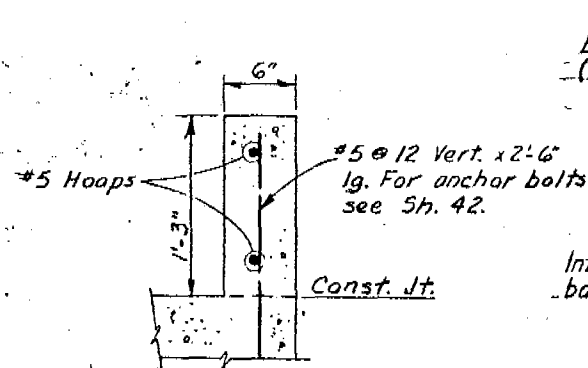

△ CURB DETAIL

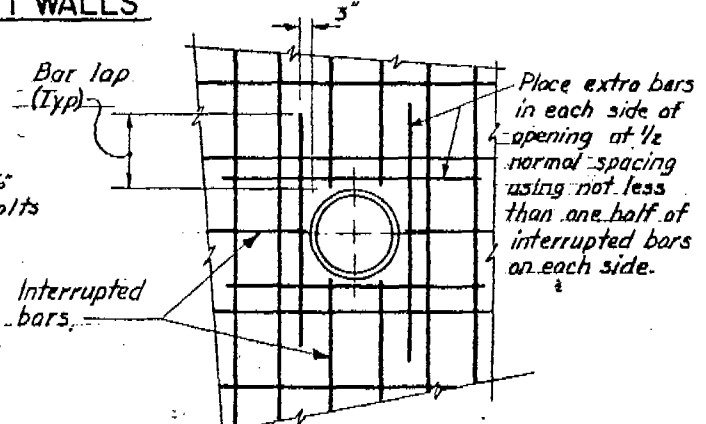

△ REINFORCING DETAILS AT ROUND OR RECTANGULAR OPENINGS LARGER THAN 6 IN.

[illegible]

VALUE  
ENGINEERING  
PAYS  
DIVIDENDS