


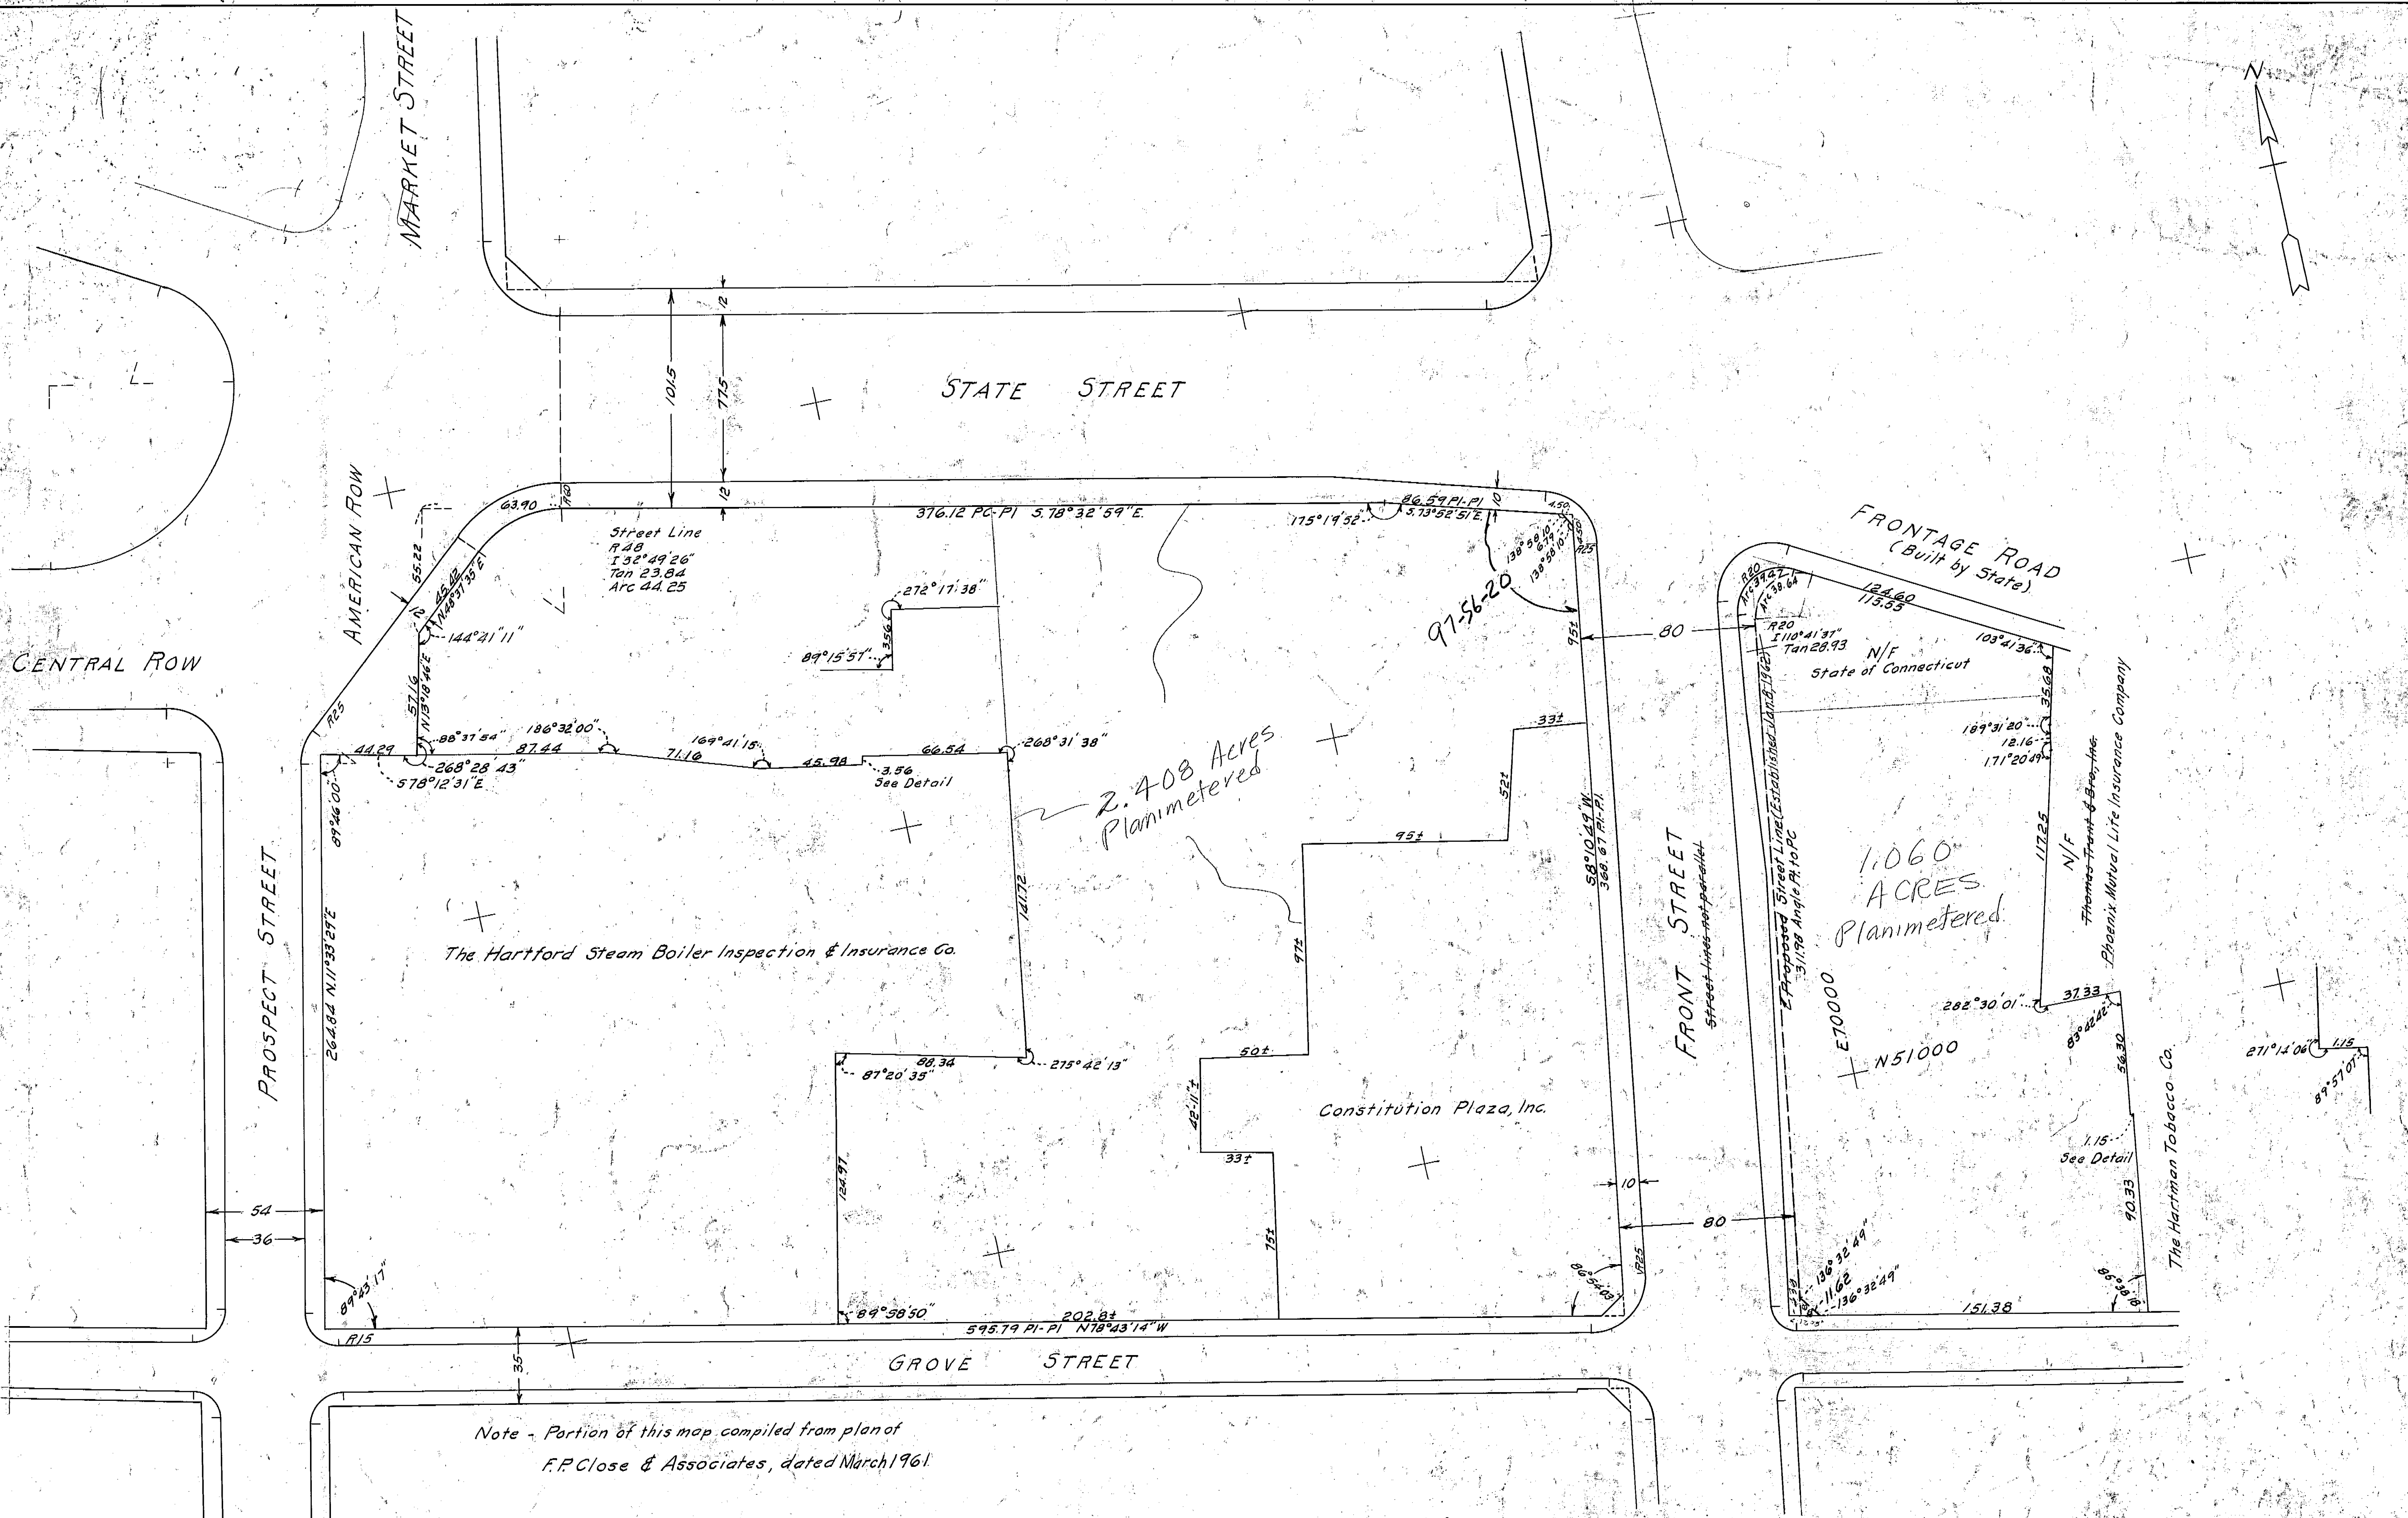

Revision of June 11, 1962 - Ownership of Trant Parcel changed to Phoenix Mutual Life Insurance Company
Curve data completed at SE corner Front St. & Frontage Road
Revision of April 3, 1961 - Bevel in street line at NE corner Front St. & Grove St. changed from 10'x10' to 8'x8'

CITY OF HARTFORD, CONNECTICUT DEPARTMENT OF ENGINEERING		
DISPOSITION MAP EXTENSION OF FRONT MARKET AREA		
ICR-2		
SUBMITTED <i>[Signature]</i> DIVISION ENGINEER	RECOMMENDED <i>[Signature]</i> ASSISTANT CITY ENGINEER	APPROVED <i>[Signature]</i> CITY ENGINEER
DESIGN <i>[Signature]</i>	DRAWN <i>[Signature]</i>	DAYBOOK NO. 09858 SCALE 1"=40' DATE MARCH 1961
TRACED <i>[Signature]</i>	CHECK <i>[Signature]</i>	