


For Continuation of East
Floodwall See Sht. 91

1'-7" 7'-0" 7'-0" 7'-0" 7'-0" 7'-0" 7'-0" 2'-0"

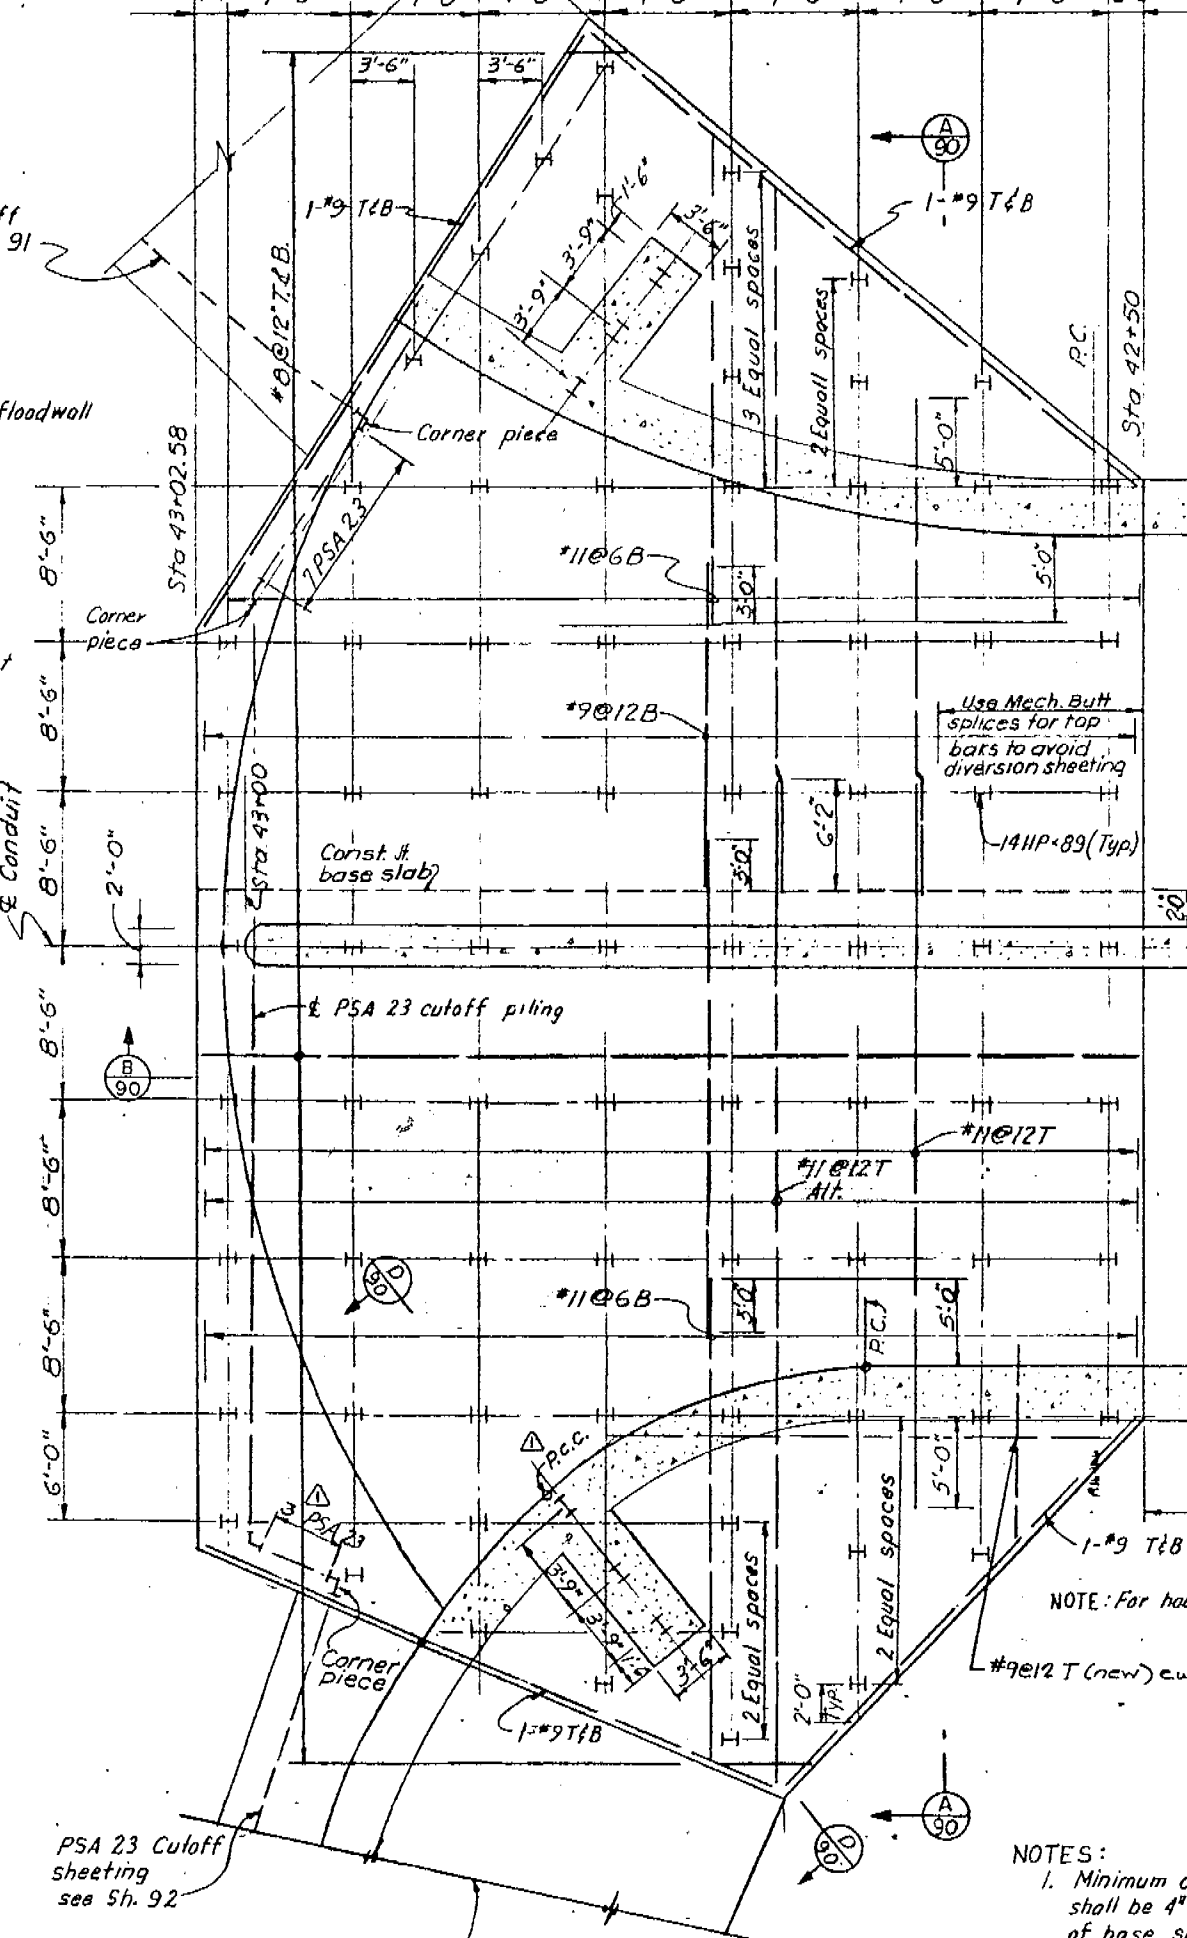

△ PILE AND FOUNDATION PLAN
SCALE 3/16" = 1'-0"

NOTES:

1. Minimum cover to steel reinforcement shall be 4" at all surfaces except bottom of base slab which shall have 7 1/2" cover.
2. For length of reinforcement laps not shown see table of Lap Splices sheet No. 48.
3. Mechanical butt splices to be staggered Min. of 2'-0"

For Continuation of West
Flood Wall See Sheet 92PSA 23 Cutoff
sheeting
see Sh. 92PSA 23 Cutoff
piling see Sh. 91

Base line east floodwall

Base line west
floodwallRadius Point
for Arch &
WeirR=59.279' to
base of weir at
El. 20.22

R=50'-7 1/4"

R=47'-1 1/2"













