

BLUE HILLS AVE.


Macadam Pavement.

DESCRIPTION OF DUCT SECTION

Corrected to
2-16-18


- REPRESENTS DISTRIBUTION DUCT.
- CITY PERM.
- SOLD
- WESTERN UNION
- POSTAL TELG.
- S. N. E. T. CO.
- A. T. & T. CO.

Laterals					
No.	Orig. Pave.	Sub. Surf.	Date	Remarks	
1	M	33 E	1917		
2	"	9 "	"		
3	"	161 "	"		
4	"	9 "	"		
5	"	33 "	"		
6	"	9 "	"		
7	"	118 "	"		
8	"	145 "	"		

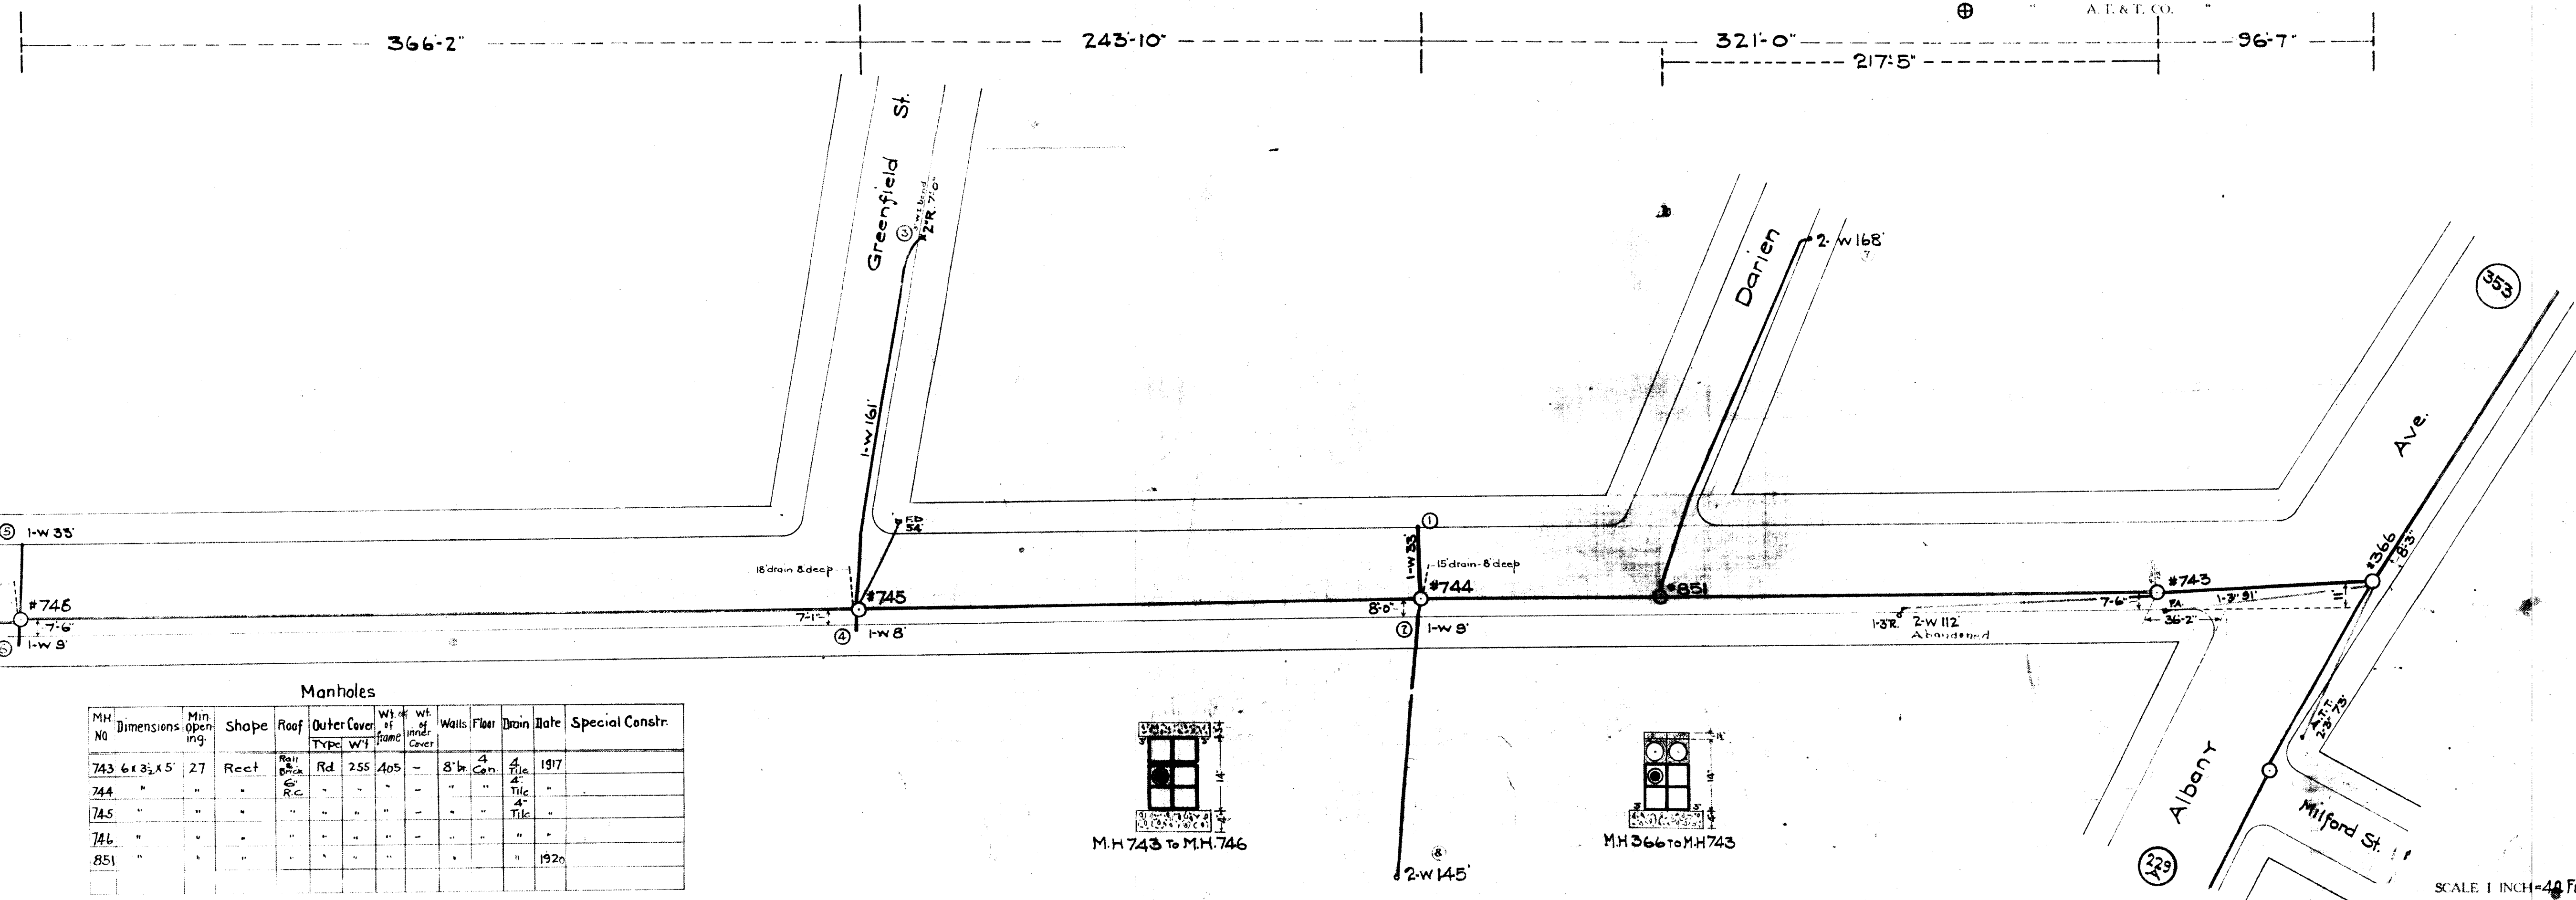


Manholes

M.H. No.	Dimensions	Min. opening	Shape	Roof	Outer Cover	Wt. of frame	Wt. of inner cover	Walls	Floor	Drain	Date	Special Constr.
743	6 x 3 1/2 x 5'	27	Rect.	Roll Brk G. R.C.	Rd. 255	405	-	8" br	4" tile	4" tile	1917	
744	"	"	"	"	"	"	"	"	"	"	"	
745	"	"	"	"	"	"	"	"	"	"	"	
746	"	"	"	"	"	"	"	"	"	"	"	
851	"	"	"	"	"	"	"	"	"	"	1920	

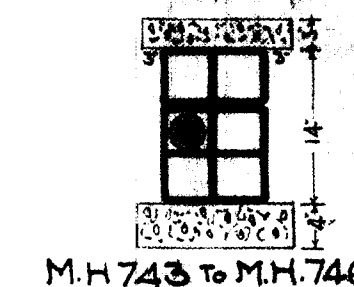

M.H. 743 to M.H. 746

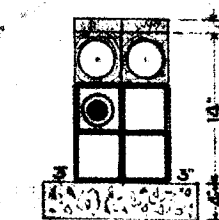

M.H. 366 to M.H. 743

SCALE 1 INCH = 40 FEET