


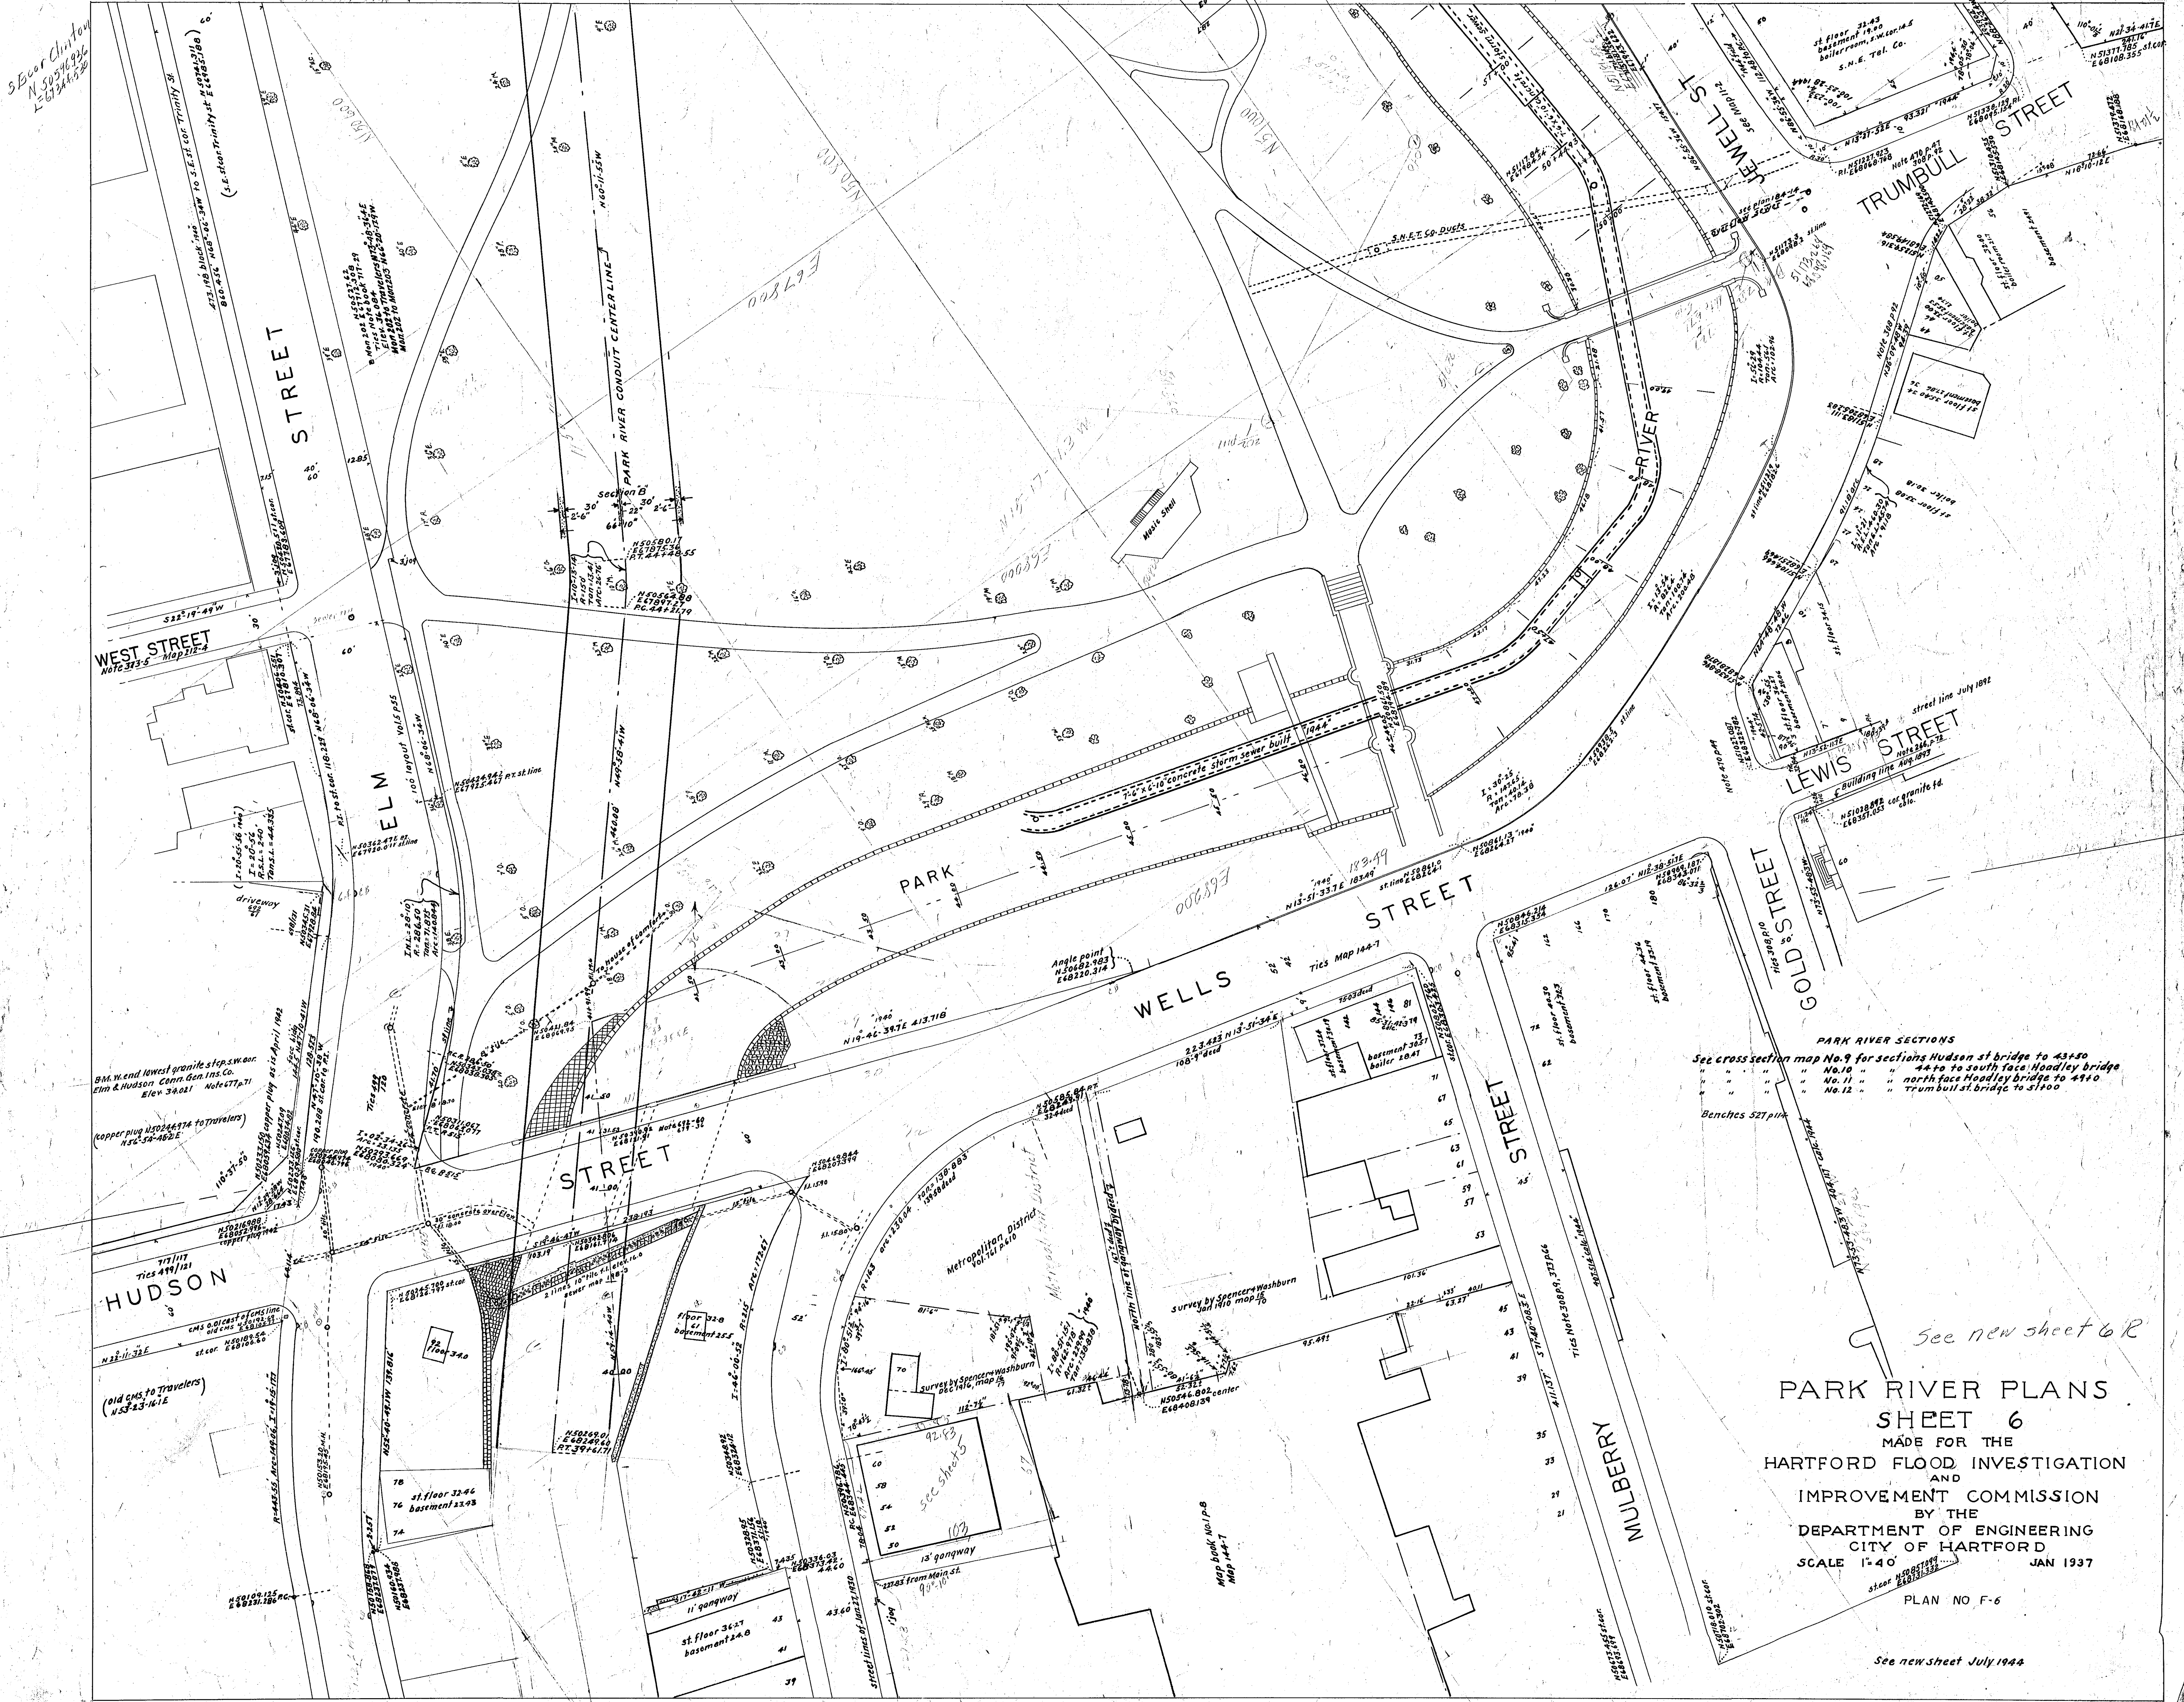

PARK RIVER SECTIONS
See cross section map No. 9 for sections Hudson st bridge to 43+50
" " " " " 44+10 to south face Hoodley bridge
" " " " " 44+11 " " north face Hoodley bridge to 49+0
" " " " " 49+0 to Trumbull st bridge to 51+00
Benches 527 p.m.

See new sheet 6 R

PARK RIVER PLANS
SHEET 6
MADE FOR THE
HARTFORD FLOOD INVESTIGATION
AND
IMPROVEMENT COMMISSION
BY THE
DEPARTMENT OF ENGINEERING
CITY OF HARTFORD
SCALE 1"=40' JAN 1937
PLAN NO F-6

See new sheet July 1944

Print of 2/7/40