
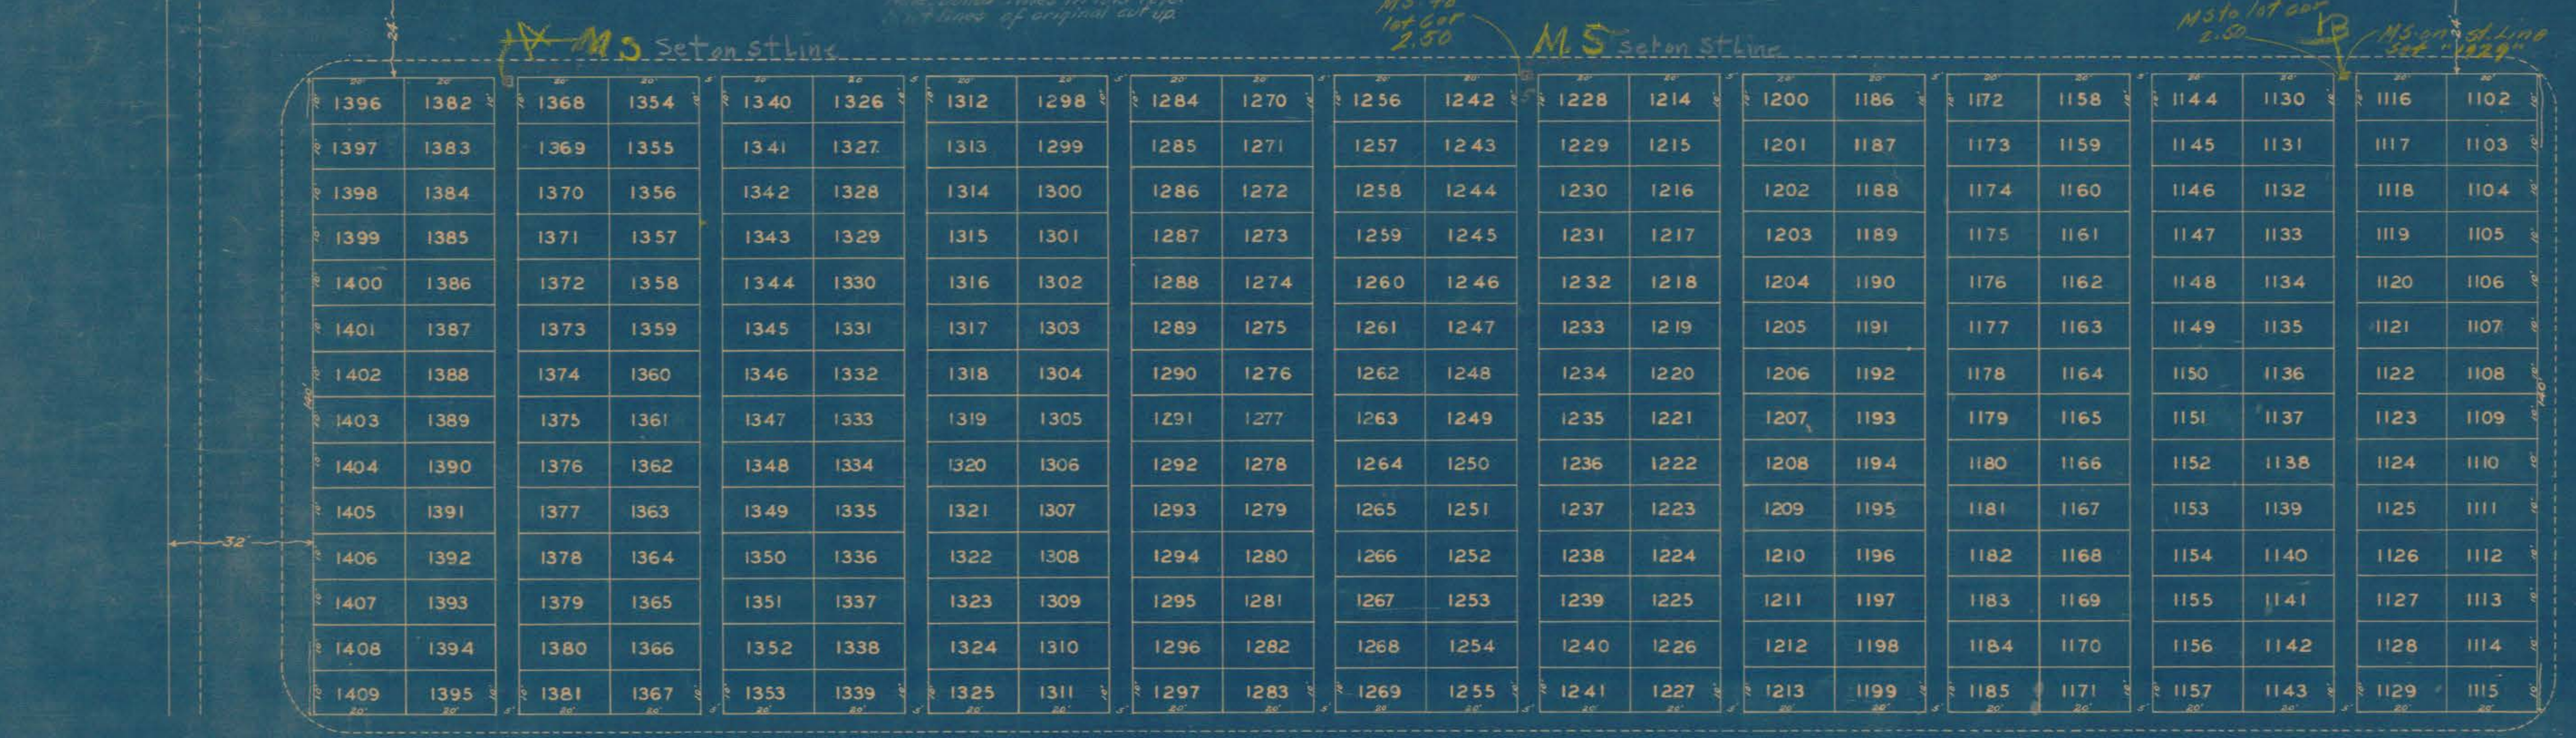
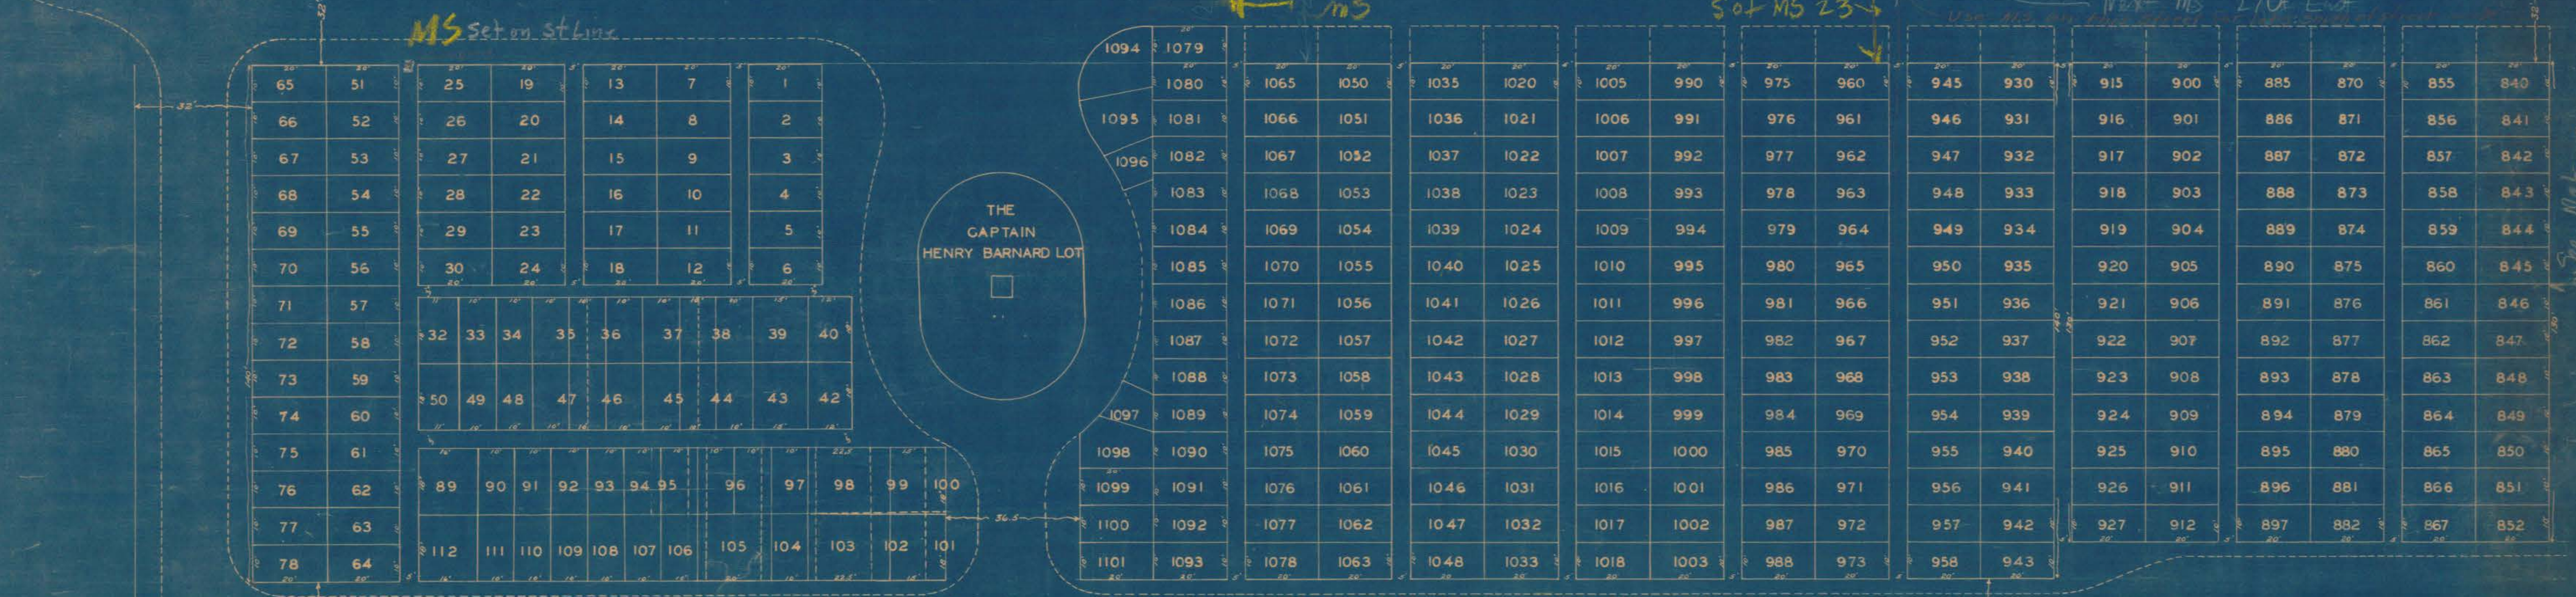


R.E. CURTIS - 25910
T = 252.16
ARC = 209.47

R.E. SILLING - 245540
T = 143.74
ARC = 207.15

STREET

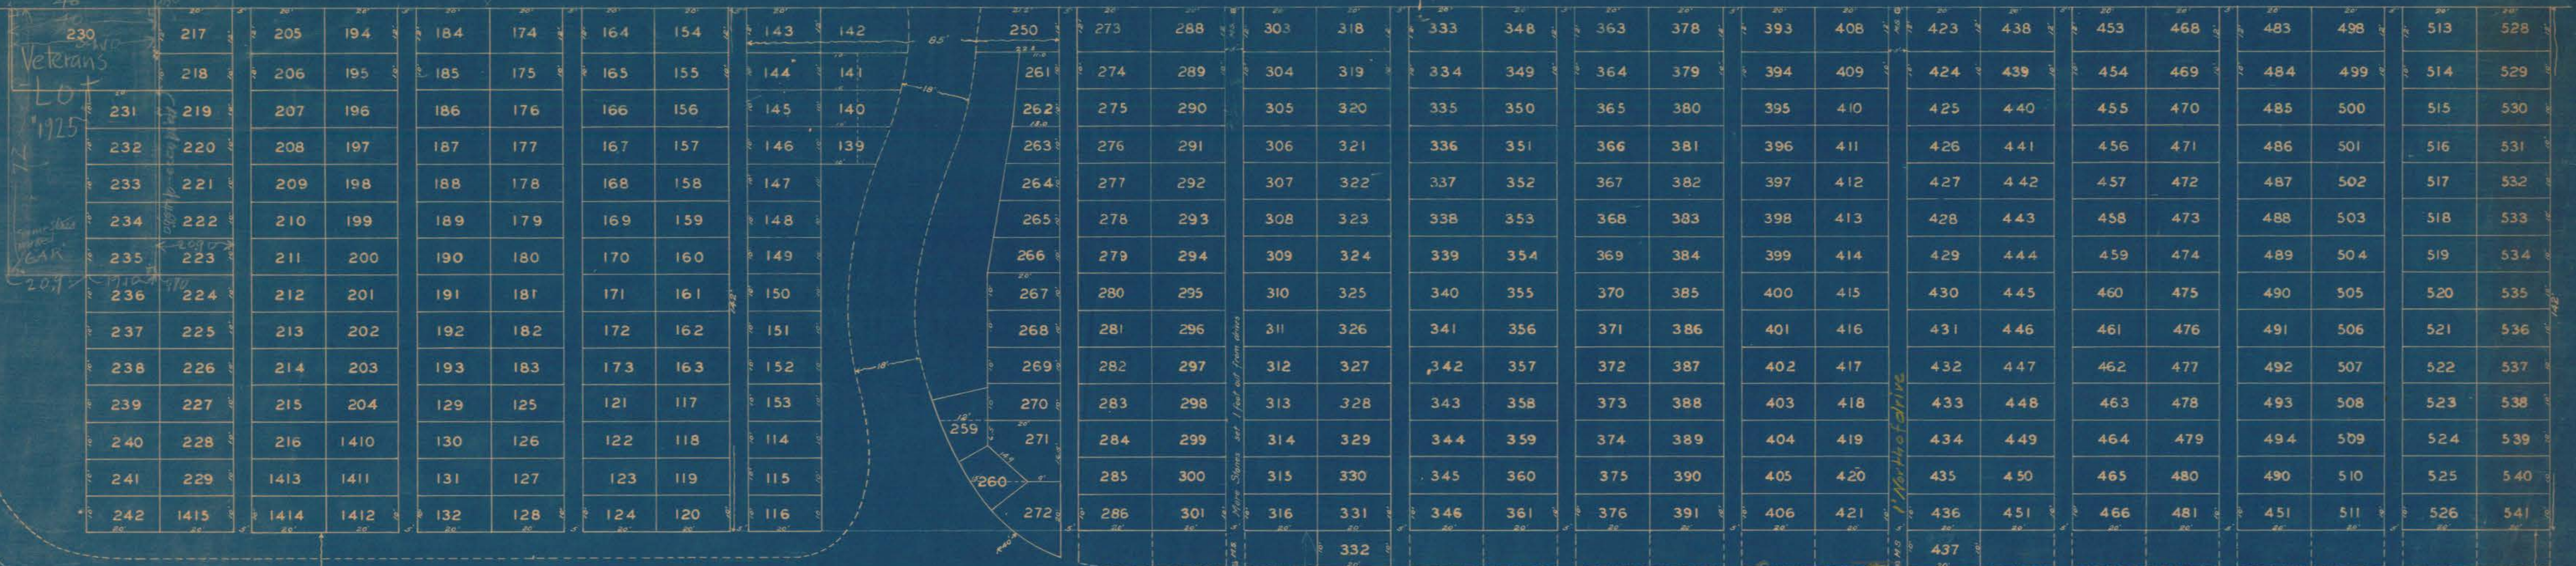

ZION HILL CEMETERY
REVISED PLAN
OF
SOUTH WESTERN SECTION
SCALE 1"=20' DEC. 1924.