


PARK RIVER PLANS
SHEET 10
MADE FOR THE
HARTFORD FLOOD INVESTIGATION
AND
IMPROVEMENT COMMISSION
BY THE
DEPARTMENT OF ENGINEERING
CITY OF HARTFORD
SCALE 1"=40' AUG 1938.
PLAN No F-10

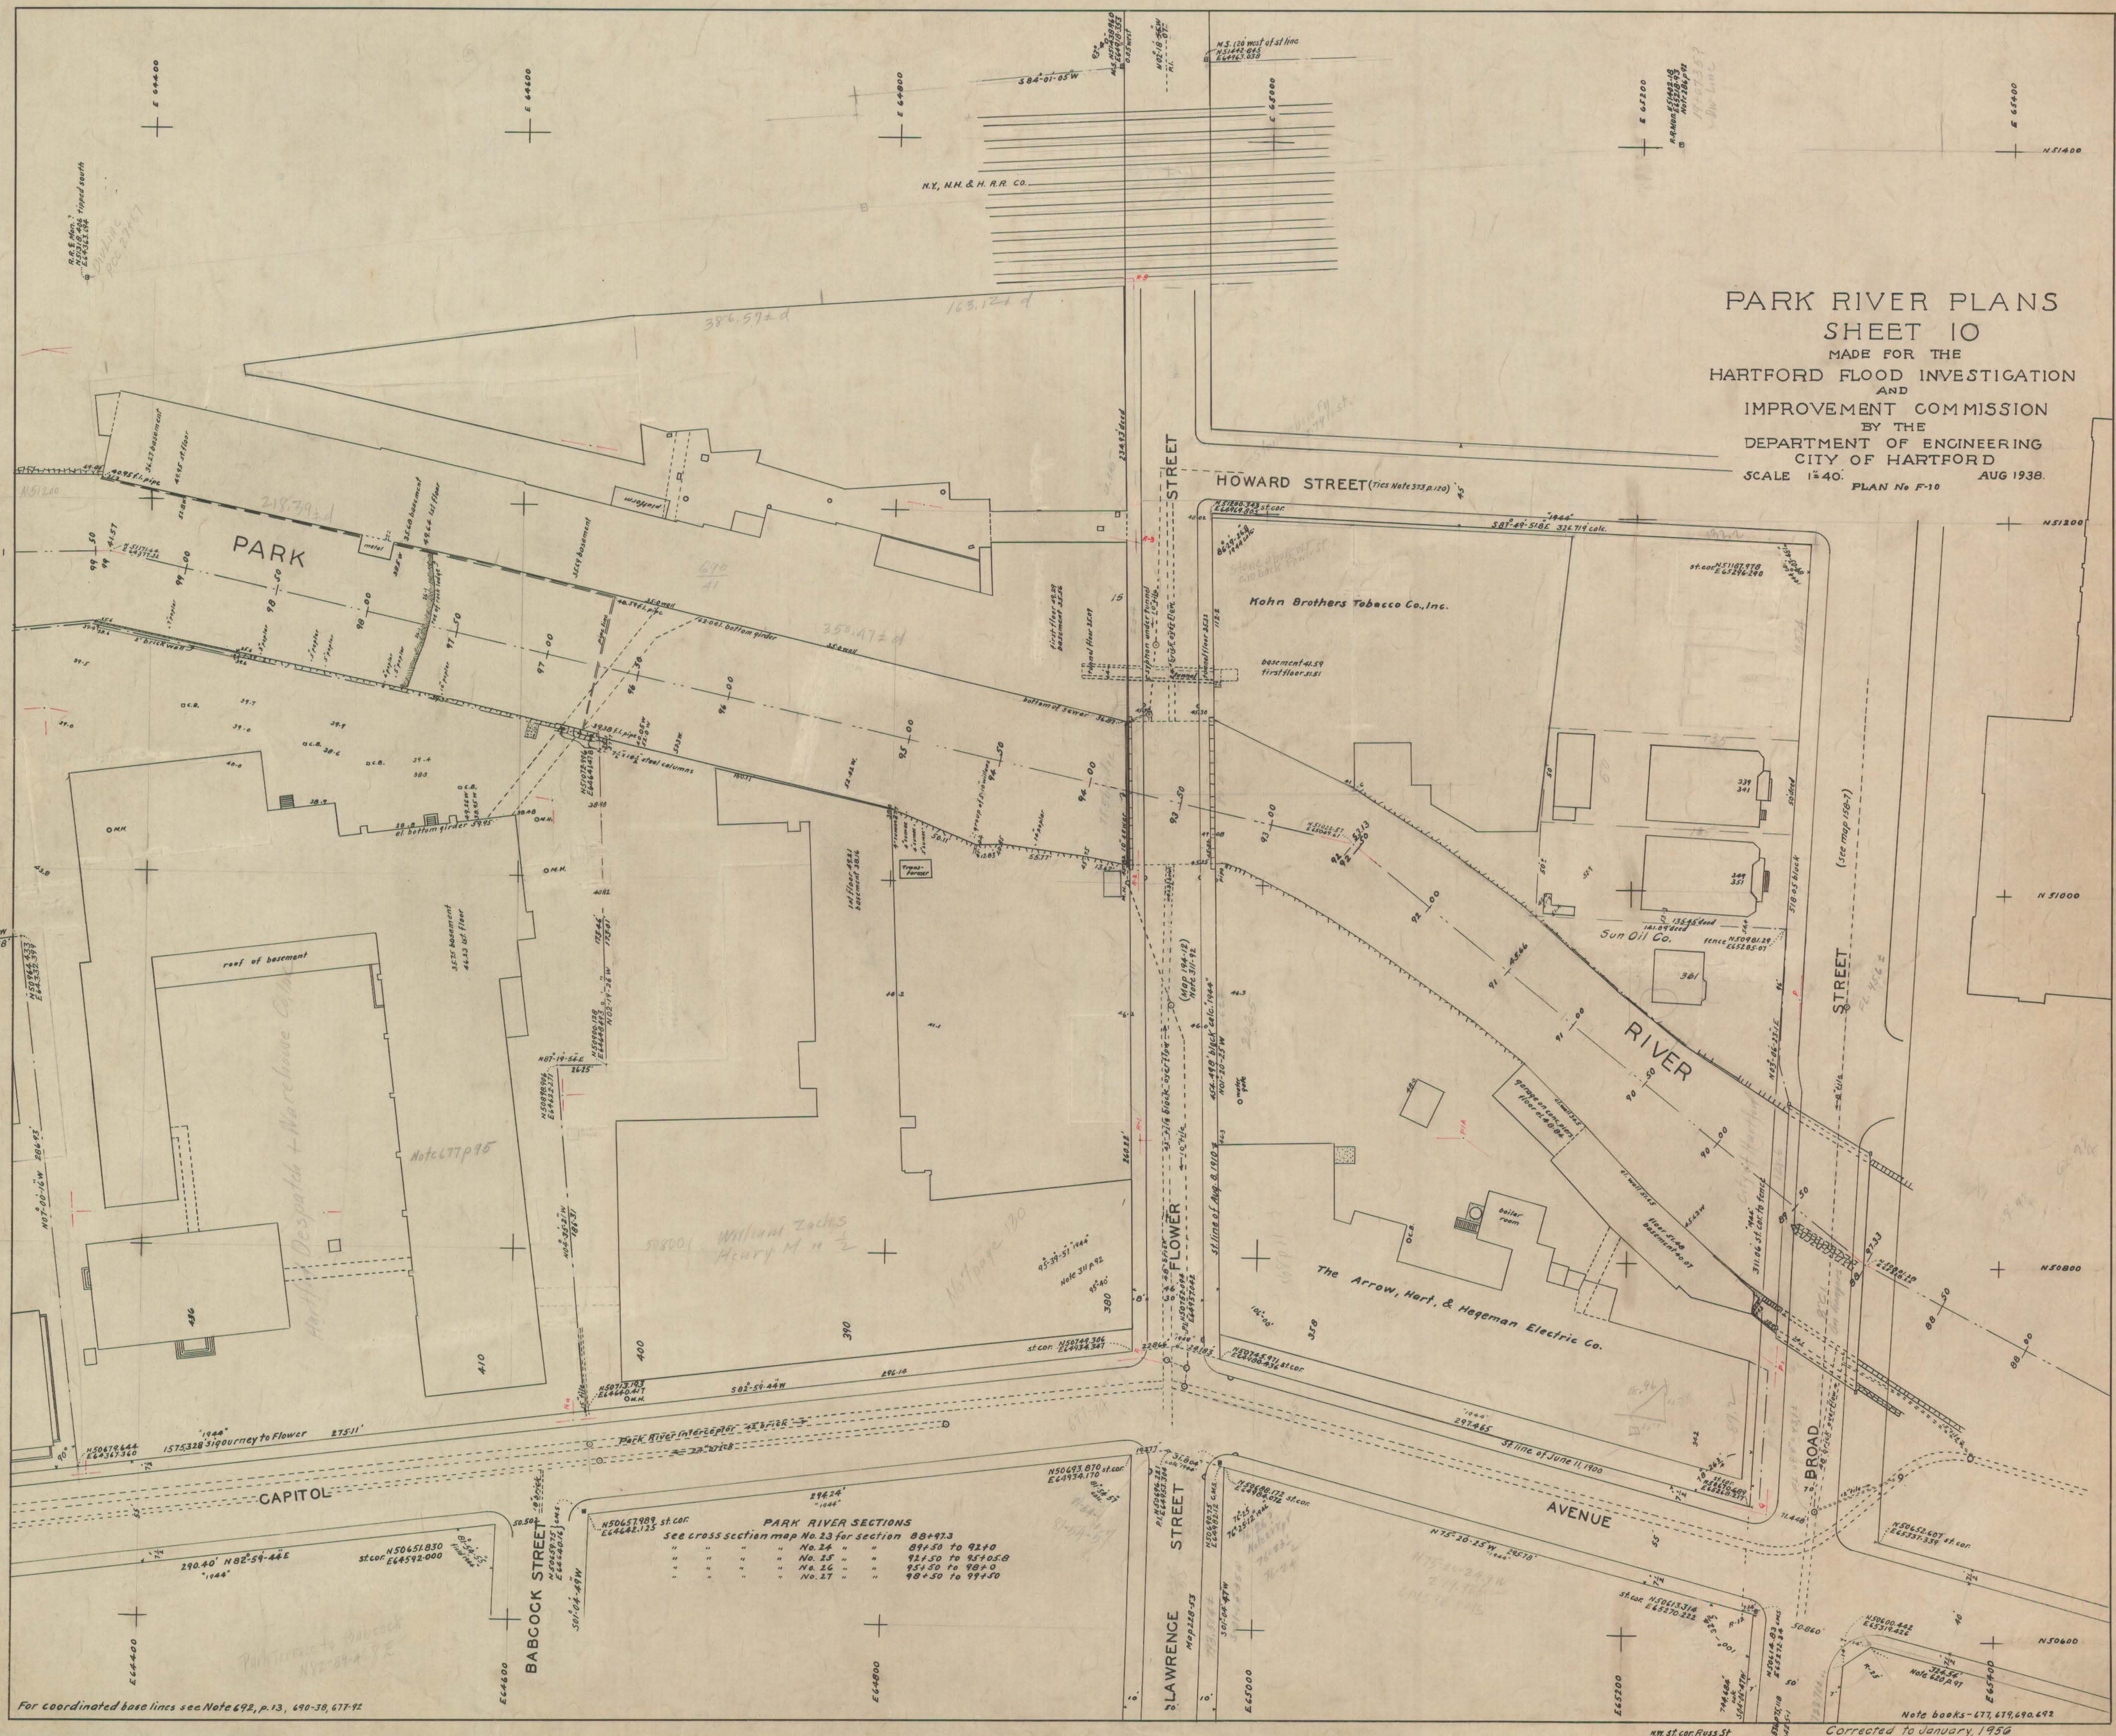

PARK RIVER SECTIONS
see cross section map No. 23 for section 88+97.3

"	"	"	No. 24	"	89+50 to 92+0
"	"	"	No. 25	"	92+50 to 95+05.0
"	"	"	No. 26	"	95+50 to 98+0
"	"	"	No. 27	"	98+50 to 99+50

For coordinated base lines see Note 692, p. 13, 690-38, 677-92

Corrected to January, 1950