


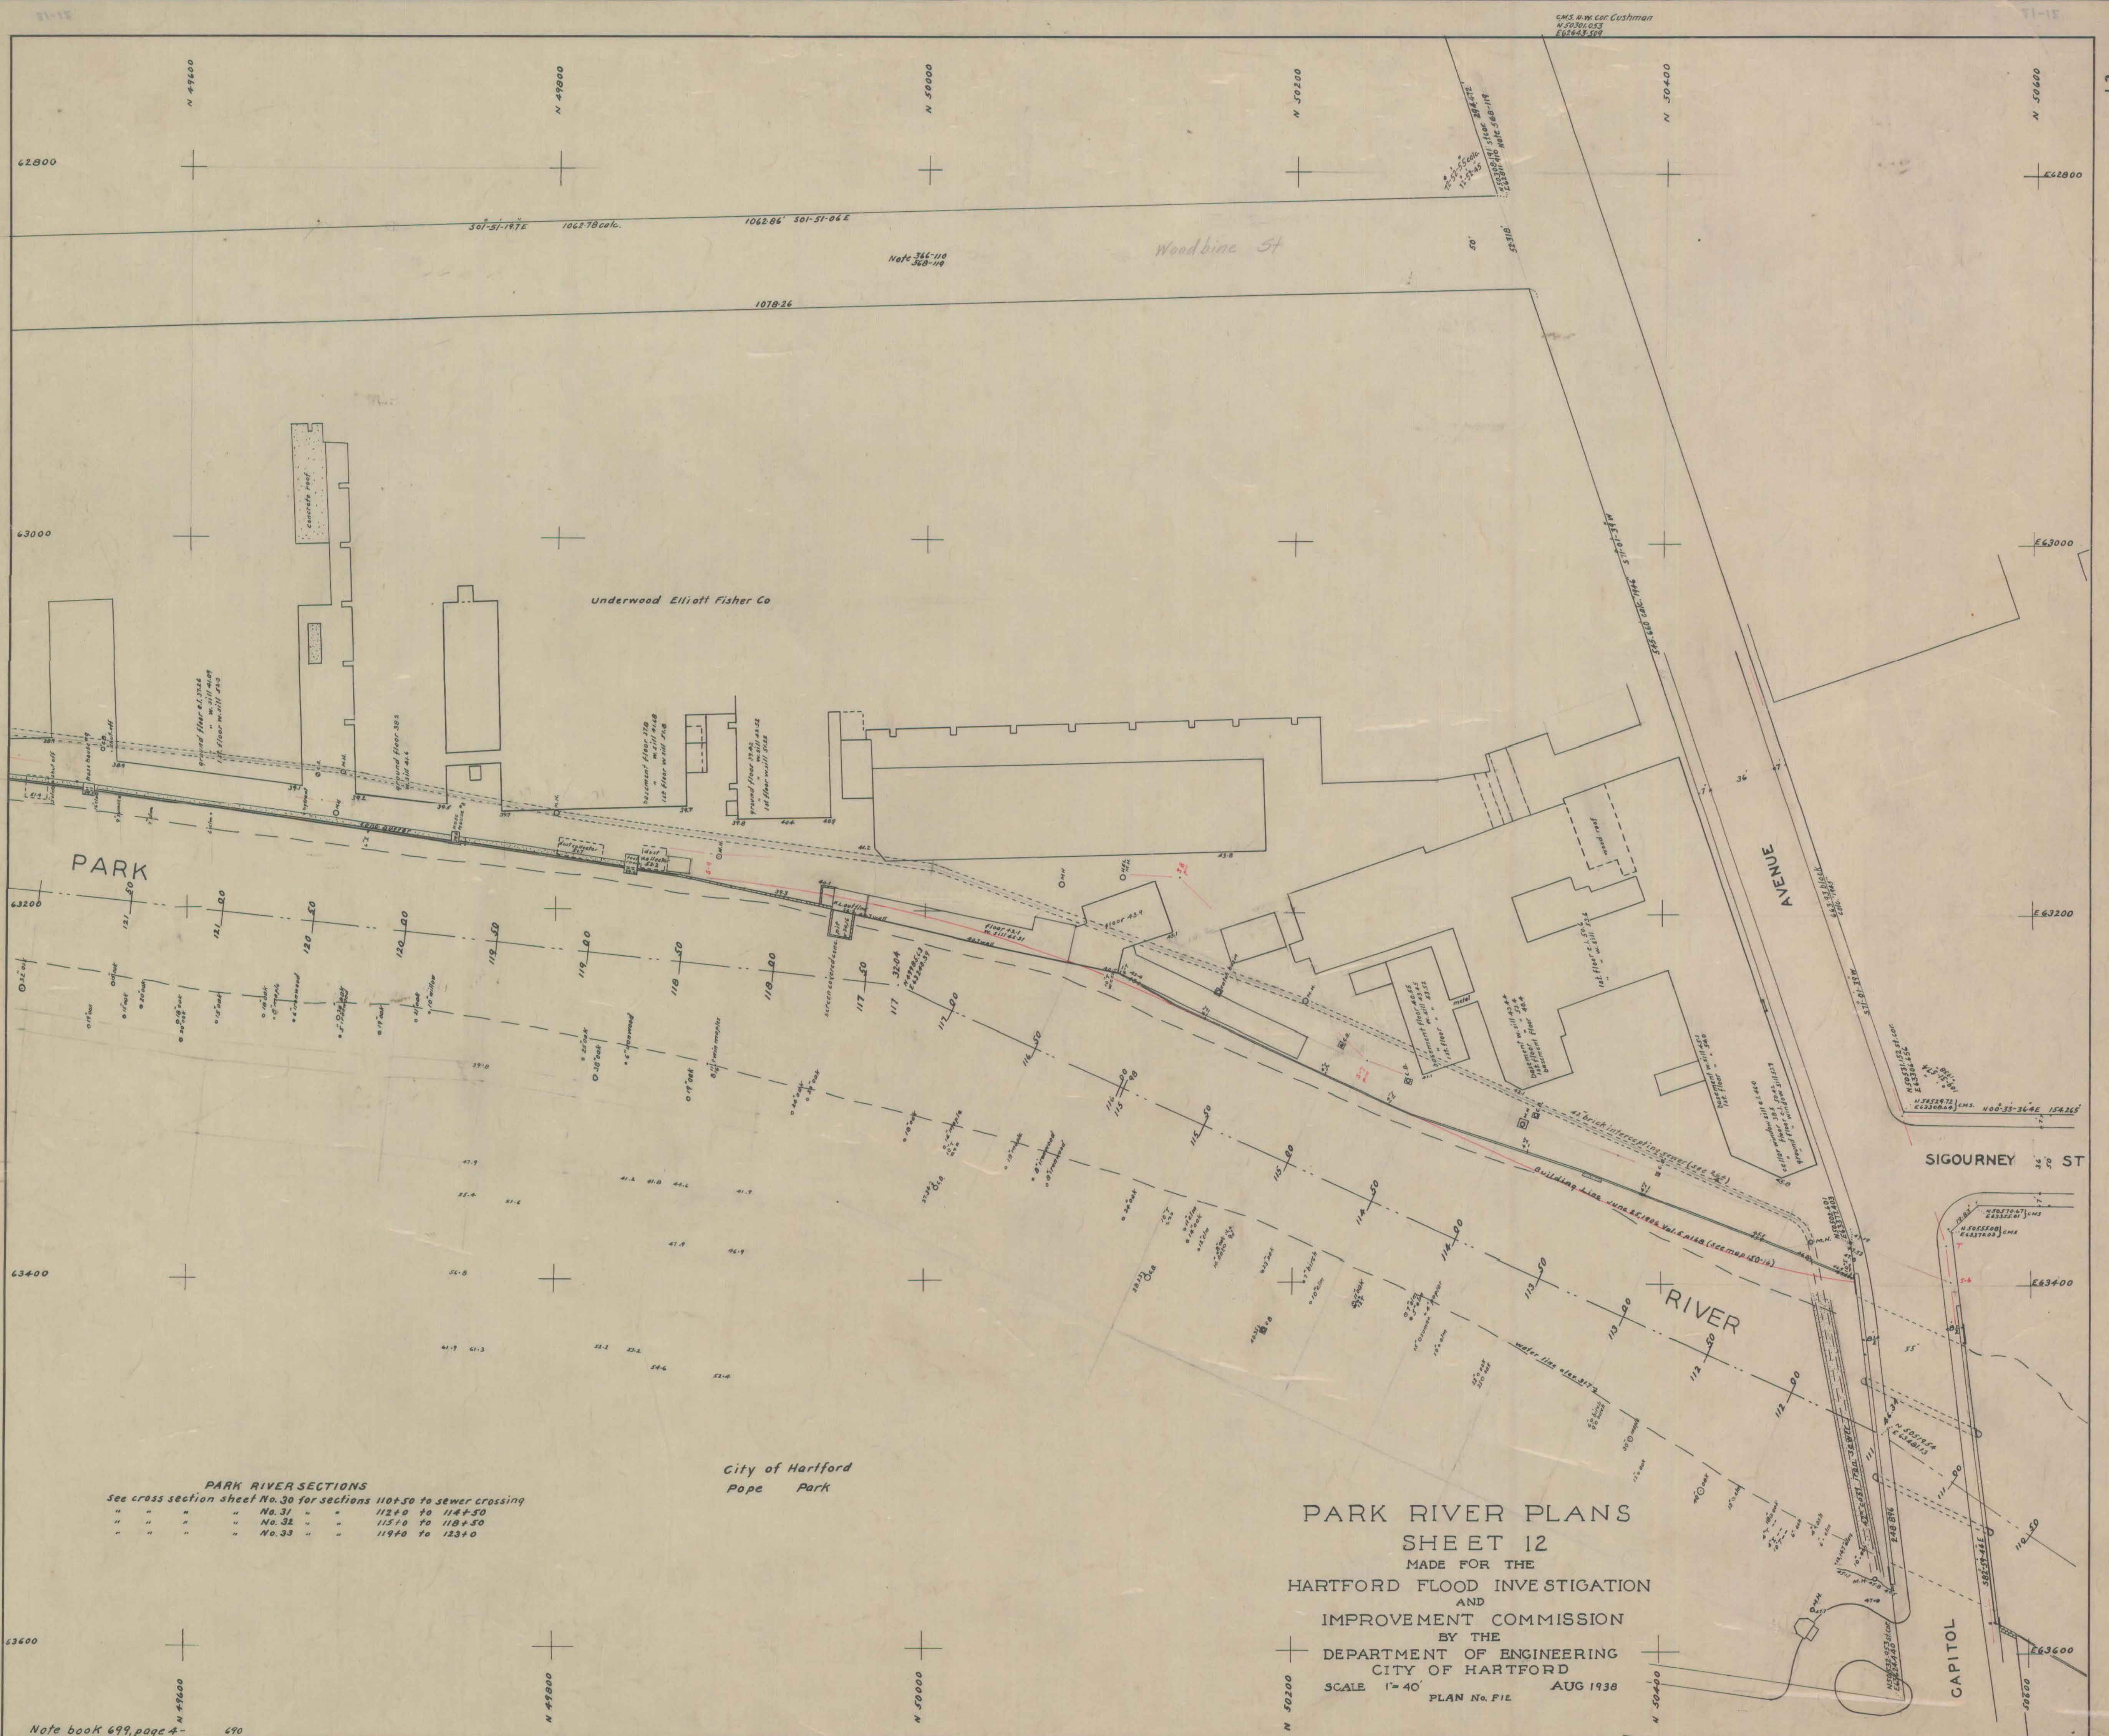

PARK RIVER SECTIONS  
See cross section sheet No. 30 for sections 110+50 to sewer crossing  
" " " " No. 31 " " 112+0 to 114+50  
" " " " No. 32 " " 115+0 to 118+50  
" " " " No. 33 " " 119+0 to 123+0

City of Hartford  
Pope Park

PARK RIVER PLANS  
SHEET 12  
MADE FOR THE  
HARTFORD FLOOD INVESTIGATION  
AND  
IMPROVEMENT COMMISSION  
BY THE  
DEPARTMENT OF ENGINEERING  
CITY OF HARTFORD  
SCALE 1"=40' AUG 1938  
PLAN No. F12

Corrected to January, 1956